

AS-BUILT NOV. 1998


Paula Stealy 6/30/99
Athens County Engineer

Jim Hill 7-1-99
Code Enforcement / Zoning Inspector

Charles A. Danner R.S. 7/1/99
Athens County Sanitarian

David S. Gault
7/22/99


19990006338
Filed for Record in
ATHENS COUNTY, OHIO
JULIA MICHAEL SCOTT
On 07-27-1999 At 01:19 pm.
PLAT 43.20 ENV 497 A

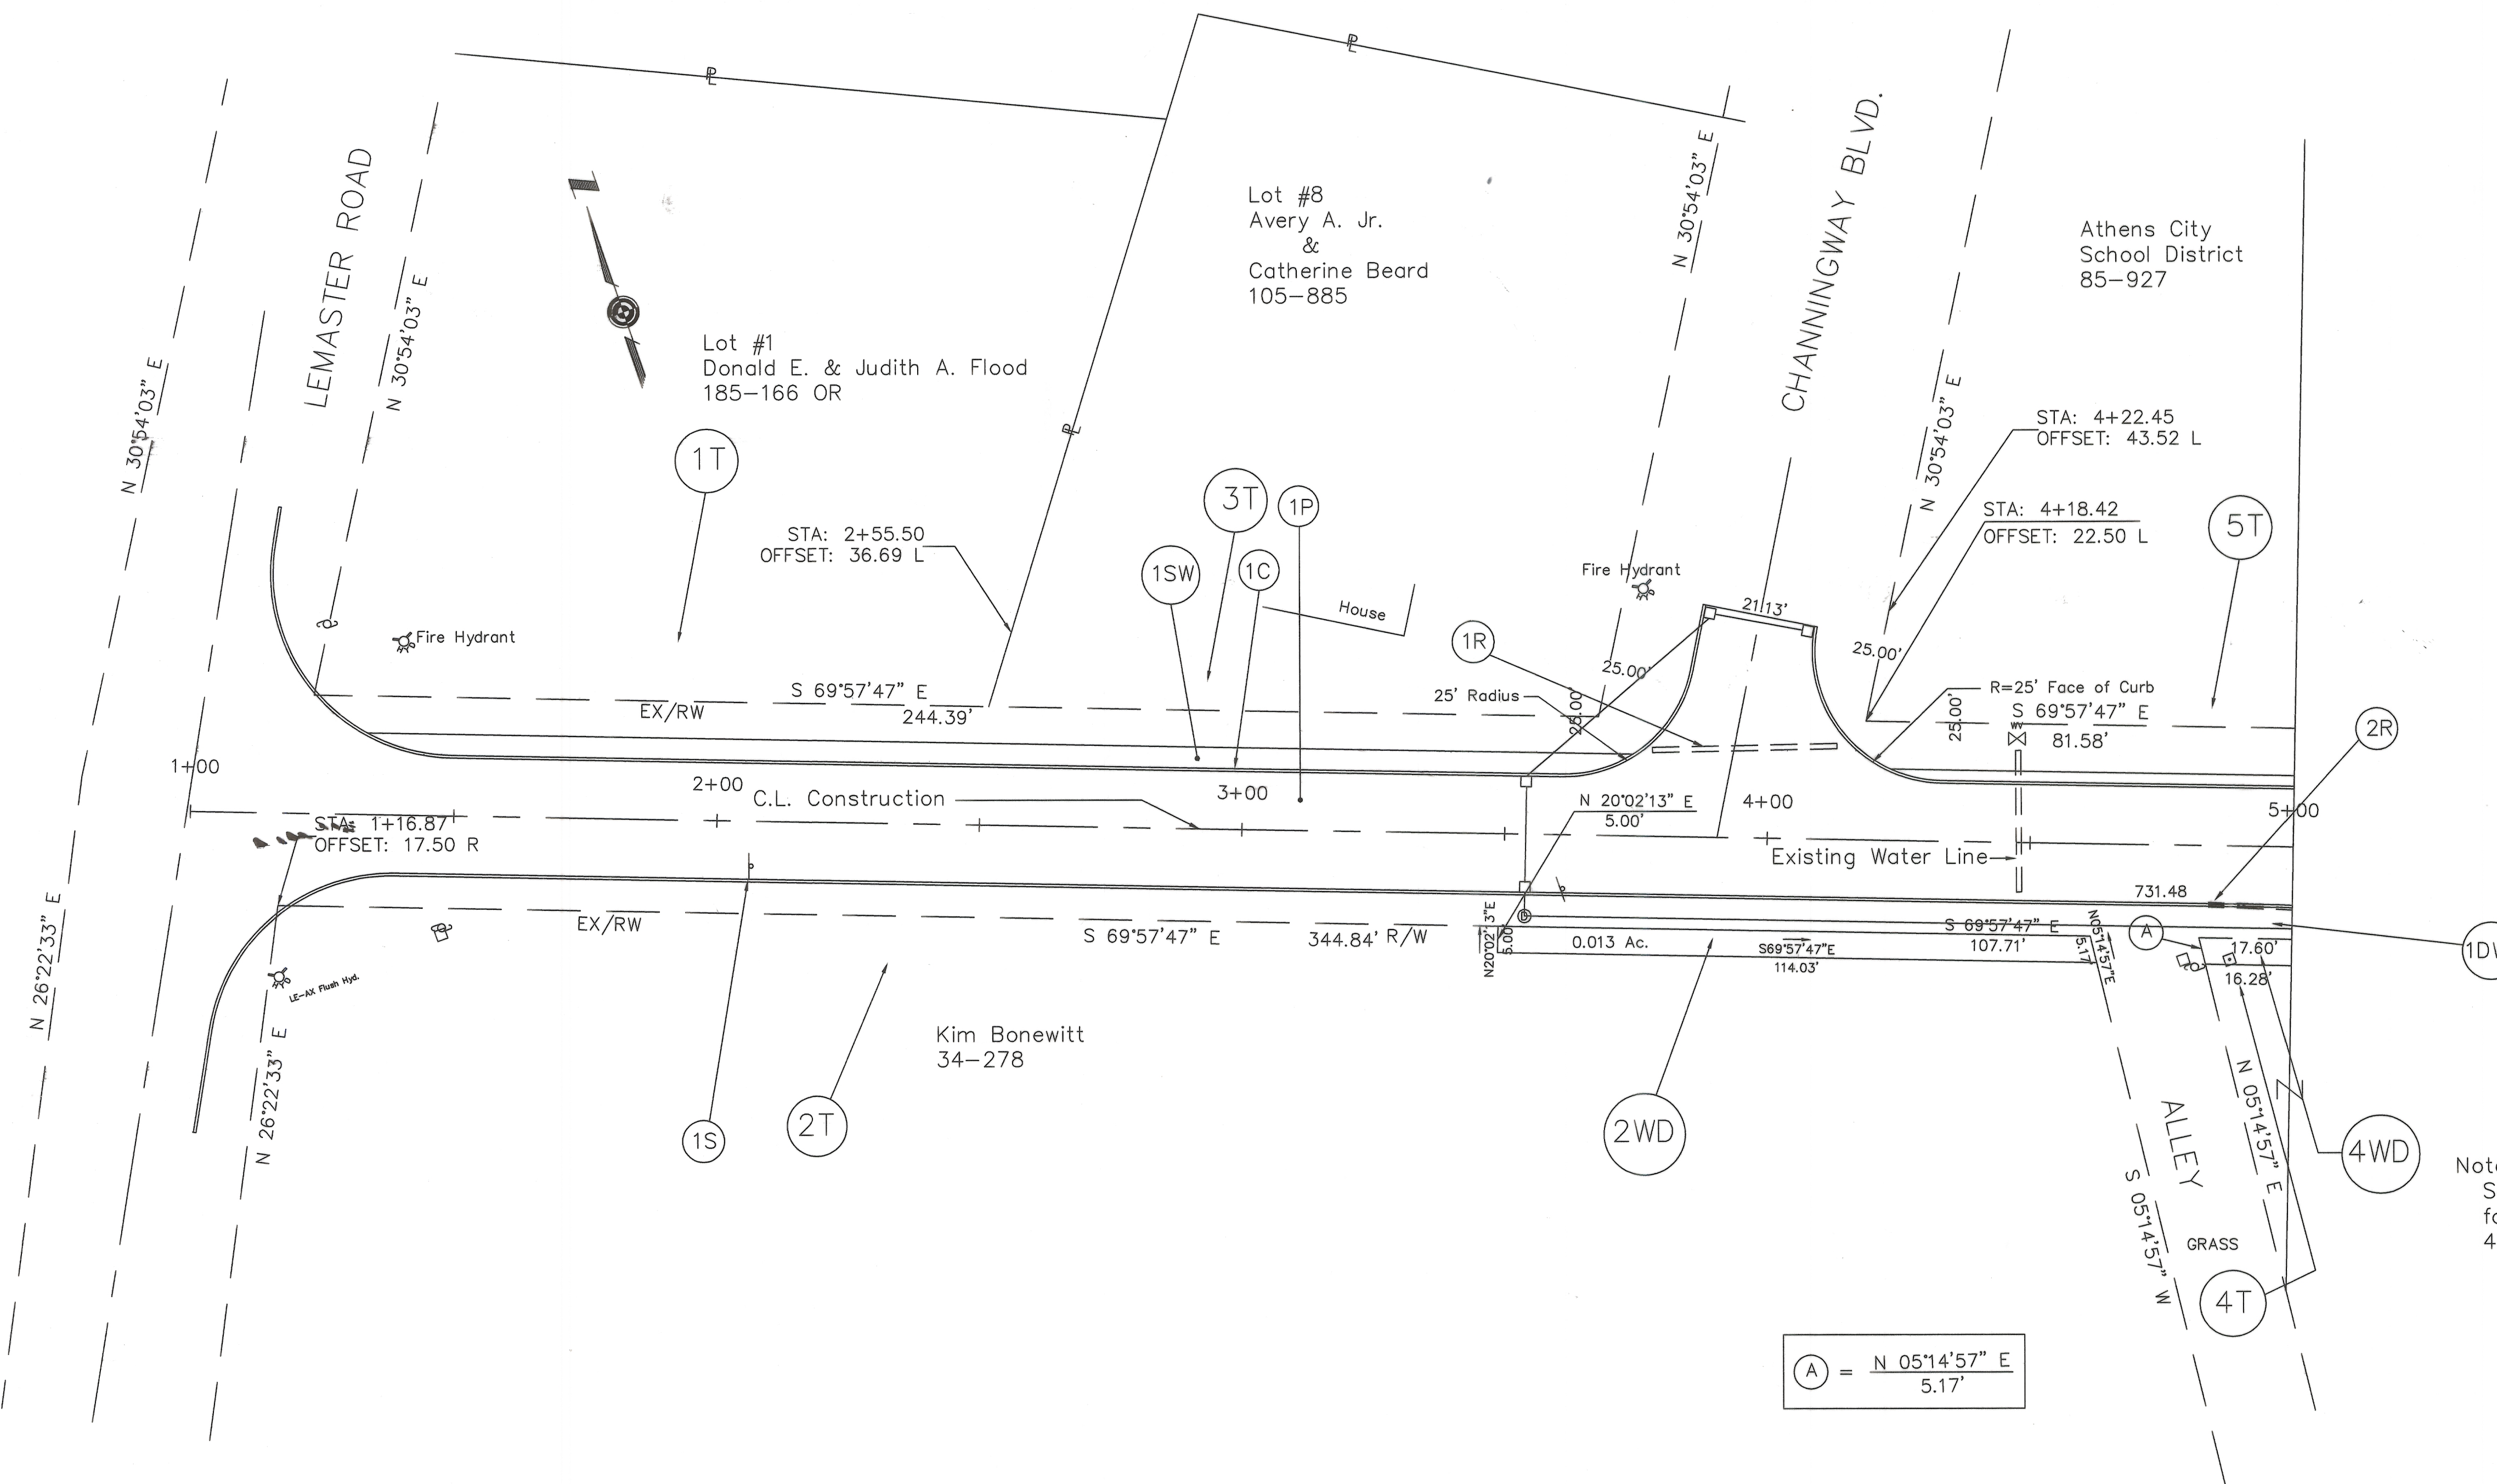


Note:
See Page 6 of 34
for Continuation of
4WD.

(A) = N 05'14'57" E
5.17'

PVI STA = 3+50
PVI ELEV = 733.98
A.D. = -1.52
K = 263.16

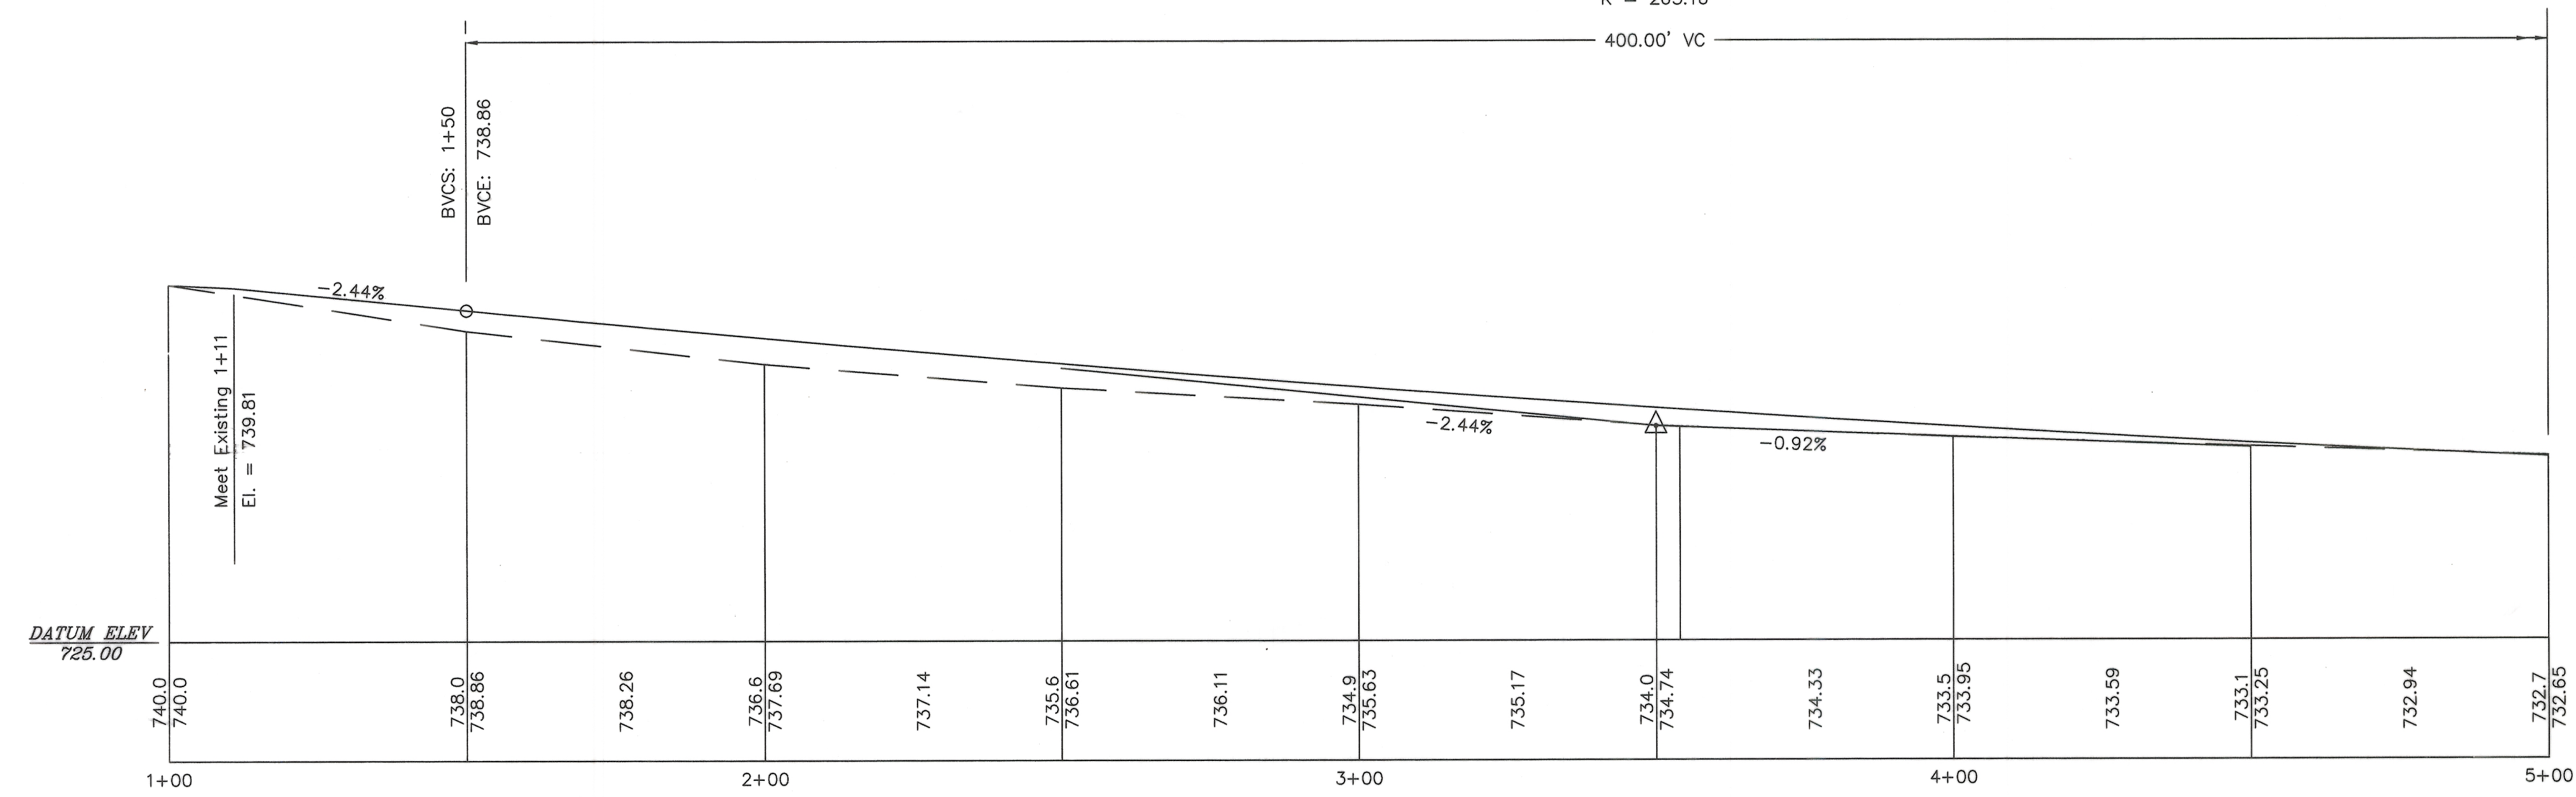

George A. Mara
George A. Mara P.S. #5508

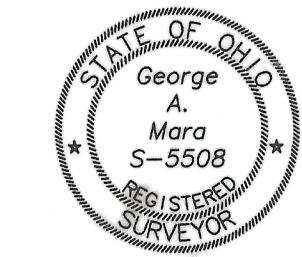

CENTERLINE SURVEY
ATHENS TOWNSHIP
CONNETT ROAD
ENV 497 A