


AS-BUILT NOV. 1998

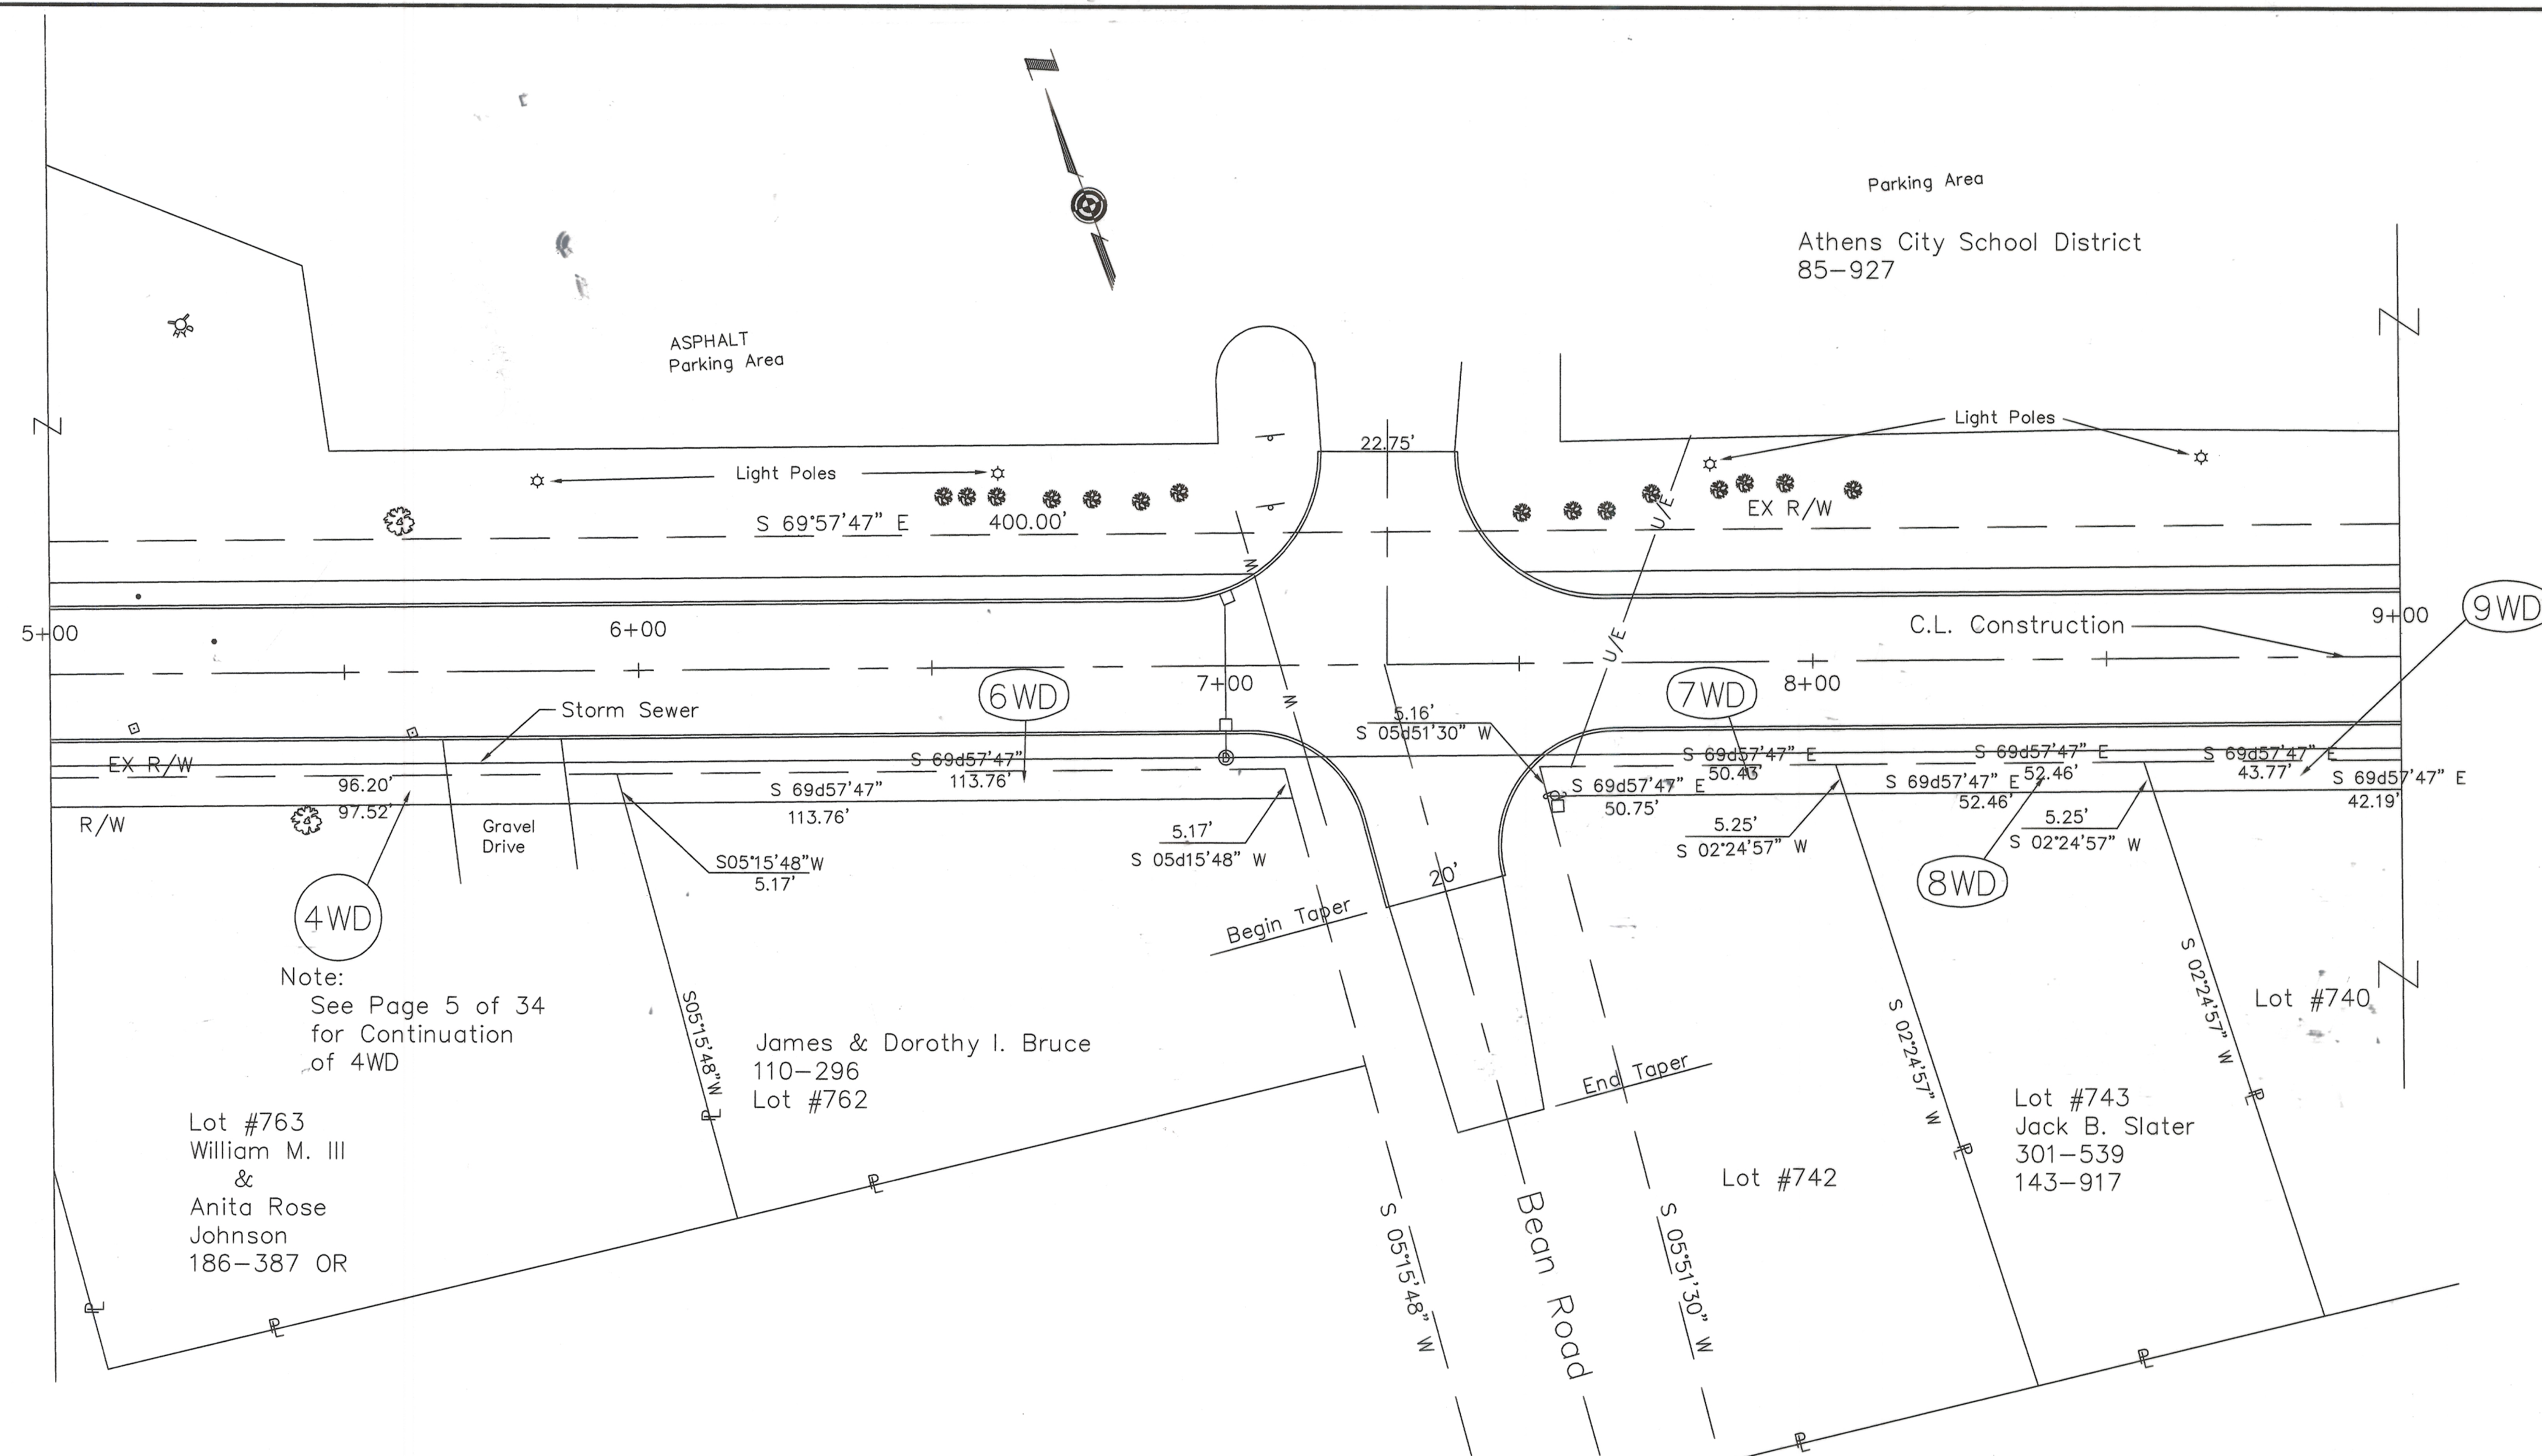

*Pauli Stehly 6/30/99*  
Athens County Engineer

*Shirley 7-1-99*  
Code Enforcement / Zoning Inspector


*Chas. C. Dams, P.S. 7/7/99*  
Athens County Sanitarian

*David S. Swett 7/22/99*


19990006339  
Filed for Record in  
ATHENS COUNTY, OHIO  
JULIA MICHAEL SCOTT  
On 07-27-1999 At 01:19 pm.  
PLAT 43.20  
ENV 497B

PVI STA = 3+50  
PVI ELEV = 733.98  
A.D. = -1.52  
K = 263.16

PVI STA = 10+00  
PVI ELEV = 728.00  
A.D. = 1.20  
K = 250.00

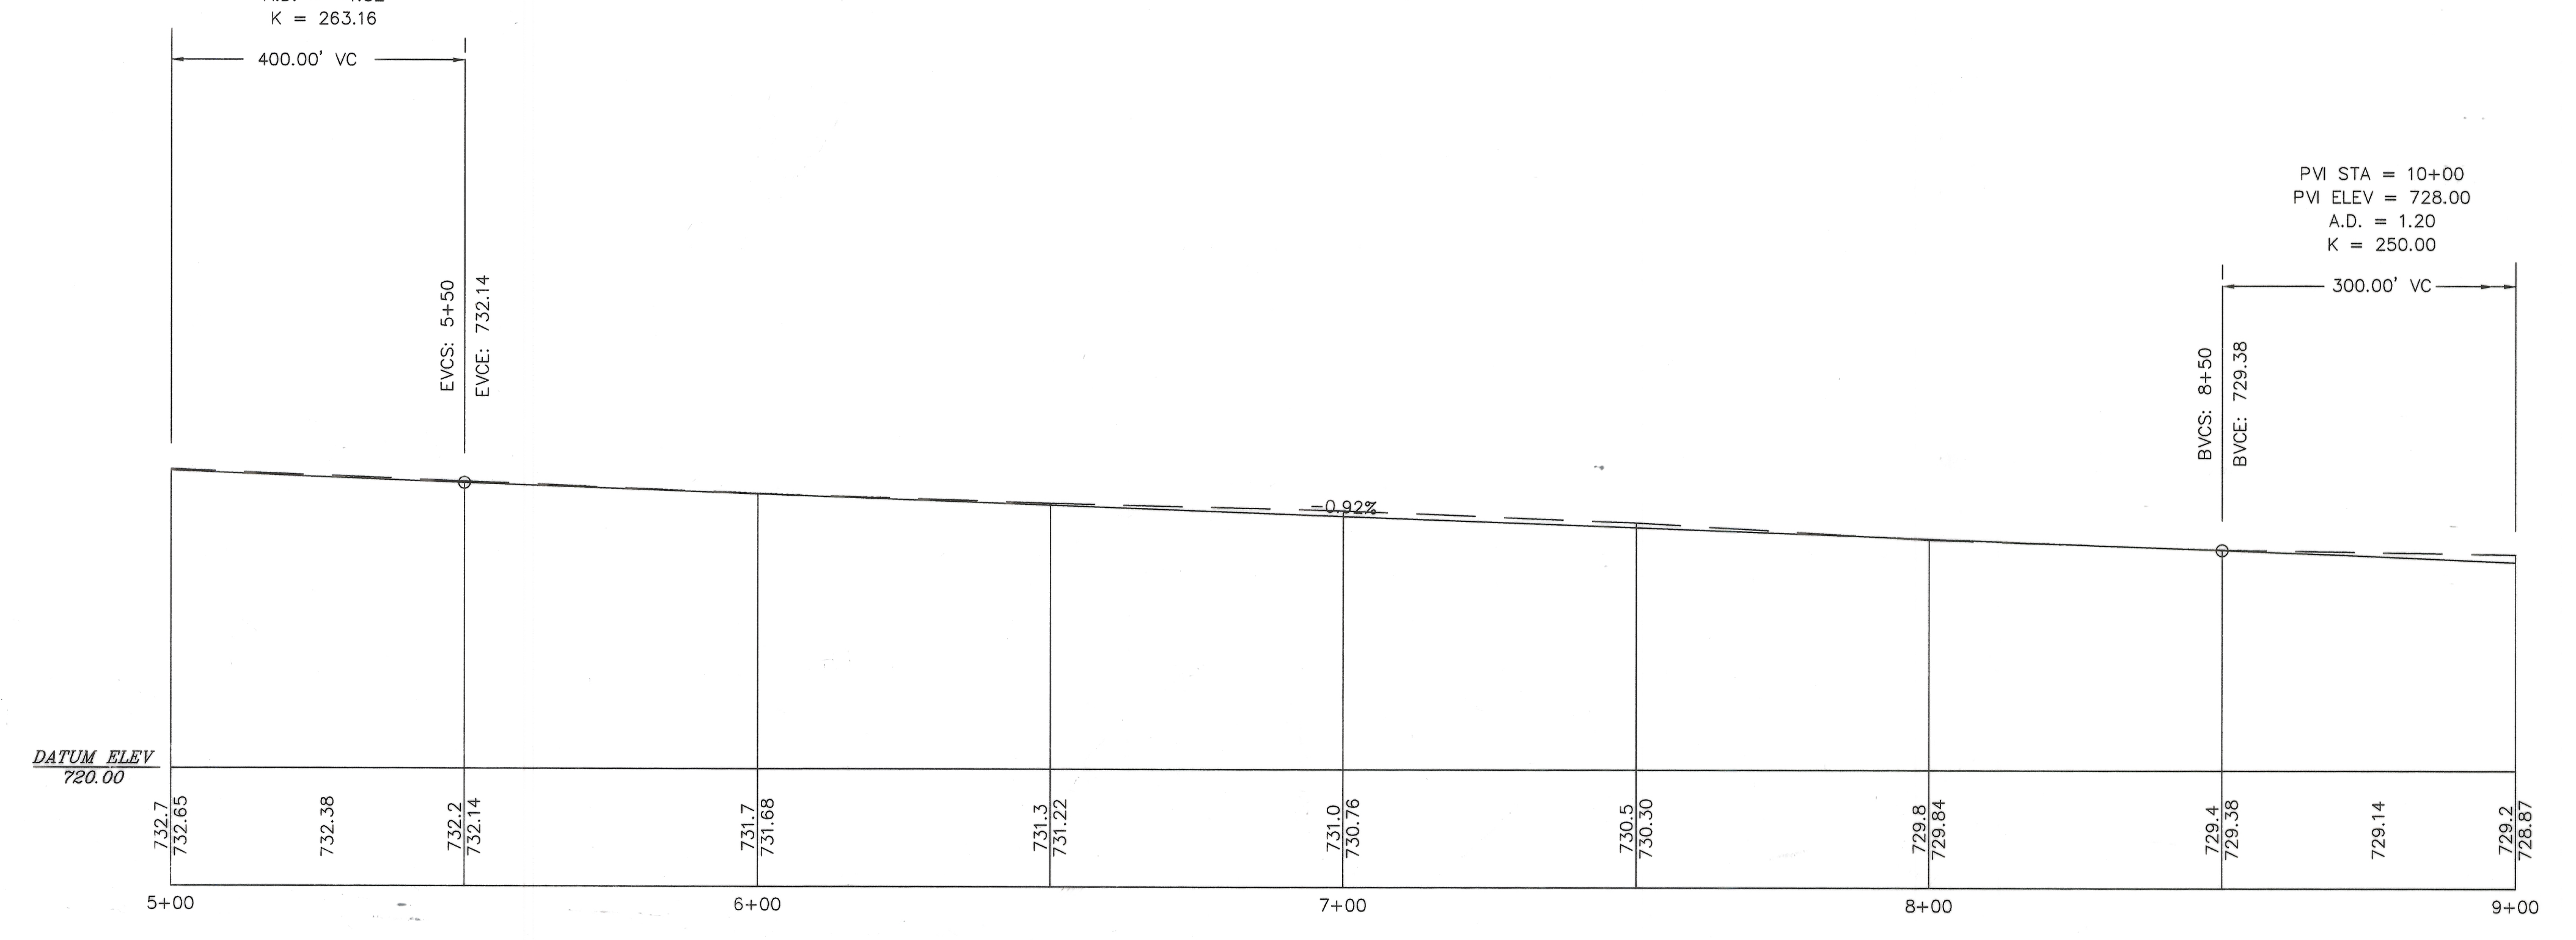

*George A. Mara*  
George A. Mara P.S. #5508

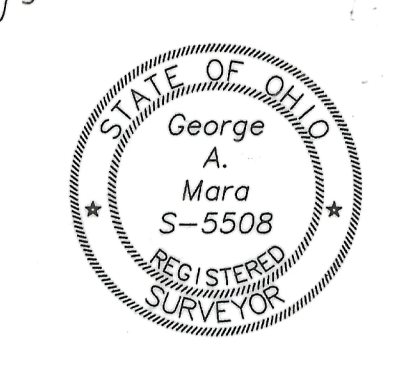

CENTERLINE SURVEY  
ATHENS TOWNSHIP  
CONNETT ROAD  
ENV 497 B