


Athens City School District  
85-927

AS-BUILT NOV. 1998

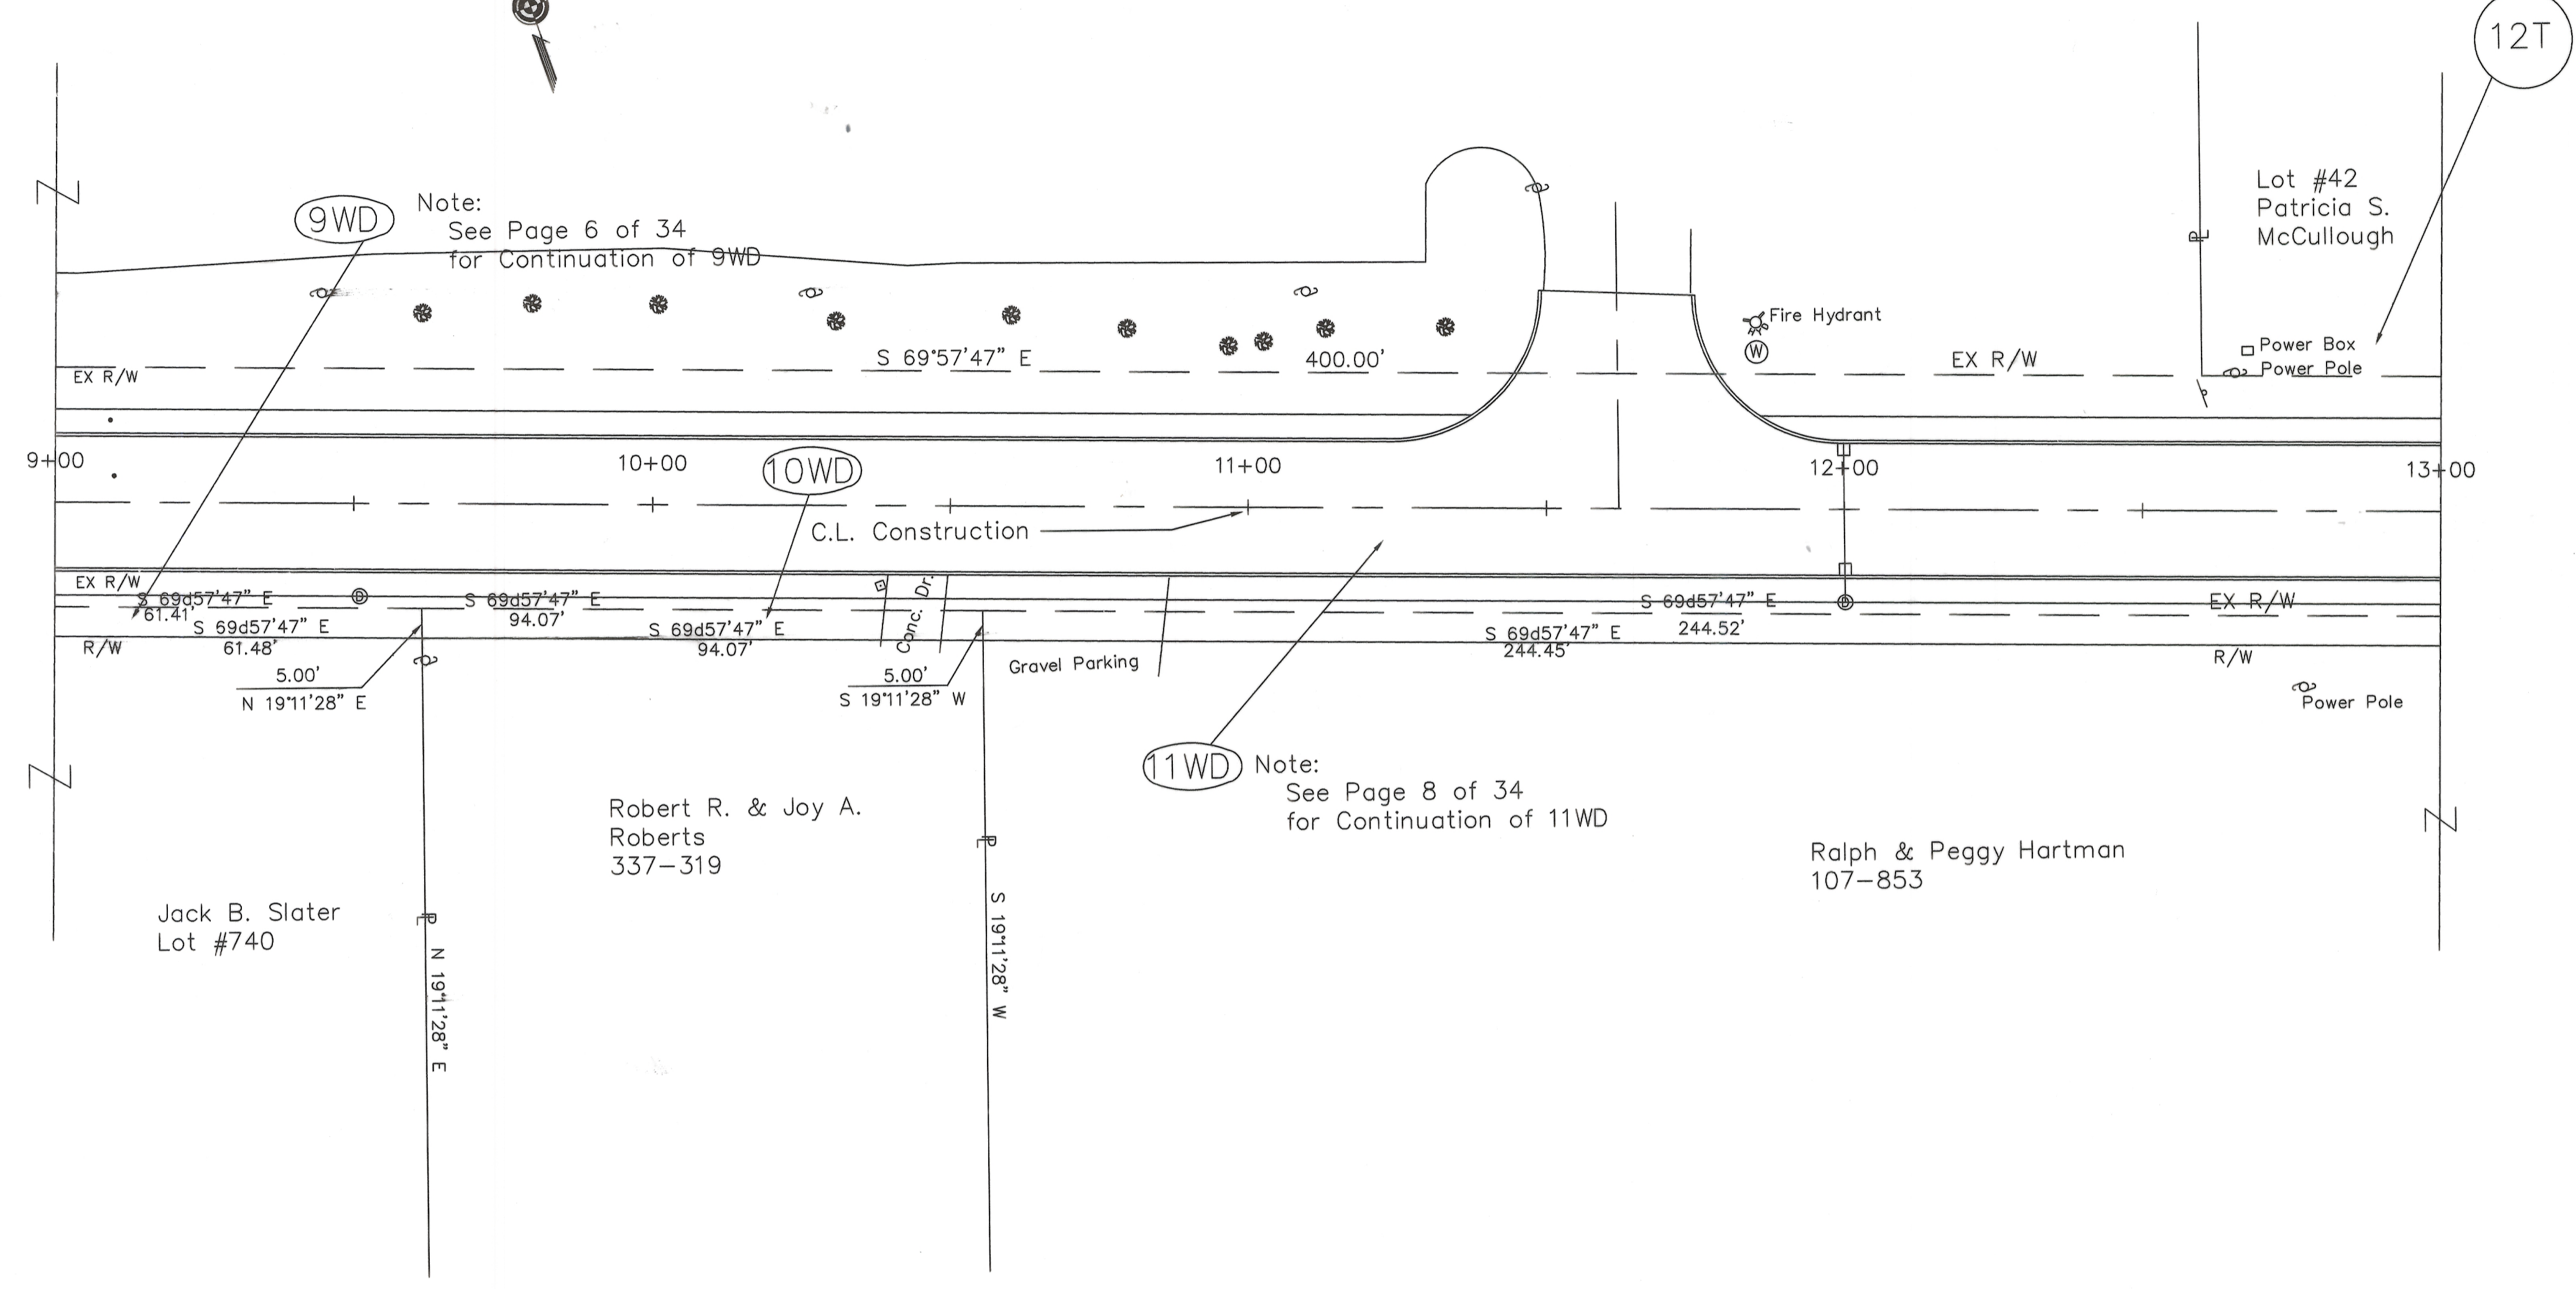

*Paul H. ...* 6/30/99  
Athens County Engineer

*John H. ...* 7.1.99  
Code Enforcement / Zoning Inspector


*David S. ...* 7/7/99  
Athens County Sanitarian

David S. Savett  
7/22/99

19990006340  
Filed for Record in  
ATHENS COUNTY, OHIO  
JULIA MICHAEL SCOTT  
On 07-27-1999 At 01:19 pm.  
PLAT 43.20 ENV 498A

PVI STA = 10+00  
PVI ELEV = 728.00  
A.D. = 1.20  
K = 250.00

LOW POINT ELEV = 720.67  
LOW POINT STA = 14+41.57  
PVI STA = 14+00  
PVI ELEV = 719.52  
A.D. = -3.32  
K = 90.36

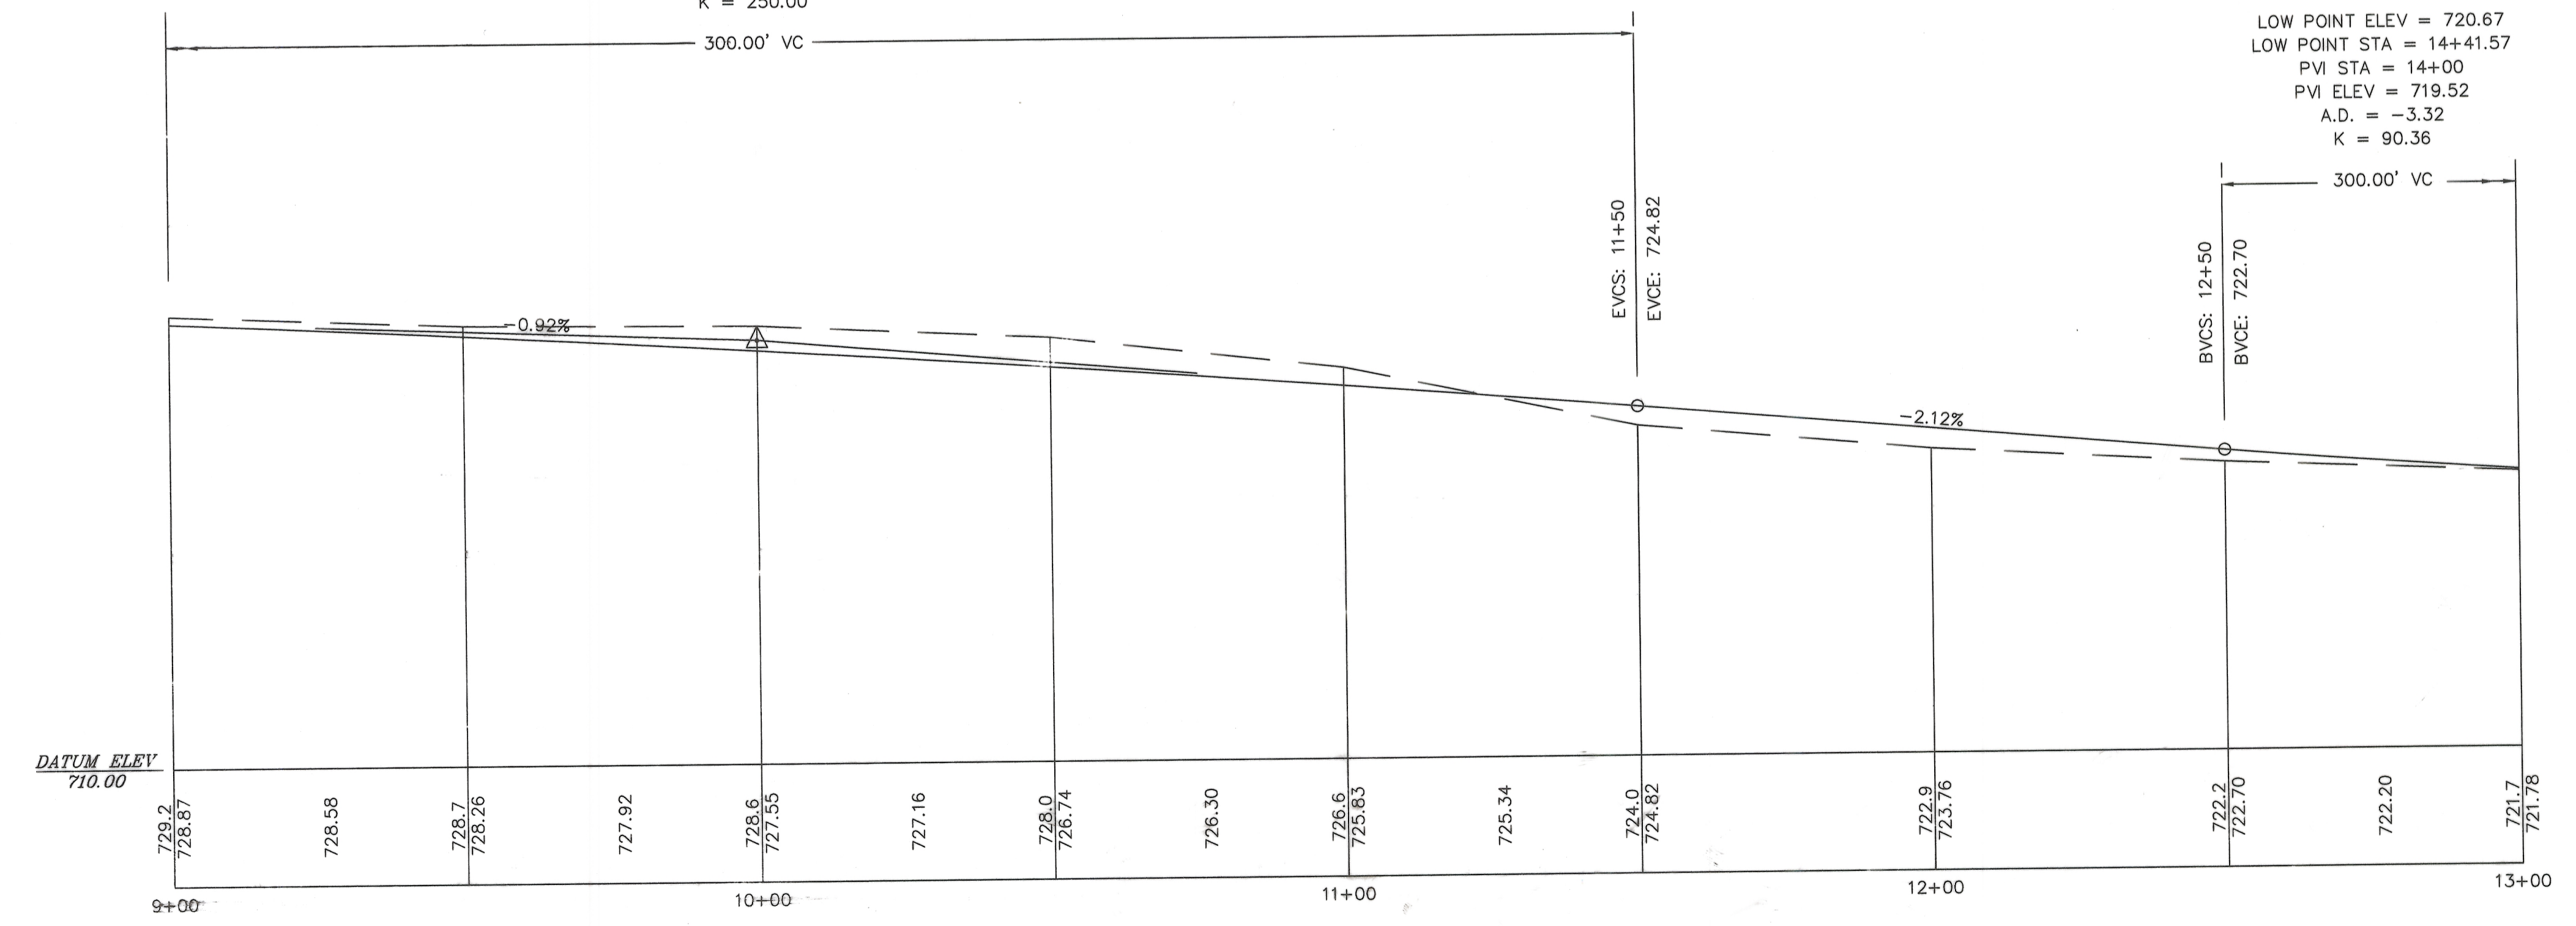

*George A. Mara*  
George A. Mara P.S. #5508



CENTERLINE SURVEY  
ATHENS TOWNSHIP  
CONNETT ROAD  
ENV 498 A