


No 451

DOVER


Notes of reference, **D**over is situated in the
 S.E. corner of **S17210R14** Ohio Company's Purchase
 The streets are each 100 links wide Main street Bears
 N^o 6 all other streets and alleys (which are 25 links wide)
 are either parallel or at right angles to Main street
 There were stones set one at the N.E. and an other
 at the N.W. corner of Lot No 17

N^o 9 { Hickory 10 N 5 1/2 E 30 1/2 links dist.
 a P.E. { Beech 11 N 14 W 449 " " " set
 P17 { Oak 18 S 61 W 119 " " " in 1837
 Surveyed Sep 6th & 7th 1839 for
 Recorded Sep 25th 1839 Samuel Johnson

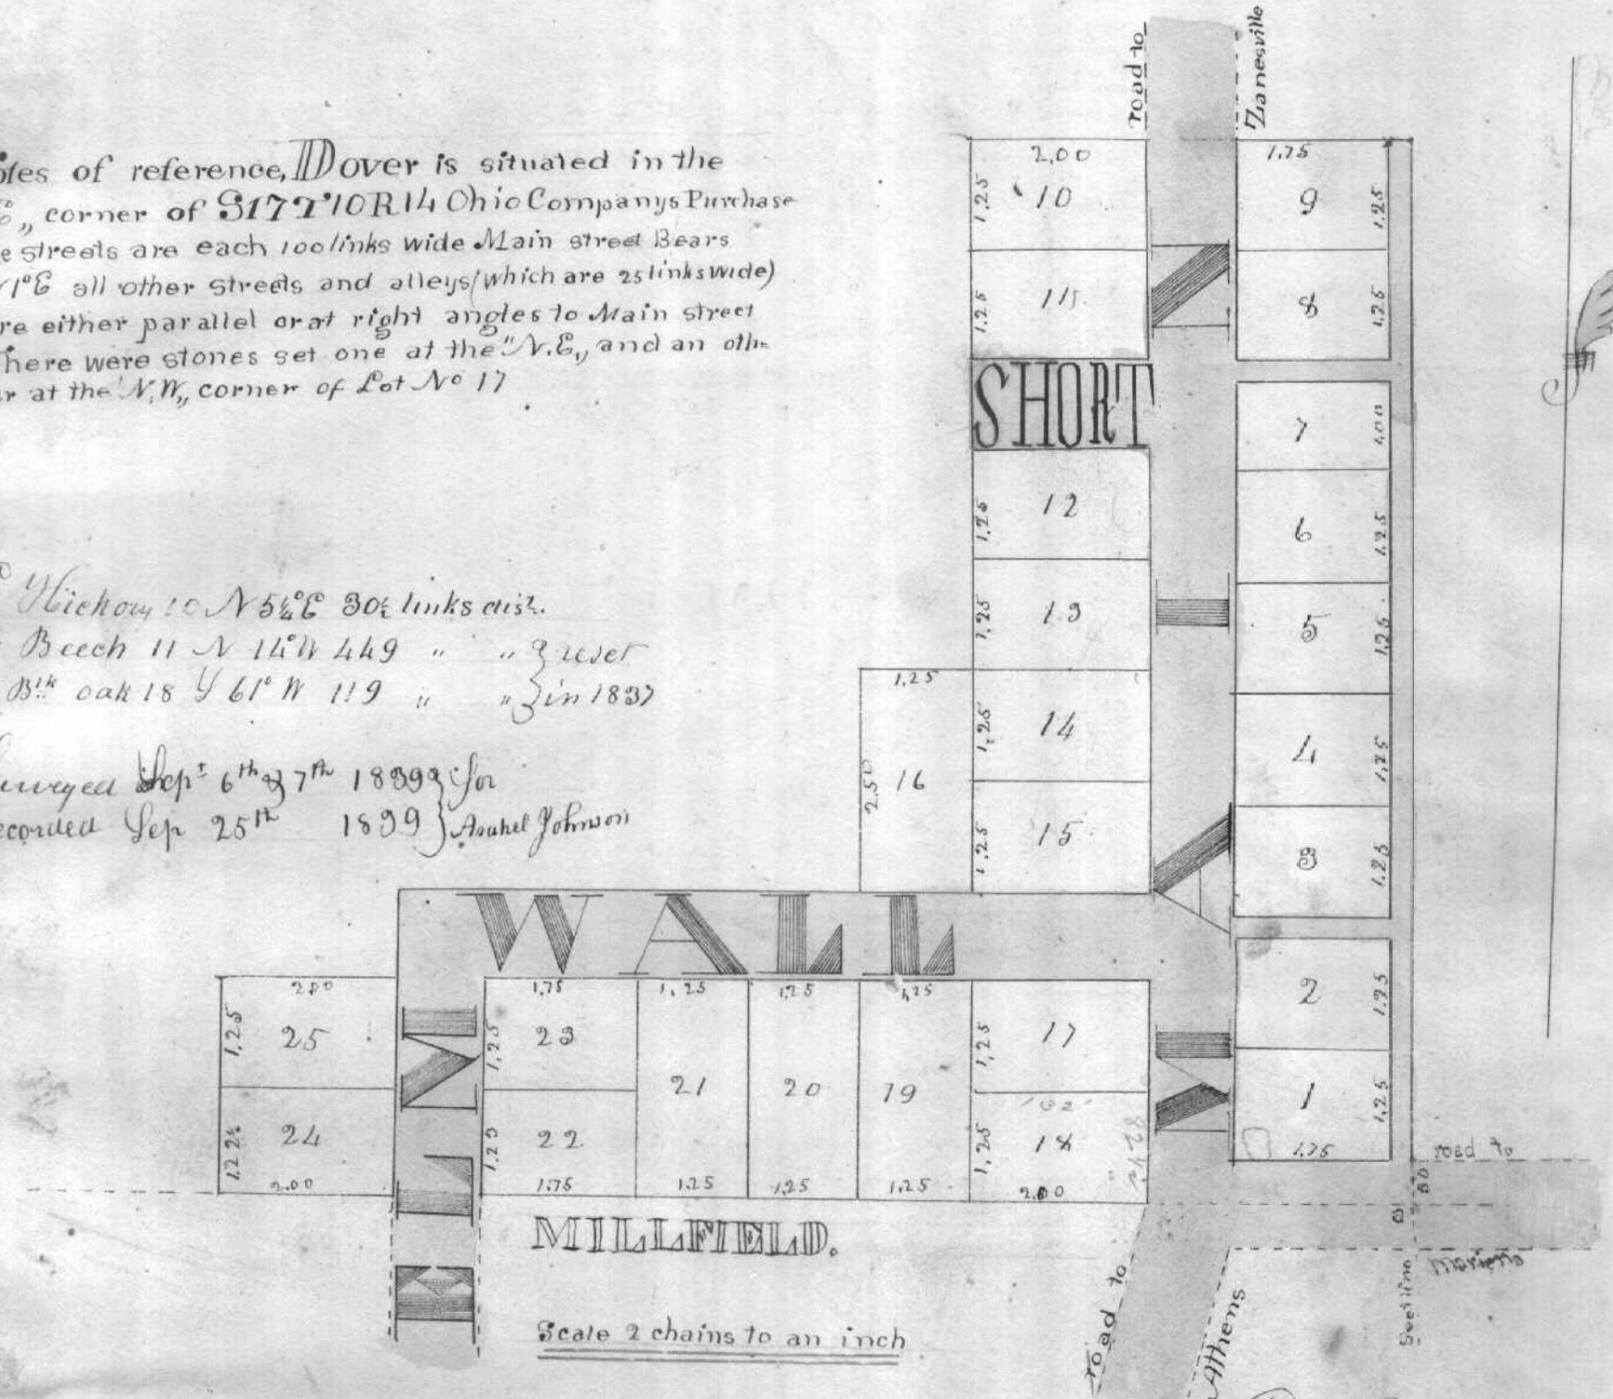

No 452 Samuel Denman's Survey **F 30 T 10 R 14** August 27th 1839

"to wit" Not Begins at a point in the
 N line 21.77 E of the N.W. corner of
 Said Tracton thence S 37 1/2 N 800
 to a B Walnut stump a Hickory
 10 S 71 1/2 E 35 a Lynn 11 S 77 1/2 E 82
 thence N 56 E 11.28 thence N 4.44
 to the place of Beginning contain-
 ing 142 1/2 A

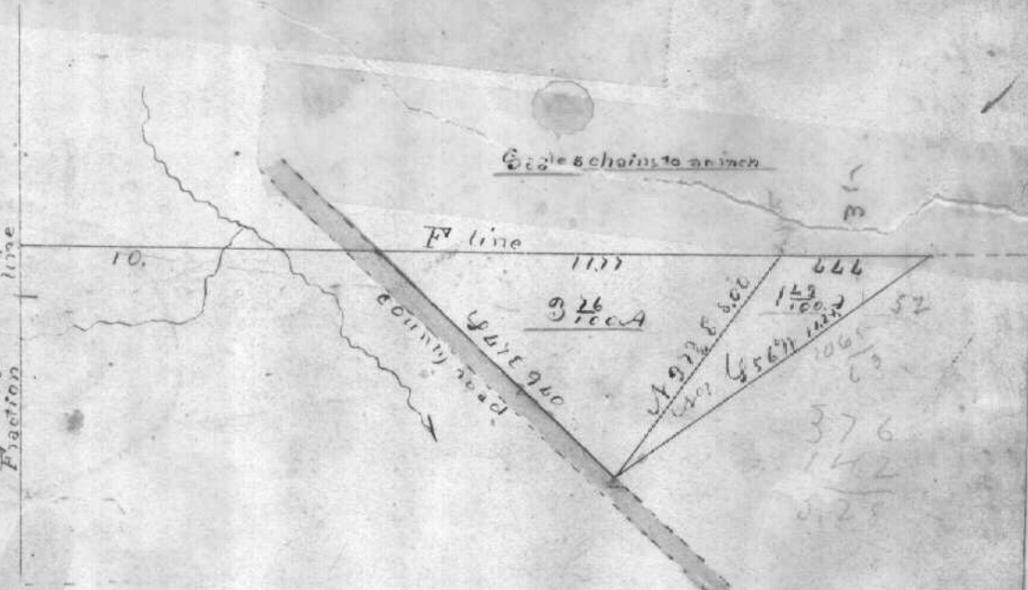

Surveyed for Samuel Denman
 August 27th Recorded Sept. 27th 1839