


N<sup>o</sup> 304. IN RIVER LOTS 640 & 641. IN NELSONVILLE & YORK T<sup>p</sup>.

- ① { Red oak 20" S 23 W 34 ft.  
" " 18" West 16 1/2 "
- ② { White oak 20" N 67 1/2 W 34 "  
Chestnut oak 20" N 8 1/2 W 35 "
- ③ { Yellow oak 20" N 81 1/2 E 29 "  
" " 18" S 49 W 48 "
- ④ { Beech 8" N 53 1/2 E 28 1/2 "  
White oak 30" N 78 E 33 "
- ⑤ { White oak 18" N 56 W —  
Black oak 24" S 55 E 30 ft. orig. dead —
- ⑥ { Chestnut oak 20" S 64 E 25 1/2 ft.
- ⑦ { Black oak 15" N 39 E 38 "  
White oak 15" N 29 1/2 W 76 "
- ⑧ { Beech 18" S 2 1/2 W 101 "  
" 15" N 29 1/2 W 72 "
- ⑨ { Beech 20" N 59 E 17 "  
" 15" S 71 W 34 "  
" 15" N 72 E 23 "  
} Palloona.
- ⑩ { White oak 18" S 36 1/2 W 74 "  
Hickory 15" N 12 1/2 E 60 "

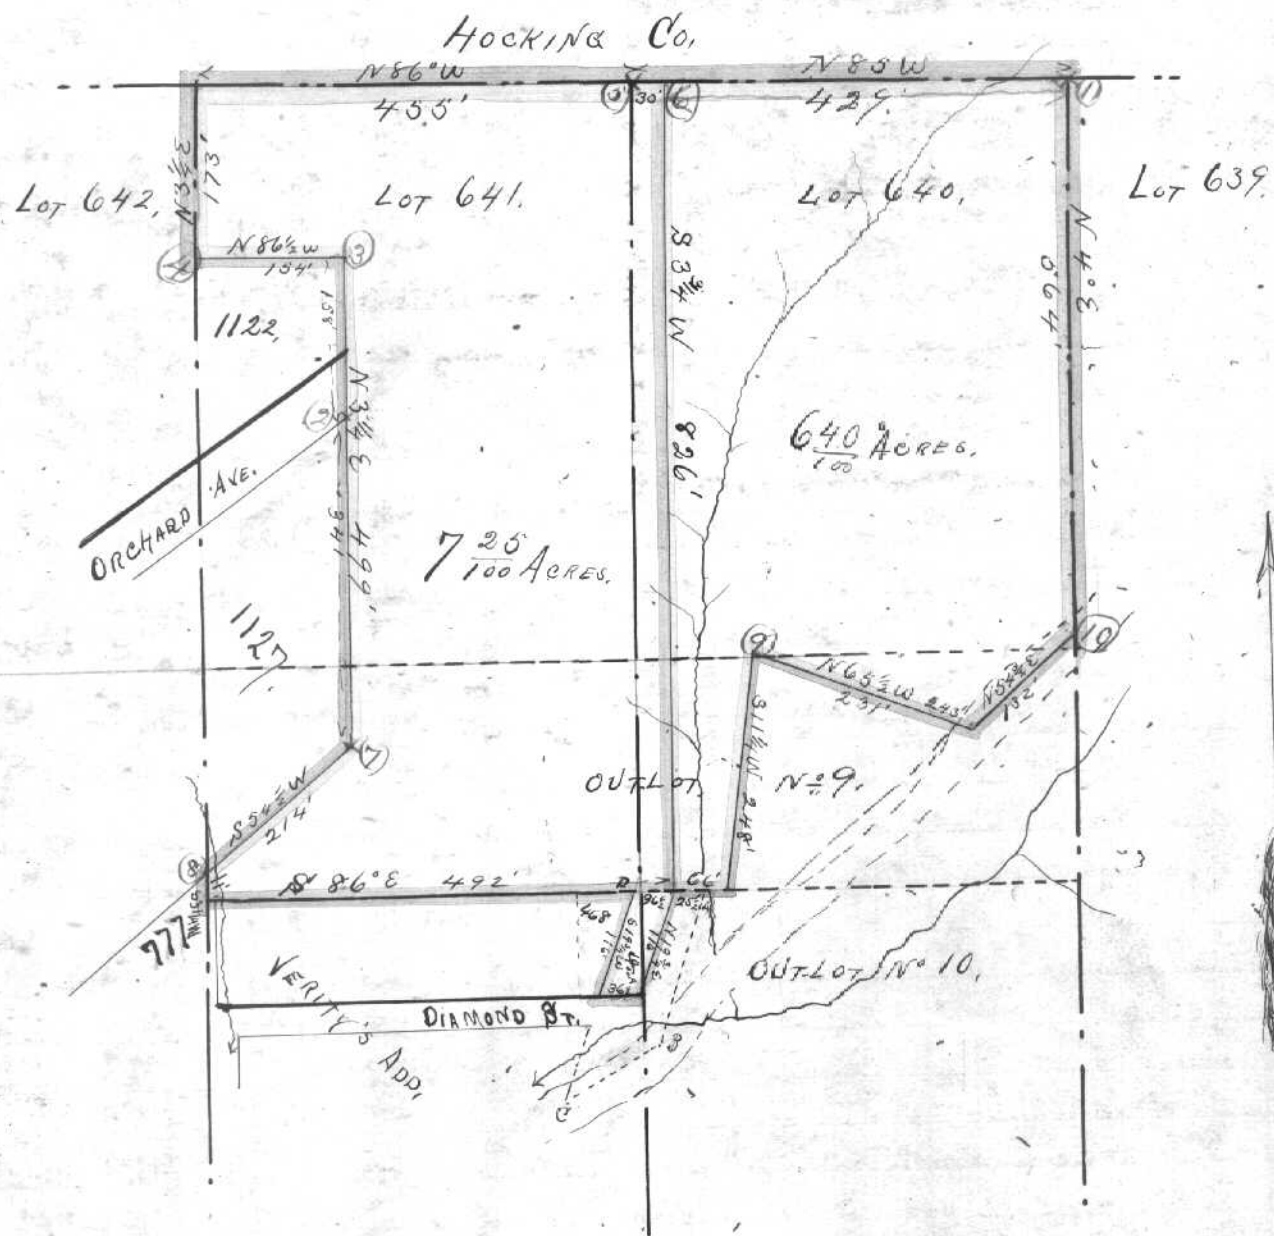

Scale 200 ft. to an inch.

Note. — For A.B.C. & D. see deed of Joseph Verity to Jane Scott made and recorded in Volume N<sup>o</sup> 27. Pages 605 & 606. of the Record of Deeds in Athens County, Ohio.

Steel Tape measurement.

Bearings connected to the true meridian at Athens, Ohio.

Surveyed Feby 22<sup>d</sup> 1890. for heirs of Jane Scott.

Recorded Feby 27 1890

by W.E. Peters

County Surveyor.

L. L. Scott }  
Earl Scott } asst.