




SOUTHEASTERN LAND SURVEYS

LEONARD F. SWOYER
REGISTERED PROFESSIONAL LAND SURVEYOR

3428 Pleasant Hill Road
Athens, Ohio 45701
614/593-8701

*ok to transfer
all parcels - A, B, & C
are own 5 acres.
Athens City - County Health Dept.
Lawrence Brown, P.S.
10-19-94*

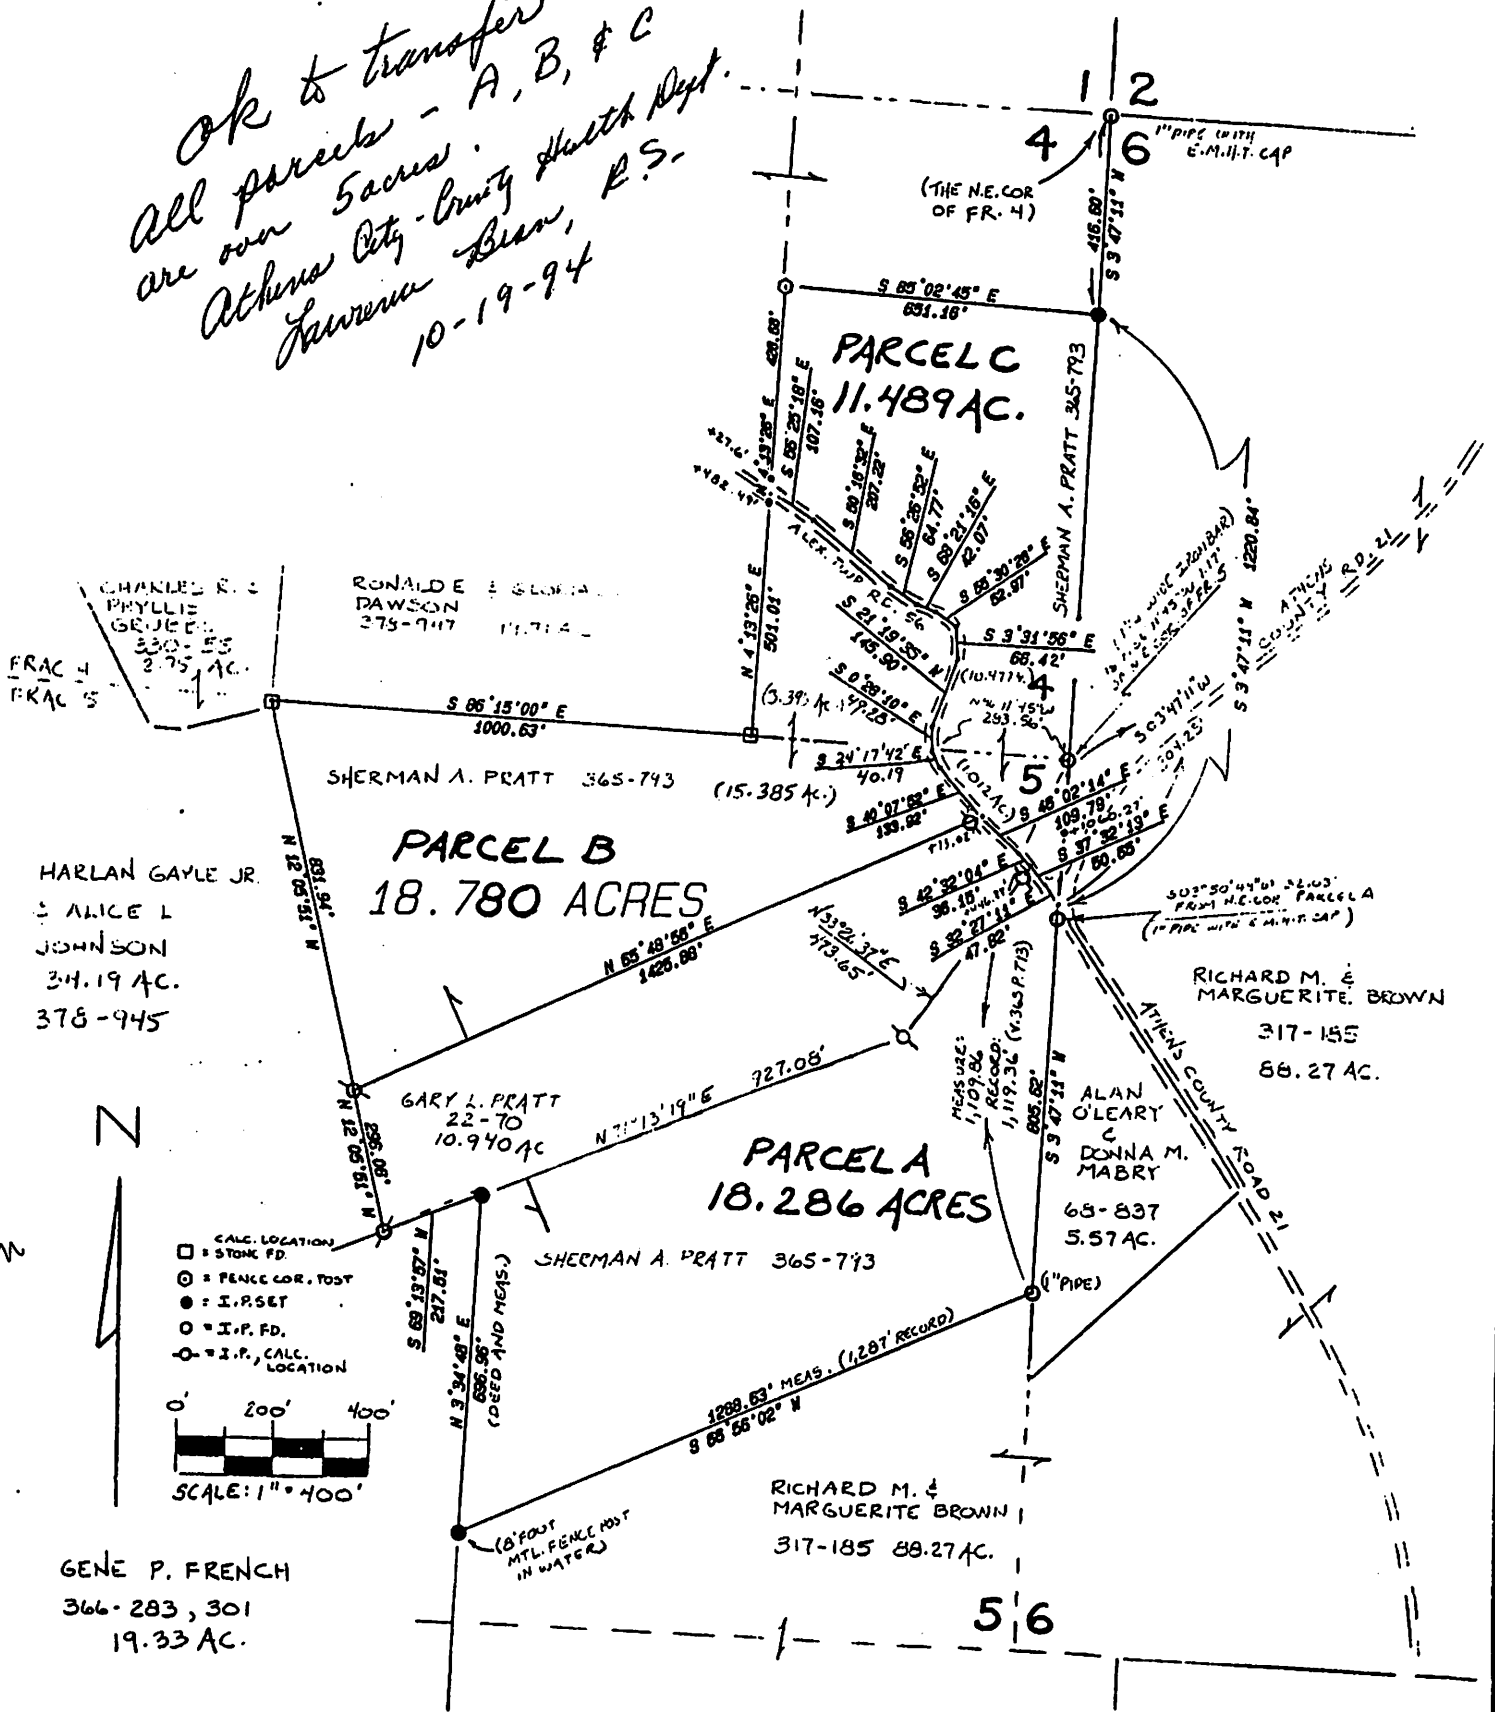

Plat of Survey of Tracts 1, 2 and 3 Scale 1" = 400'

Surveyed for Gary Pratt Date 4/09/93

Subdivision F.L. 4 and 5

Township Alexander Section 11 Town 8 Range 14

Corporation --- County Athens State Oh.

Leonard F. Swoyer Jr.
Leonard F. Swoyer Jr. Reg. Prof. Land Surveyor No. 6765

11.49A

Alert-11