


Collins
260-177

Description Checked for
Mathematical Accuracy
Athens County
BY: S. R. Eason
ENGINEER'S OFFICE
DATE: 7-18-07

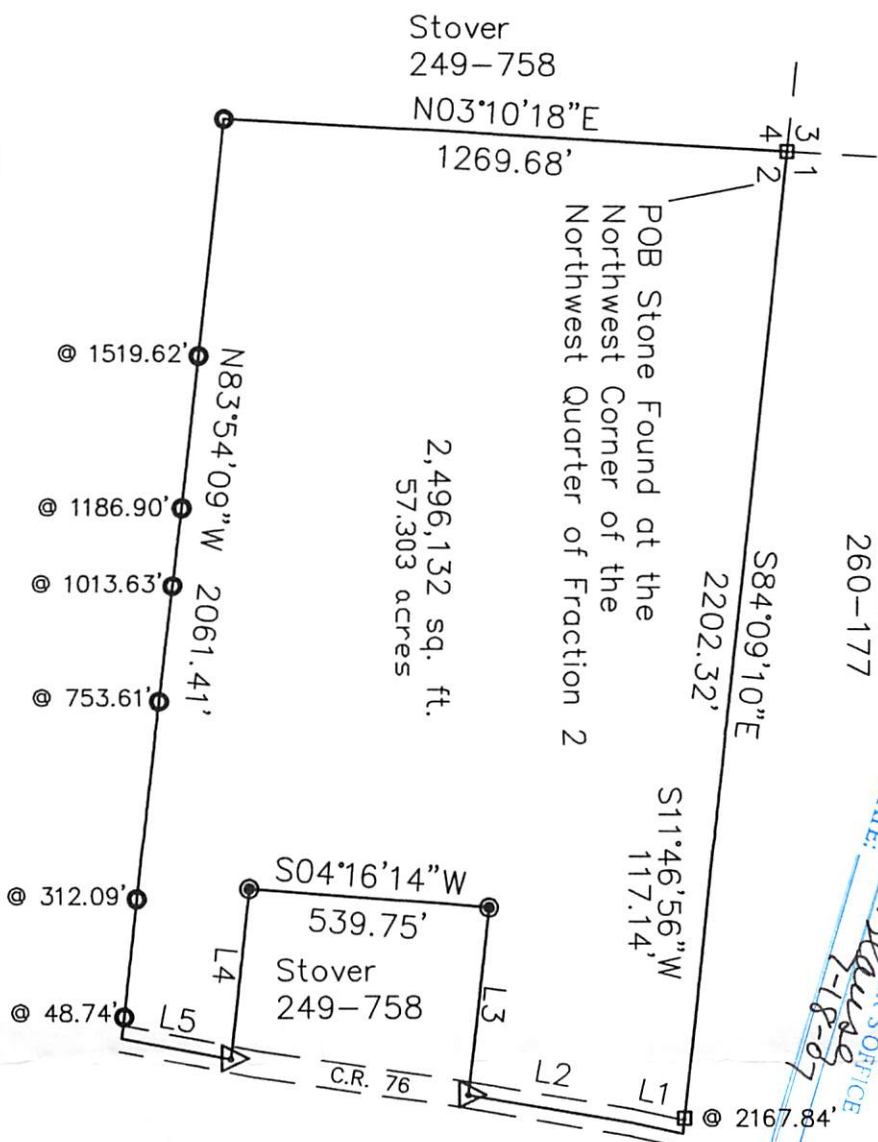

2,496,132 sq. ft.
57.303 acres

Stover
249-758

LINE	LENGTH	BEARING
L1	117.14	S11°46'56\"W
L2	373.34	S09°09'48\"W
L3	423.28	N83°58'46\"W
L4	381.29	S83°58'46\"E
L5	249.51	S10°37'54\"W


Plat of 57.303 Acre Survey
for David Stover
Sited in Fraction 2,
Section 22, T-8, R-14,
Alexander Township, Athens County, Ohio
and being a part of a 59.45 Ac. tract as
described in Official records Vol. 315 pg. 604

Subject to all legal easements
and rights-of-way of record.
Basis of Bearing: West line of Fraction 2
being N 03 10'18\" E
Bearings are used to denote angular
relationships only.



- ▣ Stone found
- △ Mag Nail found
- 5/8\" Solid Pin Found
- 5/8\" x 30\" Rebar set

GRAPHIC SCALE

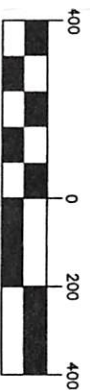

(IN FEET)
1 inch = 400 ft.

Reference used:
Prior Survey by Highland PS 7581
Dated October, 2005
Prior Survey by England PS 7452
Dated September, 2006
Containing 57.303 acres
as surveyed June, 2007
by Mark Schloss checked and approved by
E. and E. Borderline Surveying.

Robert R. Eason Professional
Land Surveyor # PS 7033

Aug-22

57.303 Ac.