



SOUTHEASTERN LAND SURVEYS

LEONARD F. SWOYER
REGISTERED PROFESSIONAL LAND SURVEYOR


3428 Pleasant Hill Road
Athens, Ohio 45701
614/593-8701



SCALE: 1" = 200'

- - I.P. FD.
- - STONE (CALC. LOCATION)
- - STONE FD.

LINE	BEARING	DISTANCE
L 1	N 84° 17' 38" E	132.61'
L 2	N 78° 31' 15" E	73.49'
L 3	S 11° 10' 39" E	30.18'

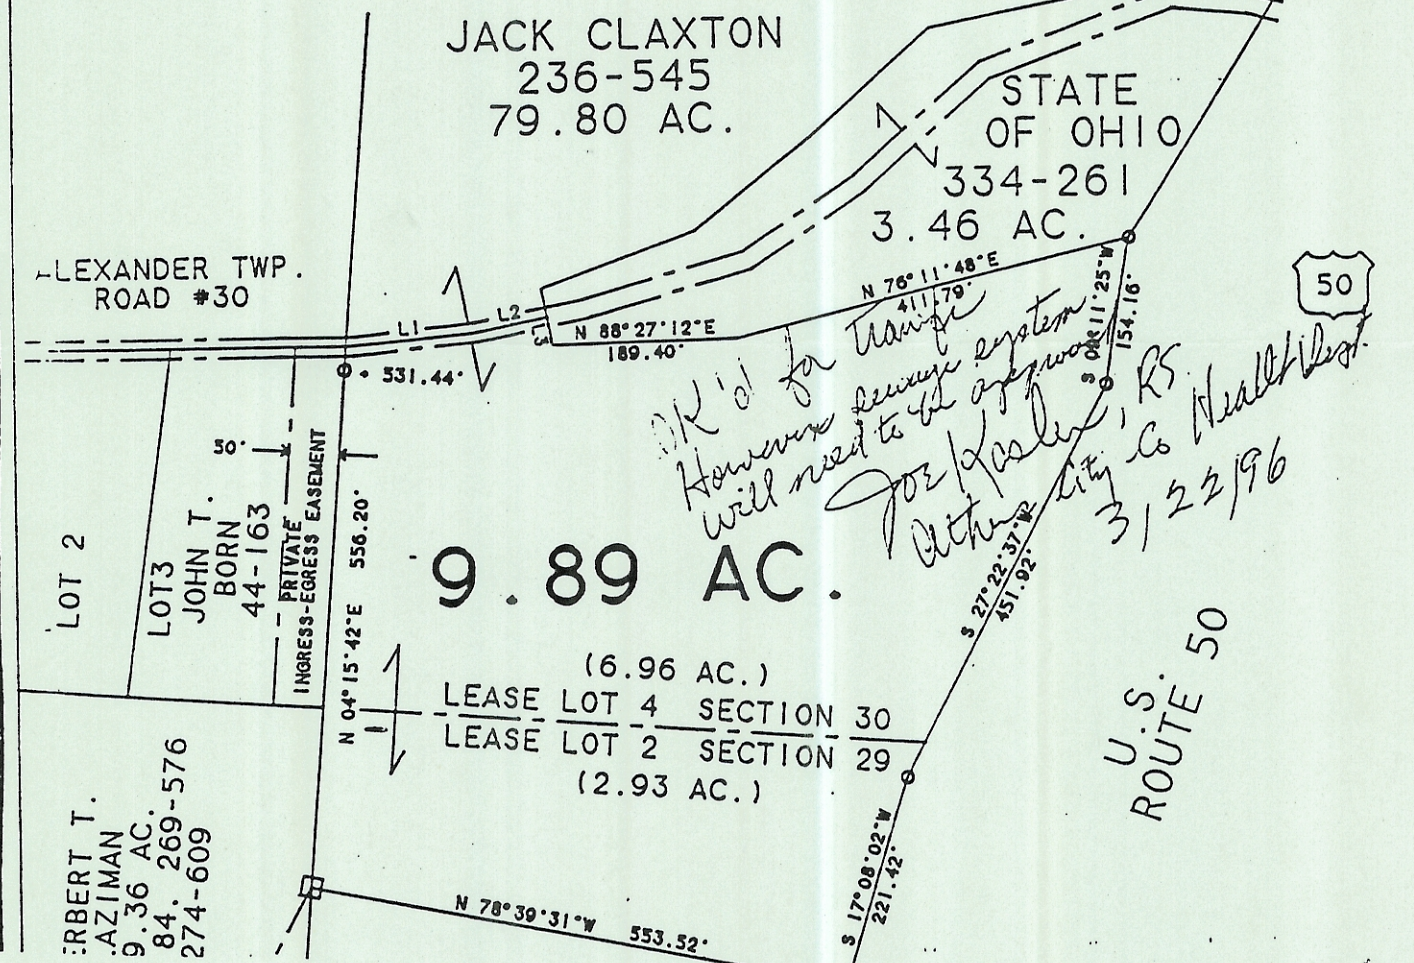

580AC
100-30

*OK'd for transfer
However sewage system
will need to be approved
Joe Hasler,
Athens City, OH
3/22/96*

U.S. ROUTE 50