




○ IRON PIN SET (5/8" X 30" REBAR)

⊙ IRON PIN FOUND

TAX Plat and DEEDS

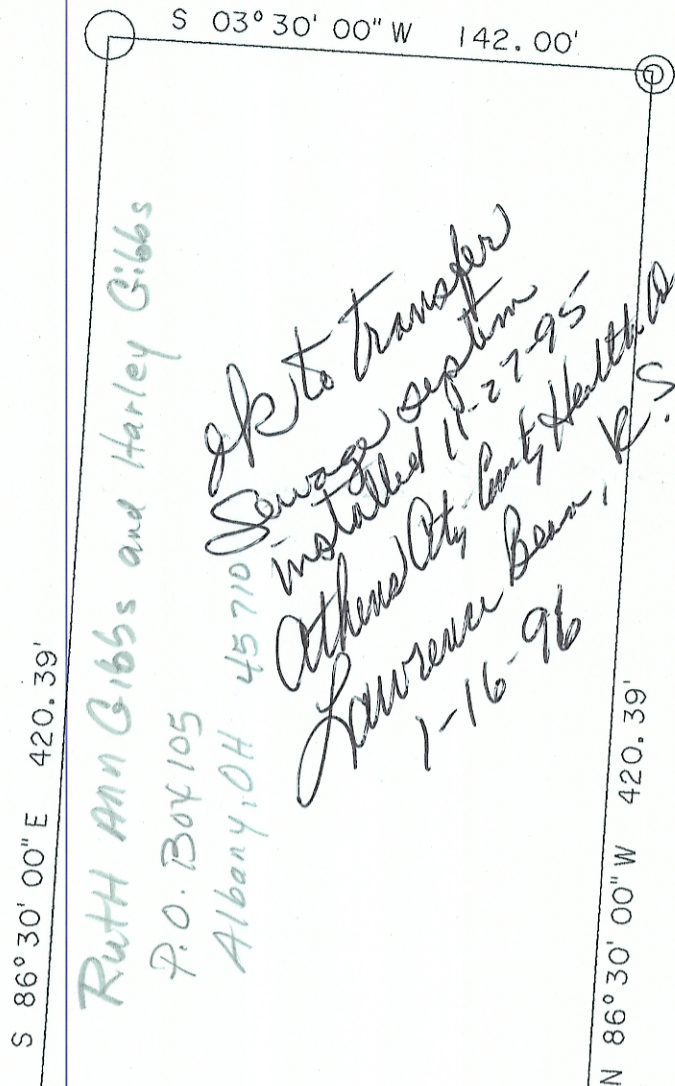


*Ruth Ann Gibbs and Harley Gibbs*  
*P.O. Box 105*  
*Albany, OH 45710*

*Sp to transfer*  
*sewer system*  
*installed 11-27-95*  
*Athens City Public Health Dept.*  
*Lawrence Brann, P.S.*  
*1-16-96*

HOBBS 357-445


1.37 ACRES

L1 N 86° 30' 00" W 16.00'  
 L2 S 86° 30' 00" E 16.00'

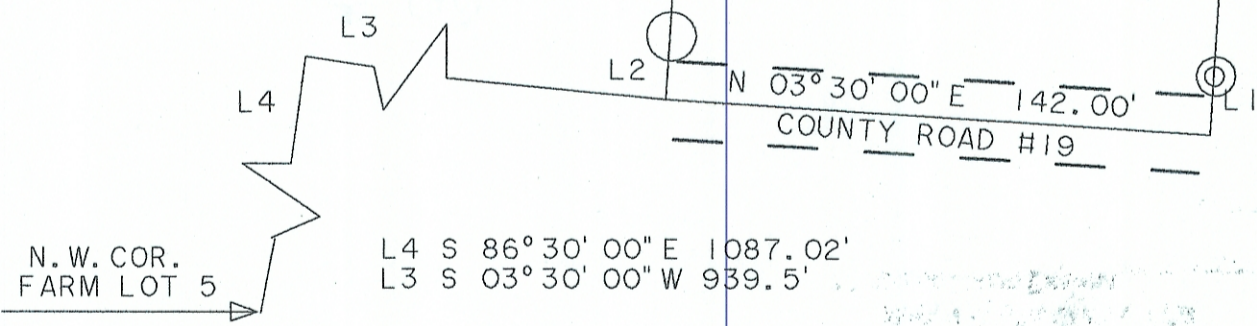

L4 S 86° 30' 00" E 1087.02'  
 L3 S 03° 30' 00" W 939.5'

50 0 50 100 150

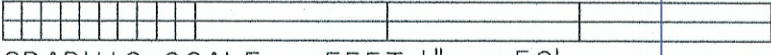

GRAPHIC SCALE - FEET 1" = 50'

SURVEY OF A 1.37 ACRE TRACT IN  
 SECTION 32, T. 8, R. 14,  
 ALEXANDER TOWNSHIP, ATHENS COUNTY OHIO  
 SURVEYED NOV. 1995

JOHN M. BRANNER P. S. 6805  
 12500 N. PEACH RIDGE ROAD  
 ATHENS OHIO (614) 592-5778