Situated in Lease Lot#3 and Lease Lot #4, Section 21, T.8,R.14,Alexander Township, Athens County, Ohio, and being a part of a 10.51 acre tract described in Athens County Deed Book 302, Page 255, and being more particularly described as follows:

Beginning at a stone found at the South-west corner of Leases Lot 4, thence along the South-line of Lease Lot#3, N 86°00'W, 192.06' to a point in County Road #76, passing an iron pin found at 170.18'; thence along said road, N 33°22'30"E, 332.94' to a point; thence, leaving said road N 88°21'26"E, 148.23' to an iron pin set, passing an iron pin set at 60.10'; thence, S 80°23'39"E,160.00' to an iron pin set; thence, S 3°56'43"W, 289.08' to an iron pin set in Grantor's South-line; thence along said line N 86°00'W, 278.28' to a stone, said stone being the point of beginning and containing 2.638 acres, of which 1.911 acres are in Lease-Lot#4 and 0.727 acres are in Lease-Lot#3.


Subject to all easements and rights of way of record

John M. Branner Registered Surveyor#6805

Description checked for Mathematical Accuracy ATHENS COUNTY ENGINEER'S OFFICE

BY: _____



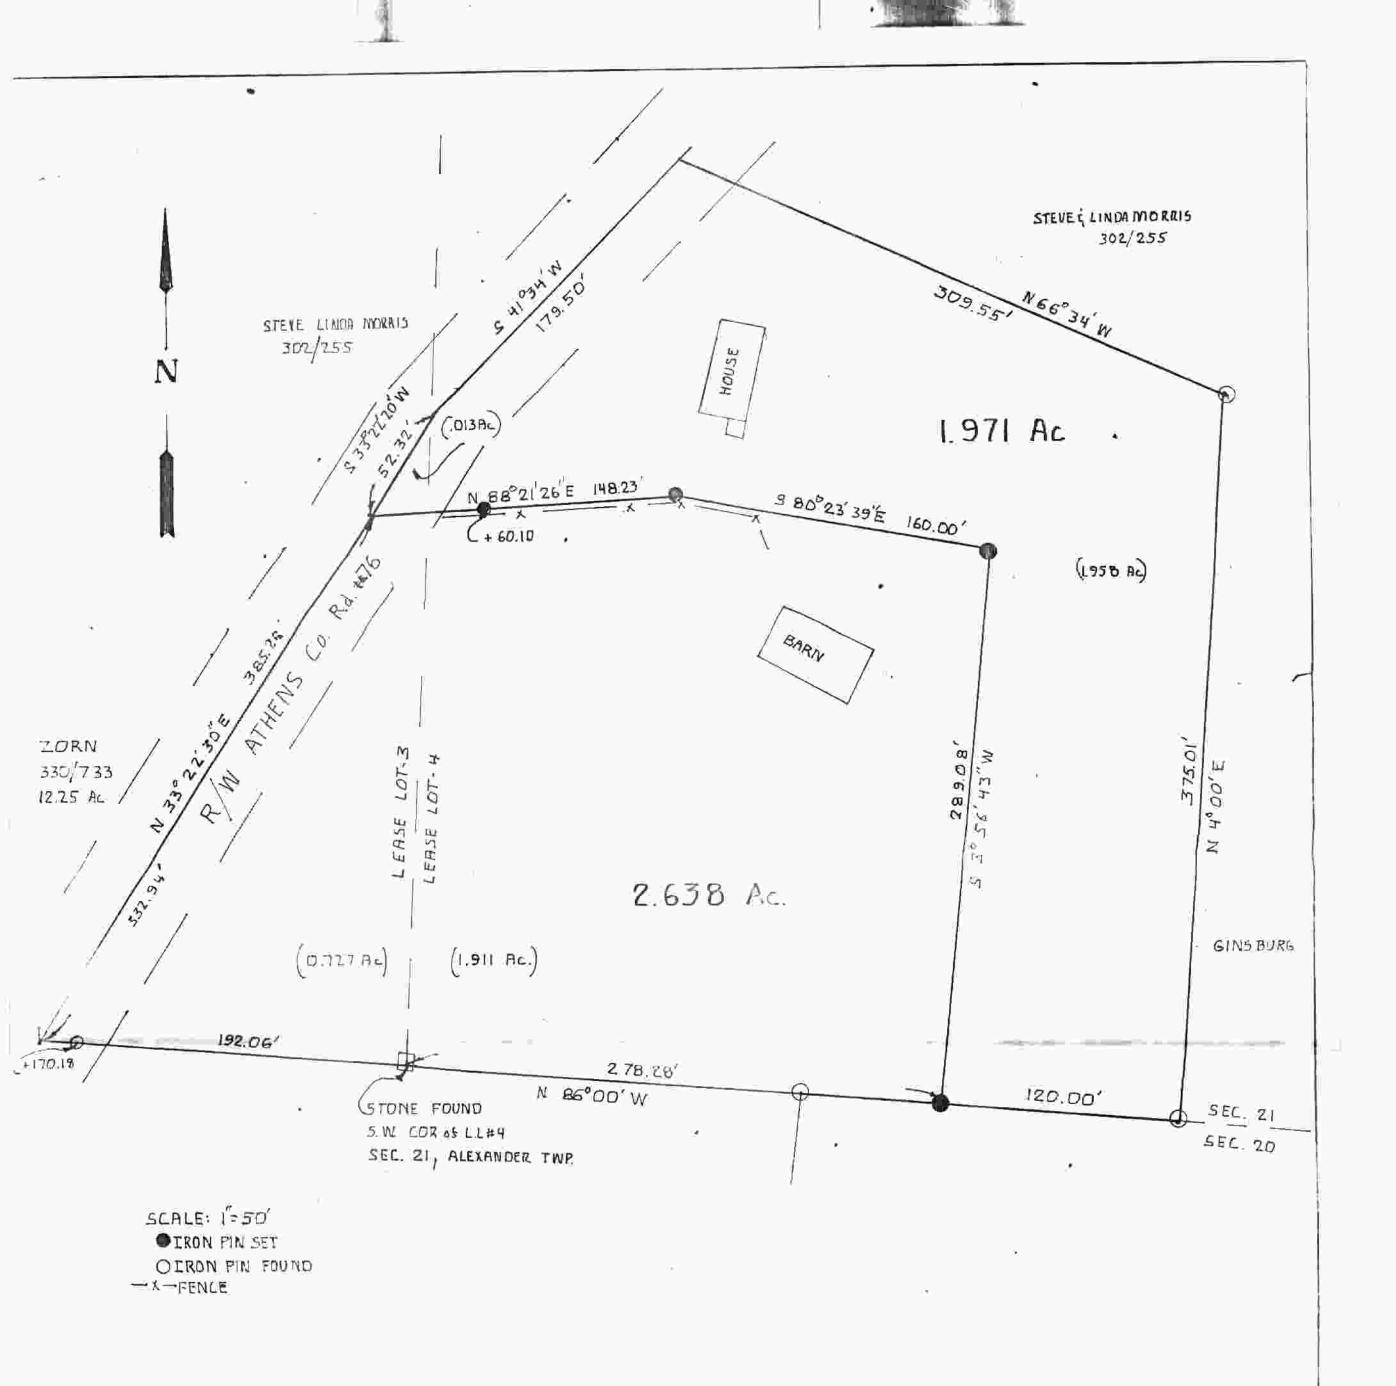

RVEY OF A 1.971 ACRE TRACT AND

E. 2.638 ACRE TRACT IN LEASE LOTS

E. 4, SECTION 21, ALEXANDER TWP.,


T. 8, R. 14, ATHENS COUNTY, OHIO

FOR STEVE MORRIS.

PREPARED BY:

BRANNER SURVEYING Rt. 3 ATHENS O. 614-592-5**778**

SURVEYED JUNE - 83

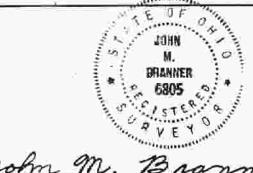

John M. Branner SOHN M. BRANNER REG. SURVEYOR 6805