

HAROLD D. ("DALE") WHALEY

REGISTERED SURVEYOR NO. 4986

ALBANY, OHIO 45710

Lots, Farms, Subdivisions and Construction Staking

1.5756 Acres

Situated in the S. E. Quarter of Sec. 25, T. 8, R. 14, Alexander Twp., Athens County, Ohio, and being more particularly described as follows:

Starting at the Northwest corner of the Southeast Quarter of Sec. 25, Thence along said Quarter Section line, S. $1^{\circ} 45' 50''$ E., 1,407.02 feet to a point;

Thence N. $76^{\circ} 19'$ E., 337.76 feet to a point; said point being the true point of beginning for the following described tract;

Thence N. $27^{\circ} 14'$ W., 39.4 feet to an iron pin on the Southwest corner of a 5.00 acre tract described in Vol. 320, Page 311, of the Athens County Deed Records;

Thence along the South line of said tract, N. $62^{\circ} 45'$ E., (passing an iron pin at 579.00 feet) for a total distance of 592.53 feet to a point in the centerline of S. R. No. 681;

Thence along the centerline of S. R. No. 681, S. $37^{\circ} 00'$ E., 192.88 feet to a point;

Thence leaving the highway, S. $76^{\circ} 19'$ W. (passing an iron pin at 19.00 feet) for a total distance of 643.16 feet to the point of beginning, containing 1.5756 acres, and being subject to all legal highway Rights of Way;

Surveyed June, 1971 by HAROLD D. WHALEY

Harold D. Whaley
Reg. Surveyor No. 4986

REVISED 2/13/75

H.D. Whaley

Description checked for

Mathematical Accuracy

ATHENS COUNTY

ENGINEER'S OFFICE

BY:

J.W.L.

DATE: 2-13-75

Sec #25 Acx
37

H. D. WHALEY
REGISTERED SURVEYOR NO. 4986
ALEXANDER, OHIO

Situated in the S. E. Quarter of Sec. 25, T. 8, R. 14, Alexander
Township, Adams County, Ohio, and bounded on the North by the
Tennessee River.

Thence said Quarter Section, from the Tennessee River, South
Thence N. $76^{\circ} 19'$ W., 337.76 feet to a point; said point being the
true point of beginning for the following described tract:

Thence N. $27^{\circ} 14'$ W., 39.4 feet to an iron pin on the S. W. corner
of a 5.0 acre tract;

Thence along the South line of said tract N. $62^{\circ} 46'$ E., 579.0 feet
to an iron pin, 1 $\frac{1}{4}$ feet off the centerline of S. R. 681,

Thence S. $35^{\circ} 50'$ E., 187.0 feet to an iron pin;

Thence S. $76^{\circ} 19'$ W., 624.16 feet to the point of beginning, contain-
ing 1.503 acres.

Surveyed June 1971 by HAROLD D. WHALEY

Harold D. Whaley
Reg. Surveyor No. 4986

* THIS 5.0 ACRE TRACT MUST BE REFERENCED BY CURRENT DEED VOL. & PAGE
IF REFERENCE IS TO BE MADE AT ALL.

** IS THIS INTENDED TO BE DESCRIBED ALONG THE EXISTING
HIGHWAY RIGHT-OF-WAY LINE? IF SO, THE FOLLOWING
CALL SHOULD BE IDENTIFIED AS SUCH — HOWEVER I
SUSPECT THE R/W. IS GREATER THAN 4' ON EITHER
SIDE OF R.


PLAT SHOULD INDICATE ALL SURROUNDING ADJACENT PROPERTY
OWNERS; REFERENCING BY DEED VOL. & PAGE.

CLOSURE AND ACREAGE CHECK OK; DESCRIPTION AND PLAT SHOULD BE
RE-SUBMITTED ONCE THE ABOVE MATTERS HAVE BEEN REMEDIED.

EDP 2-3-75

(38)

Sec 25 A X

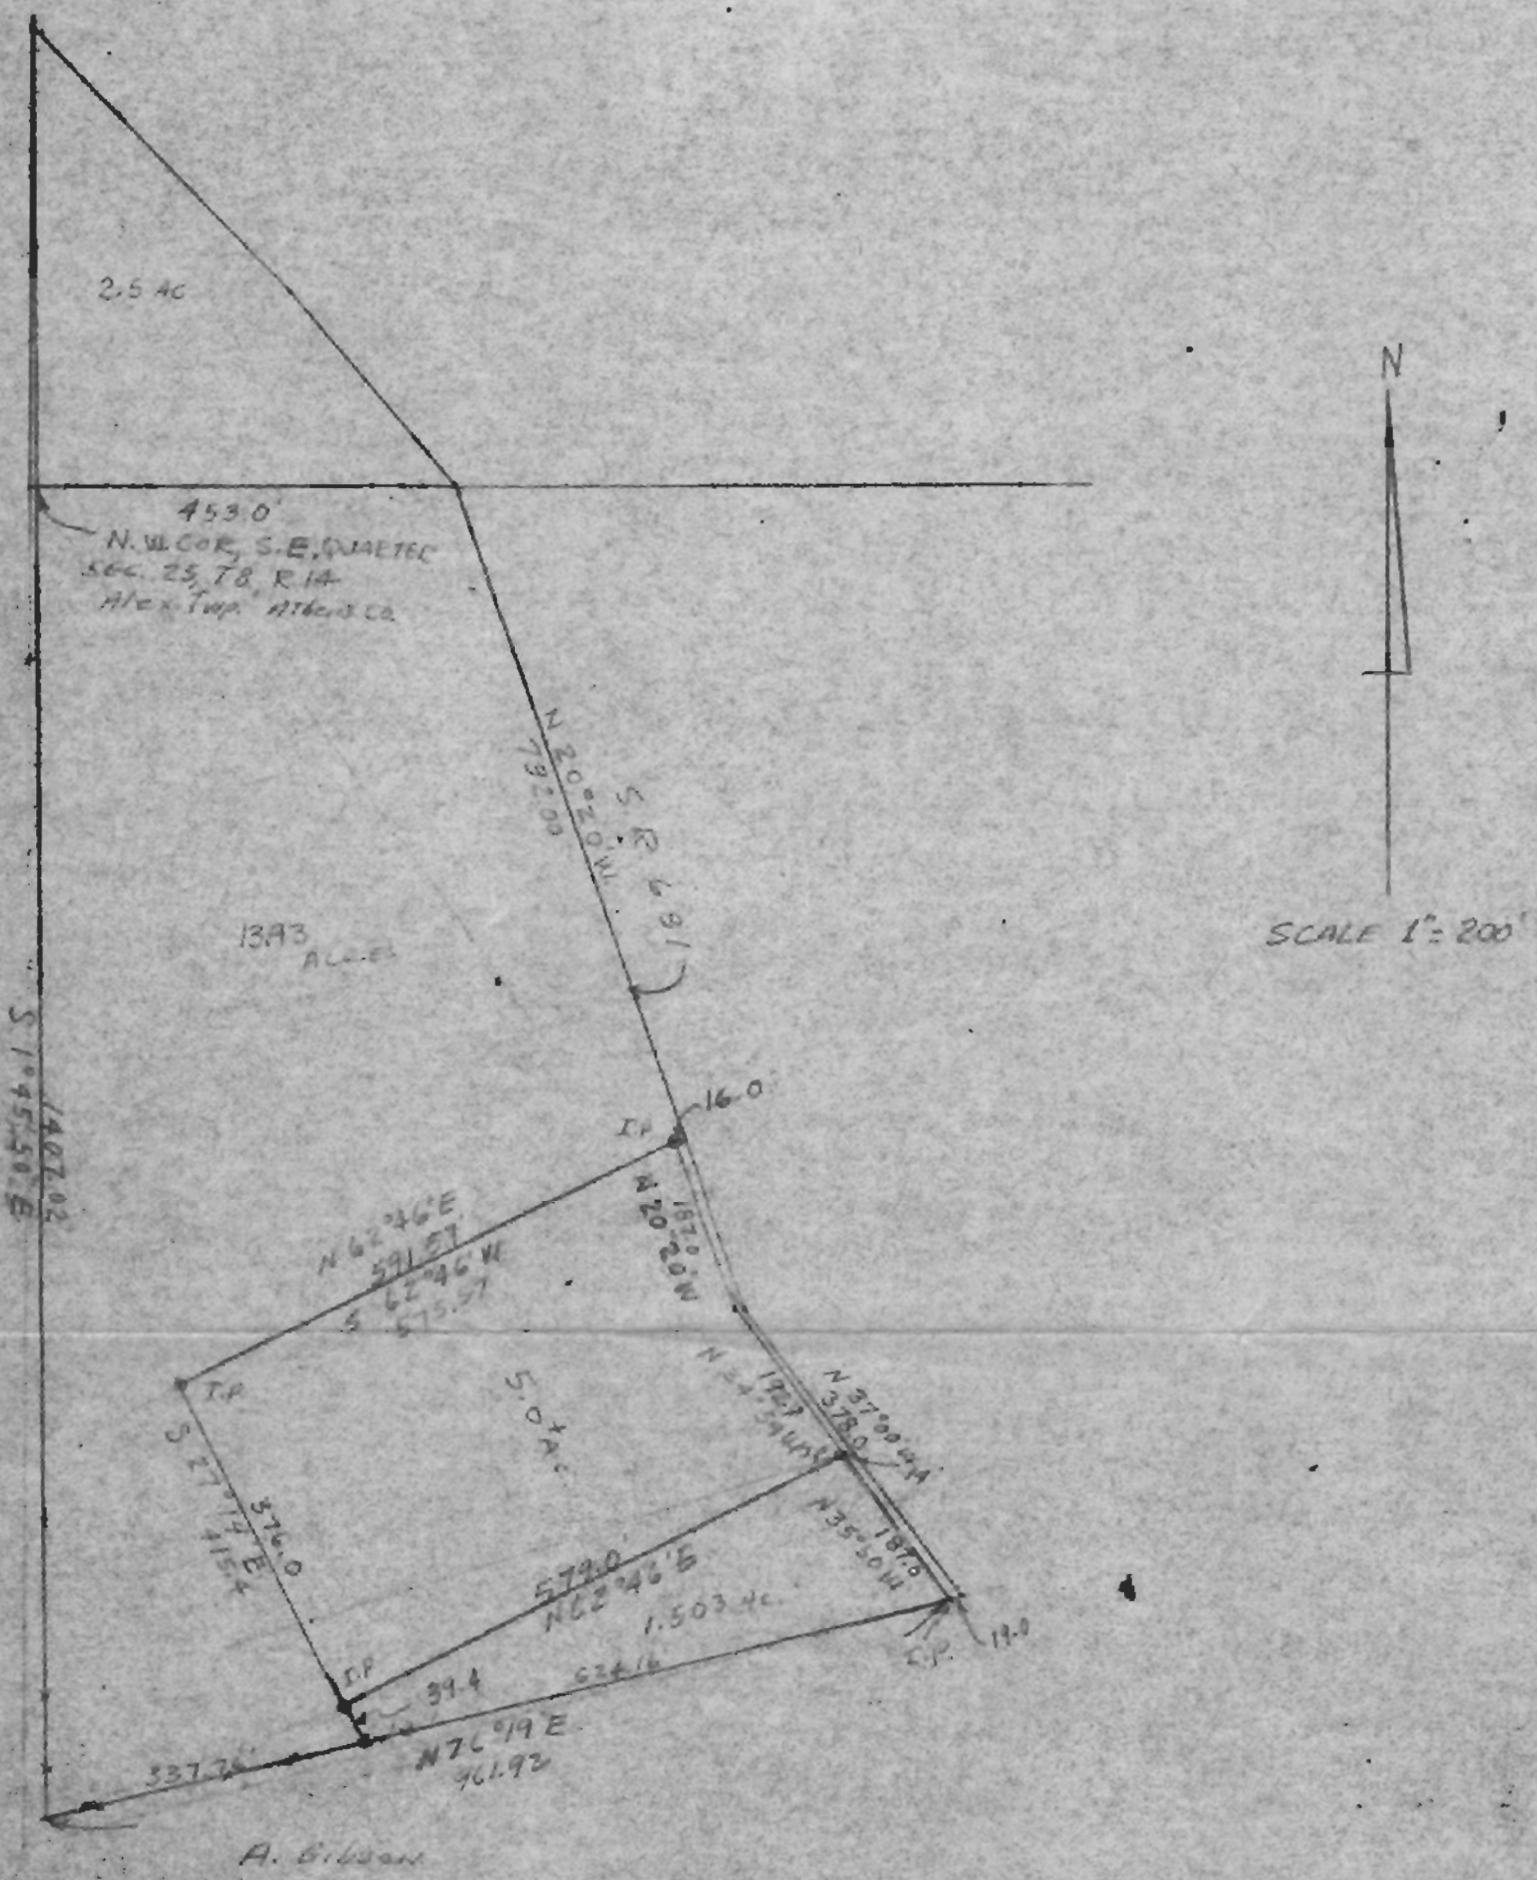

SURVEY OF A 5.00 AC. TRACT, A 1.5 AC. TRACT & A 13.93 AC. TRACT
IN THE S.W. QUARTER SEC. 25, T.8, R.14, ALEXANDER TOWNSHIP,
ATHENS COUNTY, OHIO for JAMES ZONAS

SURVEYED JUNE 1971 by HAROLD D. WHALEY

Harold D. Whaley
REG. SURV. NO. 4990

(39)