


sec 33  
 Amer SE  
 303-715  
 0.7 AC (WW)

Sec. 33

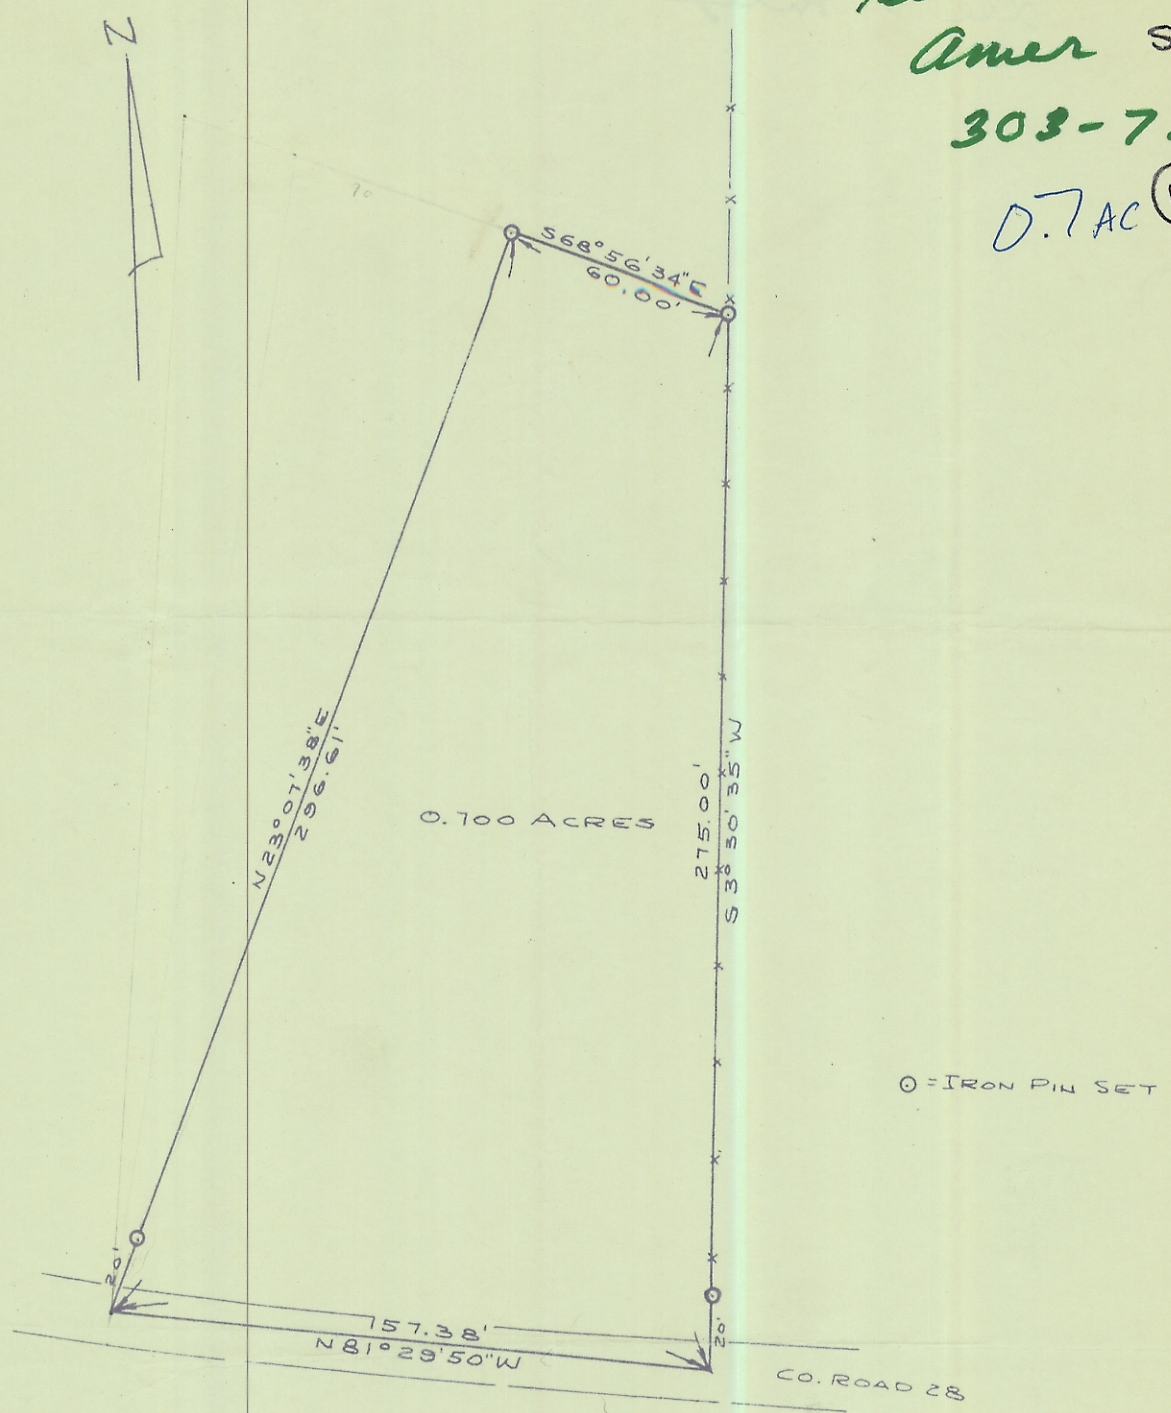

○ = IRON PIN SET

PLAT OF SURVEY  
 FOR  
 LEE PHILLIPS  
 LOCATED IN SECTION 33, AMES TOWNSHIP  
 T6-R13, ATHENS CO., OHIO  
 BY  
 EVANS, MECHWART, HAMBLETON & TILTON, INC.  
 ATHENS, OHIO  
 CONSULTING ENGINEERS & SURVEYORS  
 William H. Watkins  
 REGISTERED SURVEYOR #5216

JUNE 1971

SCALE: 1" = 50'