Description Checked for
Mathematical Accuracy
Athens County
ENGINEER'S OFFICE
EV. Security fulliand

DESCRIPTION OF A 0.33 ACRE TRACT

Situated in L.L. 112, Section 24, T.9, R.14, Athens Township, Athens County Ohio and being part of a tract of land as described in Volume 489, Page 2451 of the Official Records of Athens County and being more particularly described as follows:

Beginning at an existing iron pin found at the Easterly most corner of the Maiorana 0.286 acre tract (512-1908 O.R.), said pin bears South 17 degrees 13 minutes 44 seconds East, 770.75 feet from the North-east corner of Lot 841 of the Cottingham's Addition to Verity;

Thence, along the line of Gamertsfelder Trustee (354-313 O.R.)

North 37 degrees 22 minutes 40 seconds East, 63.96 feet to an iron pin found at the Westerly most corner of The Archaeological Conservancy (424-1876 O.R.)

Thence, along the south-line of The Archaeological Conservancy (424-1876 O.R.)

South 47 degrees 19 minutes 26 seconds East, 70.30 feet to an iron pin set;

Thence, along a new line created by this survey:

South 37 degrees 17 minutes 36 seconds west, 202.84 feet to an iron pin set;

Thence, along the North Right of Way Line of East First Street;

North 52 degrees 19 minutes 06 seconds West, 70.30 feet to an iron pin found;

Thence, leaving said right of way and along the line of Maiorana (512-1908 O.R.)

North 37 degrees 22 minutes 40 seconds East, 145.00 feet to the point of beginning and containing 0.33 acres

Subject to all easements and rights of way of record.

Iron pins set are 5/8 inch by 30 inch long rebar w/ plastic I.D. Cap stamped Branner P.S. 6805

Bearing: Grid North- N.A.D. 83

The above description is based on a field survey completed January 2017 John M. Branner P.S. 6805


ya.

Legal Description Pre-Approval
APPROVED

All transfers are subject to Athens County Conveyance Standards

JAN 06 2017

Jill Thompson Athens County Auditor

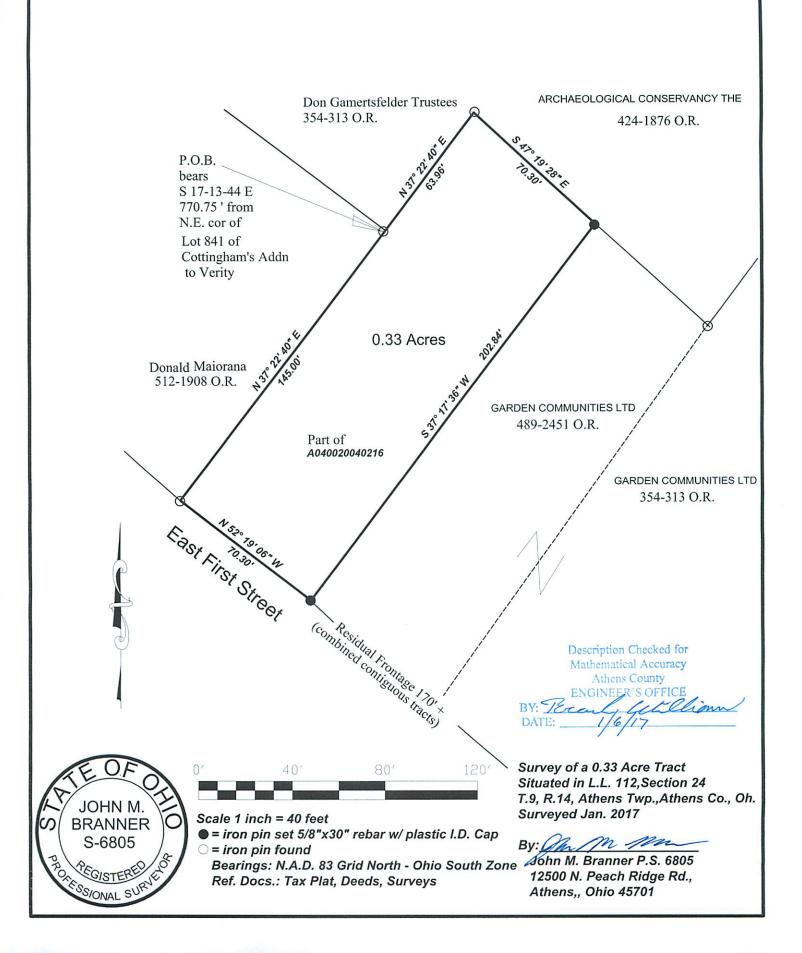



LOTSPLIT/LAND TRANSFER PERMIT

CITY OF ATHENS, OHIO ATHENS CITY CODE TITLE 23

Permit #: LS17-000001

Issue Date: 01/17/2017

Permit Type: Minor Issue Date: 01/17/2017 Description: Lotsplit 0 East First Street (aka 0 Johnson Road) Approval Conditions/Notes: Your lot split is approved in accordance with the Application submitted and Athens City Code Title 21. Location: Lot: 112 Section: 24 Town: 9 Range: 14 Township: Athens Applicant: John Branner Branner Surveying 12500 N. Peach Ridge Road Phone: Athens, OH 45701 Property Owner: Garden Communities LLC 12500 North Peach Ridge Road Phone: 740-541-0350 Athens, OH 45701 Surveyor Name: John Branner Registration #: P.S. 6805 Date property owner originally purchased the property: 09/10/2013 Acreage of original purchase: 0.66 contiguous w 1.00 AC Number and size of parcels subdivided since original purchase: Acreage of proposed parcel(s) with new plat of survey attached: 0.33 Public road frontage of proposed parcel(s): 70.30' Residual: 170'+ w contiguous 1.99AC Date of survey of plat of proposed parcel(s): 01/06/2017 Approval date of health authority of jursidiction for sewage disposal: The Plains -Sewer & Water Approval date of County Engineer for mathmatical accuracy of survey: 01/06/2017 Minimum Requirements: Public Road Frontage: Engineer's Approval: Width to Depth Ratio: 210.9 Health Department Approval:

Total Fees: \$80.00

Service-Safety Director recommendation:

[X] Approved

Number of Splits Permitted:

[] Refused

Paula Horan Moseley
Service-Safety Director

Date

Registered Surveyor: