

DESCRIPTION OF 0.1705 ACRES

Situated in Inlot 15 and 17 in the City of Athens, Athens Township, Athens County Ohio and being more particularly described as follows:

Beginning at a drill hole set in concrete on the southwest corner of said Lot 15 thence along the west line of Lot 15 north 0° 02' 54" west 25.41 feet to a P.K. Nail set; thence leaving the west line south 89° 55' 24" east 166.67 feet to a one-half inch square punch set on the west line of North College Street; thence along the west line of North College Street south 0° 04' 42" east 33.00 feet to a point where a iron pin bears south 89° 53' 31" east 22.00 feet; thence leaving the west line of College Street north 89° 53' 31" west 79.50 feet to a drill hole set in concrete; thence south 0° 05' 31" west 49.90 feet to a drill hole set in concrete; thence north 89° 49' 22" west 45.06 feet; thence north 0° 02' 54" west 57.35 feet to a drill hole set in concrete on the south line of Lot 15; thence along the south line of Lot 15 north 89° 53' 31" west 42.00 feet to the point of beginning and containing 0.1705 ACRES. 0.0974 acres being in Inlot 15 and 0.0731 acres being in Inlot 17.

Prior Deed Reference: Volume 242, Page 208 and Volume 150, Page 215, Athens County Deed Records.

Prepared by: Evans, Mechwart, Hambleton & Tilton, Inc.


August K. Knight
Registered Surveyor #6535

Description checked for
Mathematical Accuracy
ATHENS COUNTY
ENGINEER'S OFFICE

W. H. ...
DATE 6-27-53

156

ATHENS CITY (Q-23, R-23) SEE 9

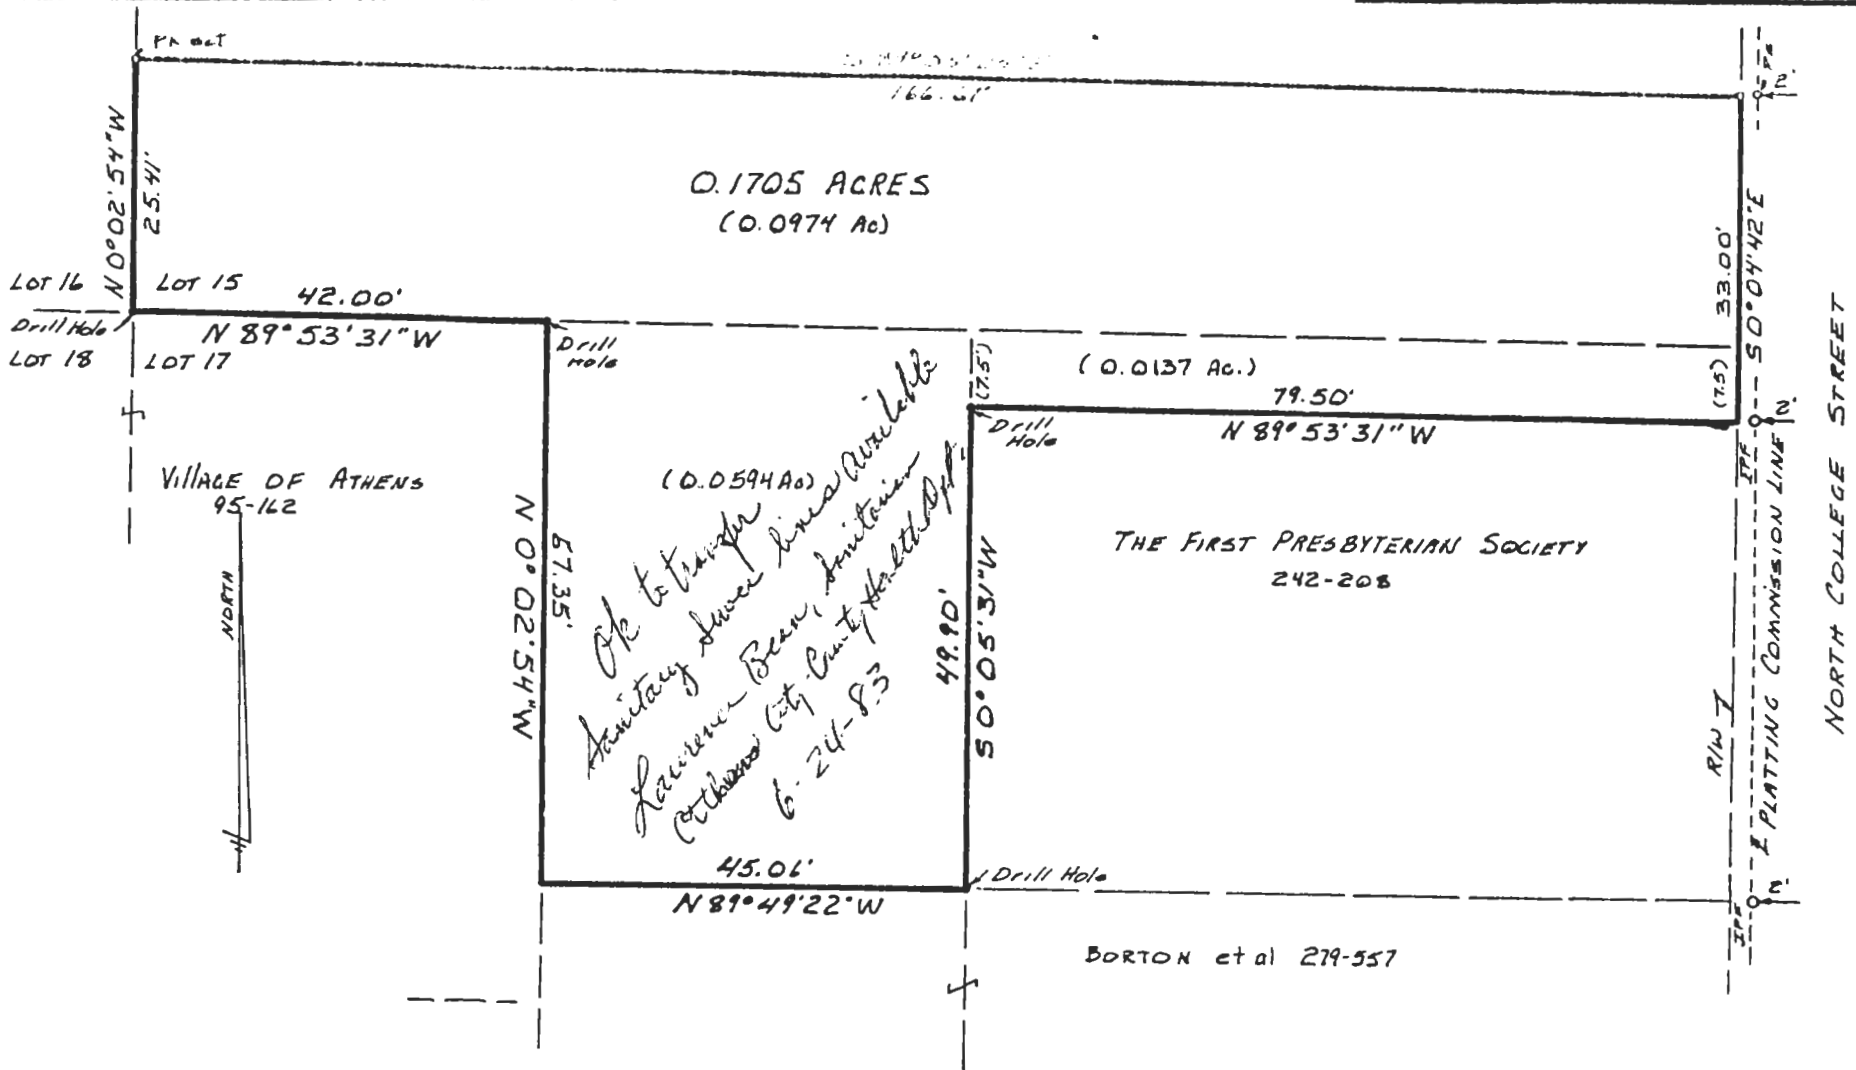

Description checked for
Mathematical Accuracy
ATHENS COUNTY
ENGINEER'S OFFICE

BY: *Charles M. Wright*
DATE: *5-27-83*

PLAT OF SURVEY
0.1705 ACRES
LOCATED IN INLOTS 15 AND 17, IN THE
CITY OF ATHENS, ATHENS COUNTY OHIO
SCALE 1" = 20' January 7, 1983

FOR THE CITY OF ATHENS
PREPARED BY
EVANS, MECHWART, HAMBLETON & TILTON, INC.
GAHANNA, OHIO ATHENS, OHIO
Gregory K. Wright
Registered Surveyor 16535



157
AO-1398