

SOUTHEASTERN LAND SURVEYS

LEONARD F. SWOYER
REGISTERED PROFESSIONAL LAND SURVEYOR

3428 Pleasant Hill Road Athens, Ohio 45701 614/593-8701

Situated in Farm Lot 156, Section 31, Town 9, Range 14, Athens Township, Athens County, Ohio and described as follows:

Commencing at a set iron pin at the northwest corner of Lease Lot 155 of said Section 31 of Athens Township, said set iron pin is THE TRUE POINT OF BEGINNING; thence along the north line of said Lease Lot 155 on an assumed bearing of South 89°41'48" East 39.44 feet to a set iron pin; thence leaving the said north line of Lease Lot 155 North 30°21'38" West 907.92 feet to a found iron pin; thence North 89°11'38" West 223.62 feet to a iron pin;* thence South 00°48'22" West (passing a square head bolt at 351.75 feet*) for a total distance of 380 feet to a point in the center of Athens Township Road 29; thence along the center of said Athens Township Road 29 the following five bearings and distances:

1. South 65°13'38" East 94.46 feet to a point; 2 thence South 61°04'38" East 298.35 thence feet to a point; 3. \(\times \) South 47°38'38" East 240.97 feet to a point; 4. thence South 39°14'38" East 136.79 feet to a point; 5. thence South 25°02'05" East 87.18 feet to a point; thence leaving the said Athens Township Road 29 and along the east line of Lease Lot 156 North 0°00'01" West (passing a set iron pin at 41.53 feet) for a total distance of 124.77 feet to the point of beginning containing 5.179 acres and being a correction of a deed described in Volume 384 Page 229 of the Athens County Deed Records.

* refers to a calculated location based on a description prepared by William M. Watkins Registered Surveyor Number 5216 and recorded in Volume 73 Page 269 of the Athens County Deed Records.

Note: Unless otherwise noted all set iron pins are 5/8 inch diameter rebar 30 inches in length and capped with a plastic identification marker inscribed L.F. Swoyer R.L.S. 6765.

The above description was written by Leonard F. Swoyer Registered Professional Land Surveyor Number 6765 and based on a survey prepared by Southeastern Land Surveys dated June 8, 1990.


Subject to all easements and right of ways of record Description checked for

Mathematical Accuracy
ATHENS COUNTY
ENGINEER'S OFFICE Accuracy

SUBDIVISIONS

CONSTRUCTION

PROPERTY

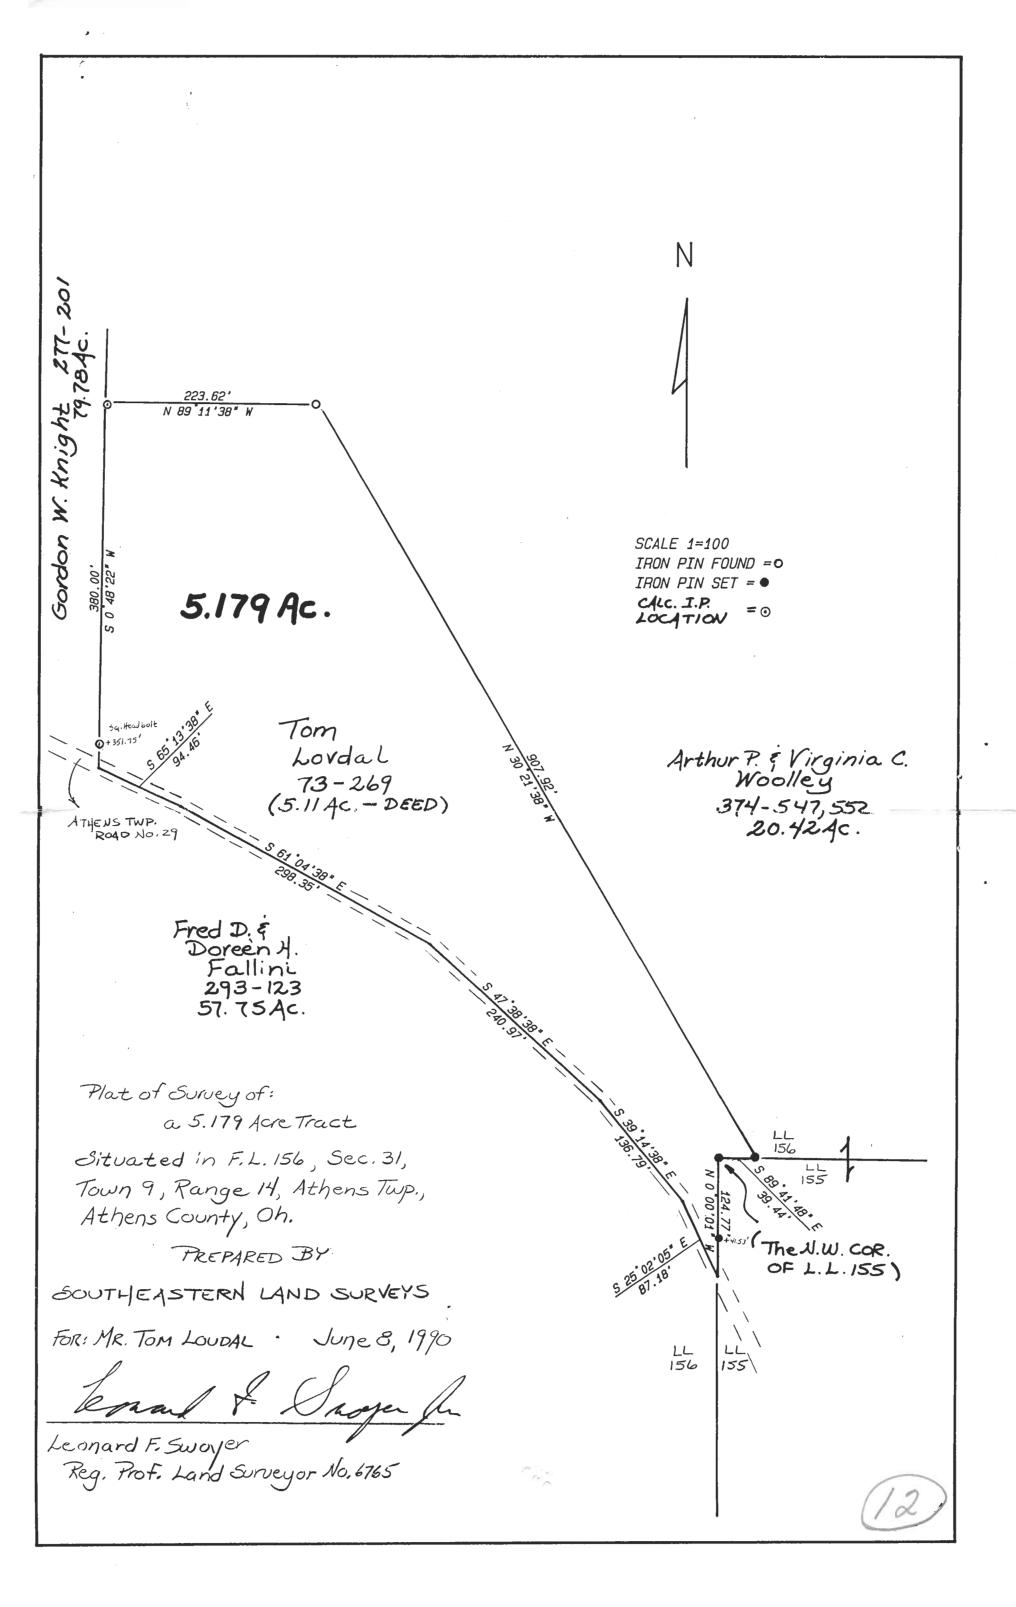

Line.