




SOUTHEASTERN LAND SURVEYS

LEONARD F. SWOYER
REGISTERED LAND SURVEYOR

Box 208A
Route Five
Athens, Ohio 45701

Willard H. Elsbree
257-186 1.22 Ac.

Robert L. Detty et al.
42-708 1.14 Ac.

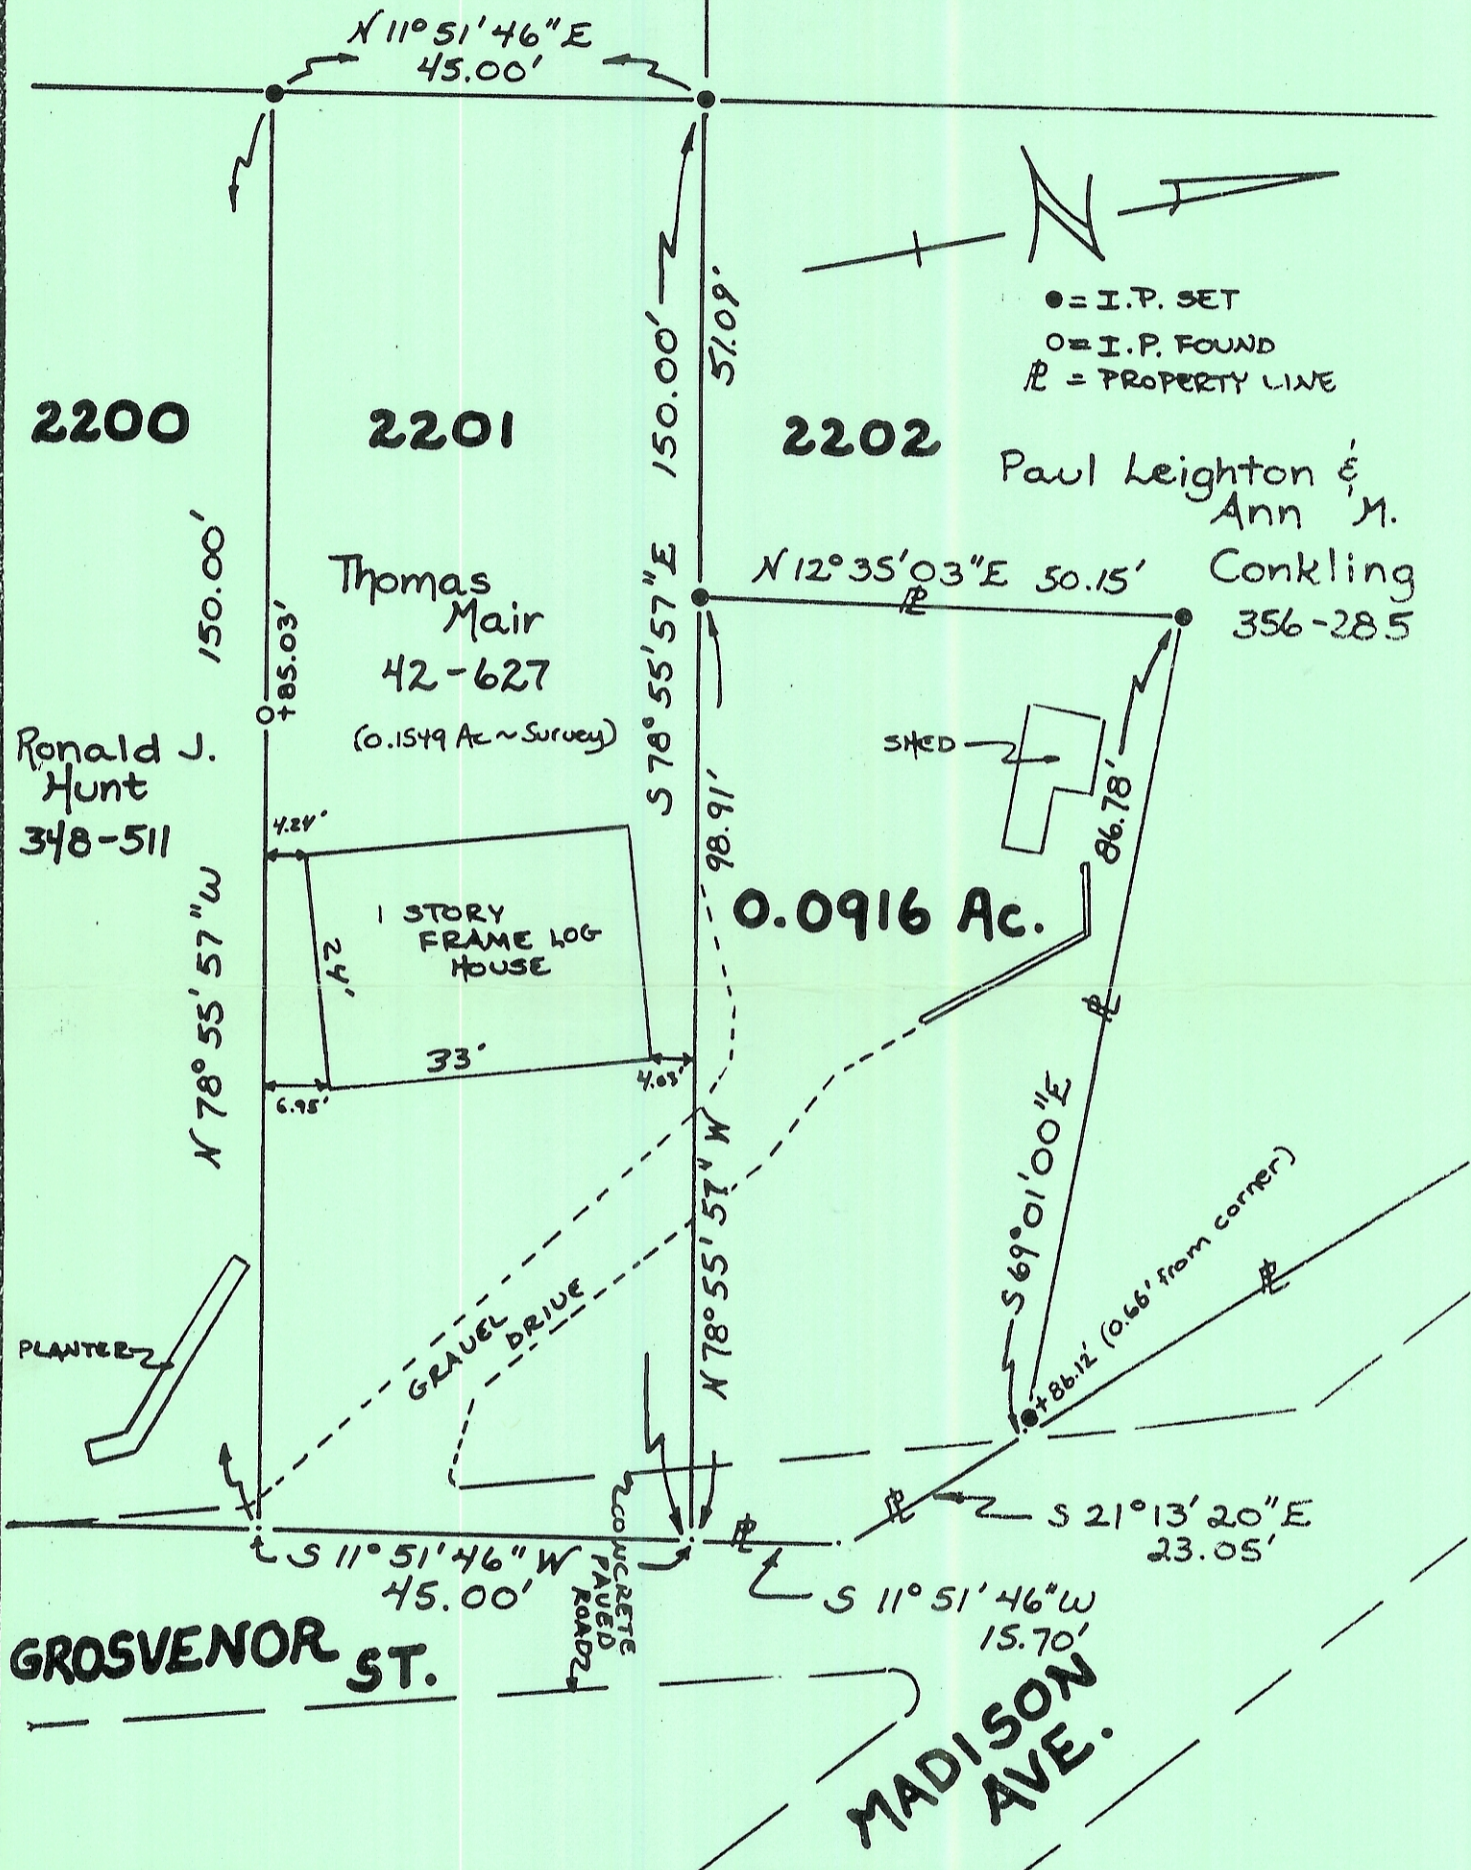

Plat of a 0.0916 Acre Tract out of Lot 2202 Scale 1" = 20'

Surveyed for Lila Golos Date 10/31/88

Subdivision Highland Park Addition, F.L. 45

Township Athens Section --- Town --- Range ---

Corporation Athens County Athens State Ohio

Leonard F. Swoyer

Leonard F. Swoyer II Reg. Prof. Land Surveyor No. 6765