

AC
10
11 85
11 199
N-25

Athens City

86

85

199


SURVEY FOR

WEIHR ESTATE

INLOTS 85 & 199 - ATHENS, O.

Georgel, Clark
Reg. Surv. 2314

Scale 1" = 30'
Dec 21, 1950

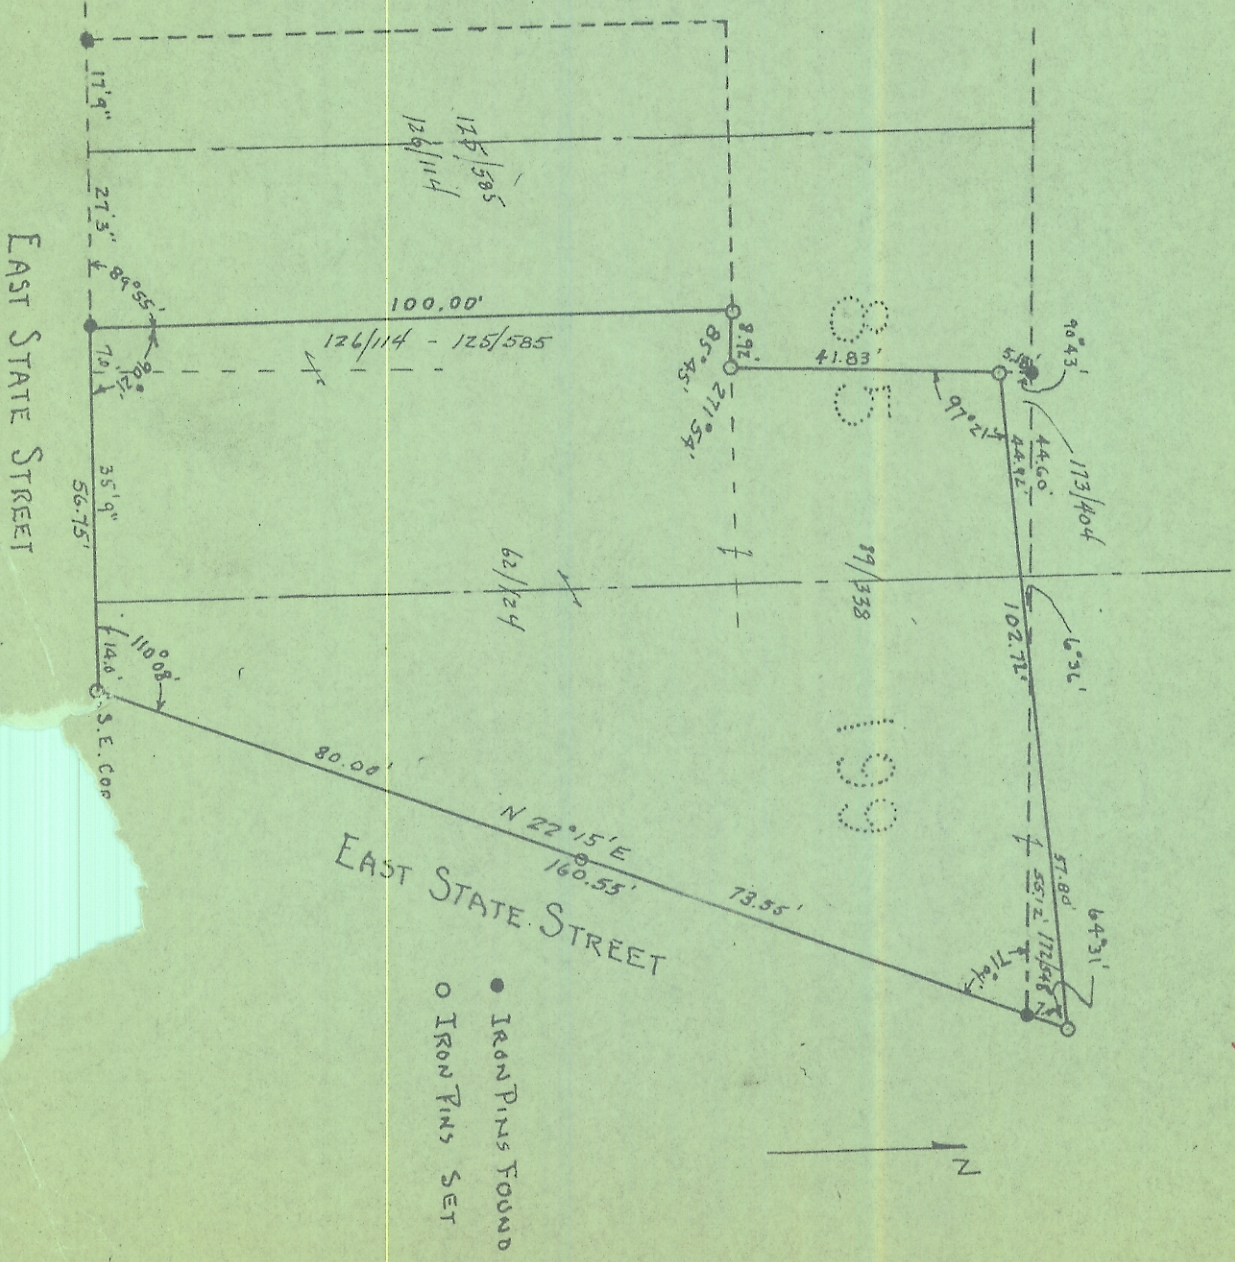

EAST STATE STREET

EAST STATE STREET