


SCALE: 1" = 30'



**LEGEND**

- IPF ~ IRON PIN OR PIPE FOUND
- IPB ~ IRON PIN OR PIPE SET
- GM ~ GAS METER
- G ~ GAS LINE # SIZE
- CB ~ CATCH BASIN
- MH ~ MANHOLE
- WM ~ WATER METER
- WB ~ WATER VALVE BOX
- FHYR ~ FIRE HYDRANT
- W ~ 8" ~ WATER LINE # SIZE
- R/W ~ RIGHT-OF-WAY
- B/W ~ BACK OF WALK (SIDEWALK)
- F/C ~ FACE OF CURB
- E.P. ~ EDGE OF PAV'T.
- H.D. ~ HOUSE DROP (OVERHEAD)
- P ~ OVERHEAD POWER (ELECTRIC)
- T ~ OVERHEAD TELEPHONE
- TV ~ OVERHEAD TELEVISION CABLE
- LP ~ STREET LIGHT POST
- U.P. ~ UTILITY POLE

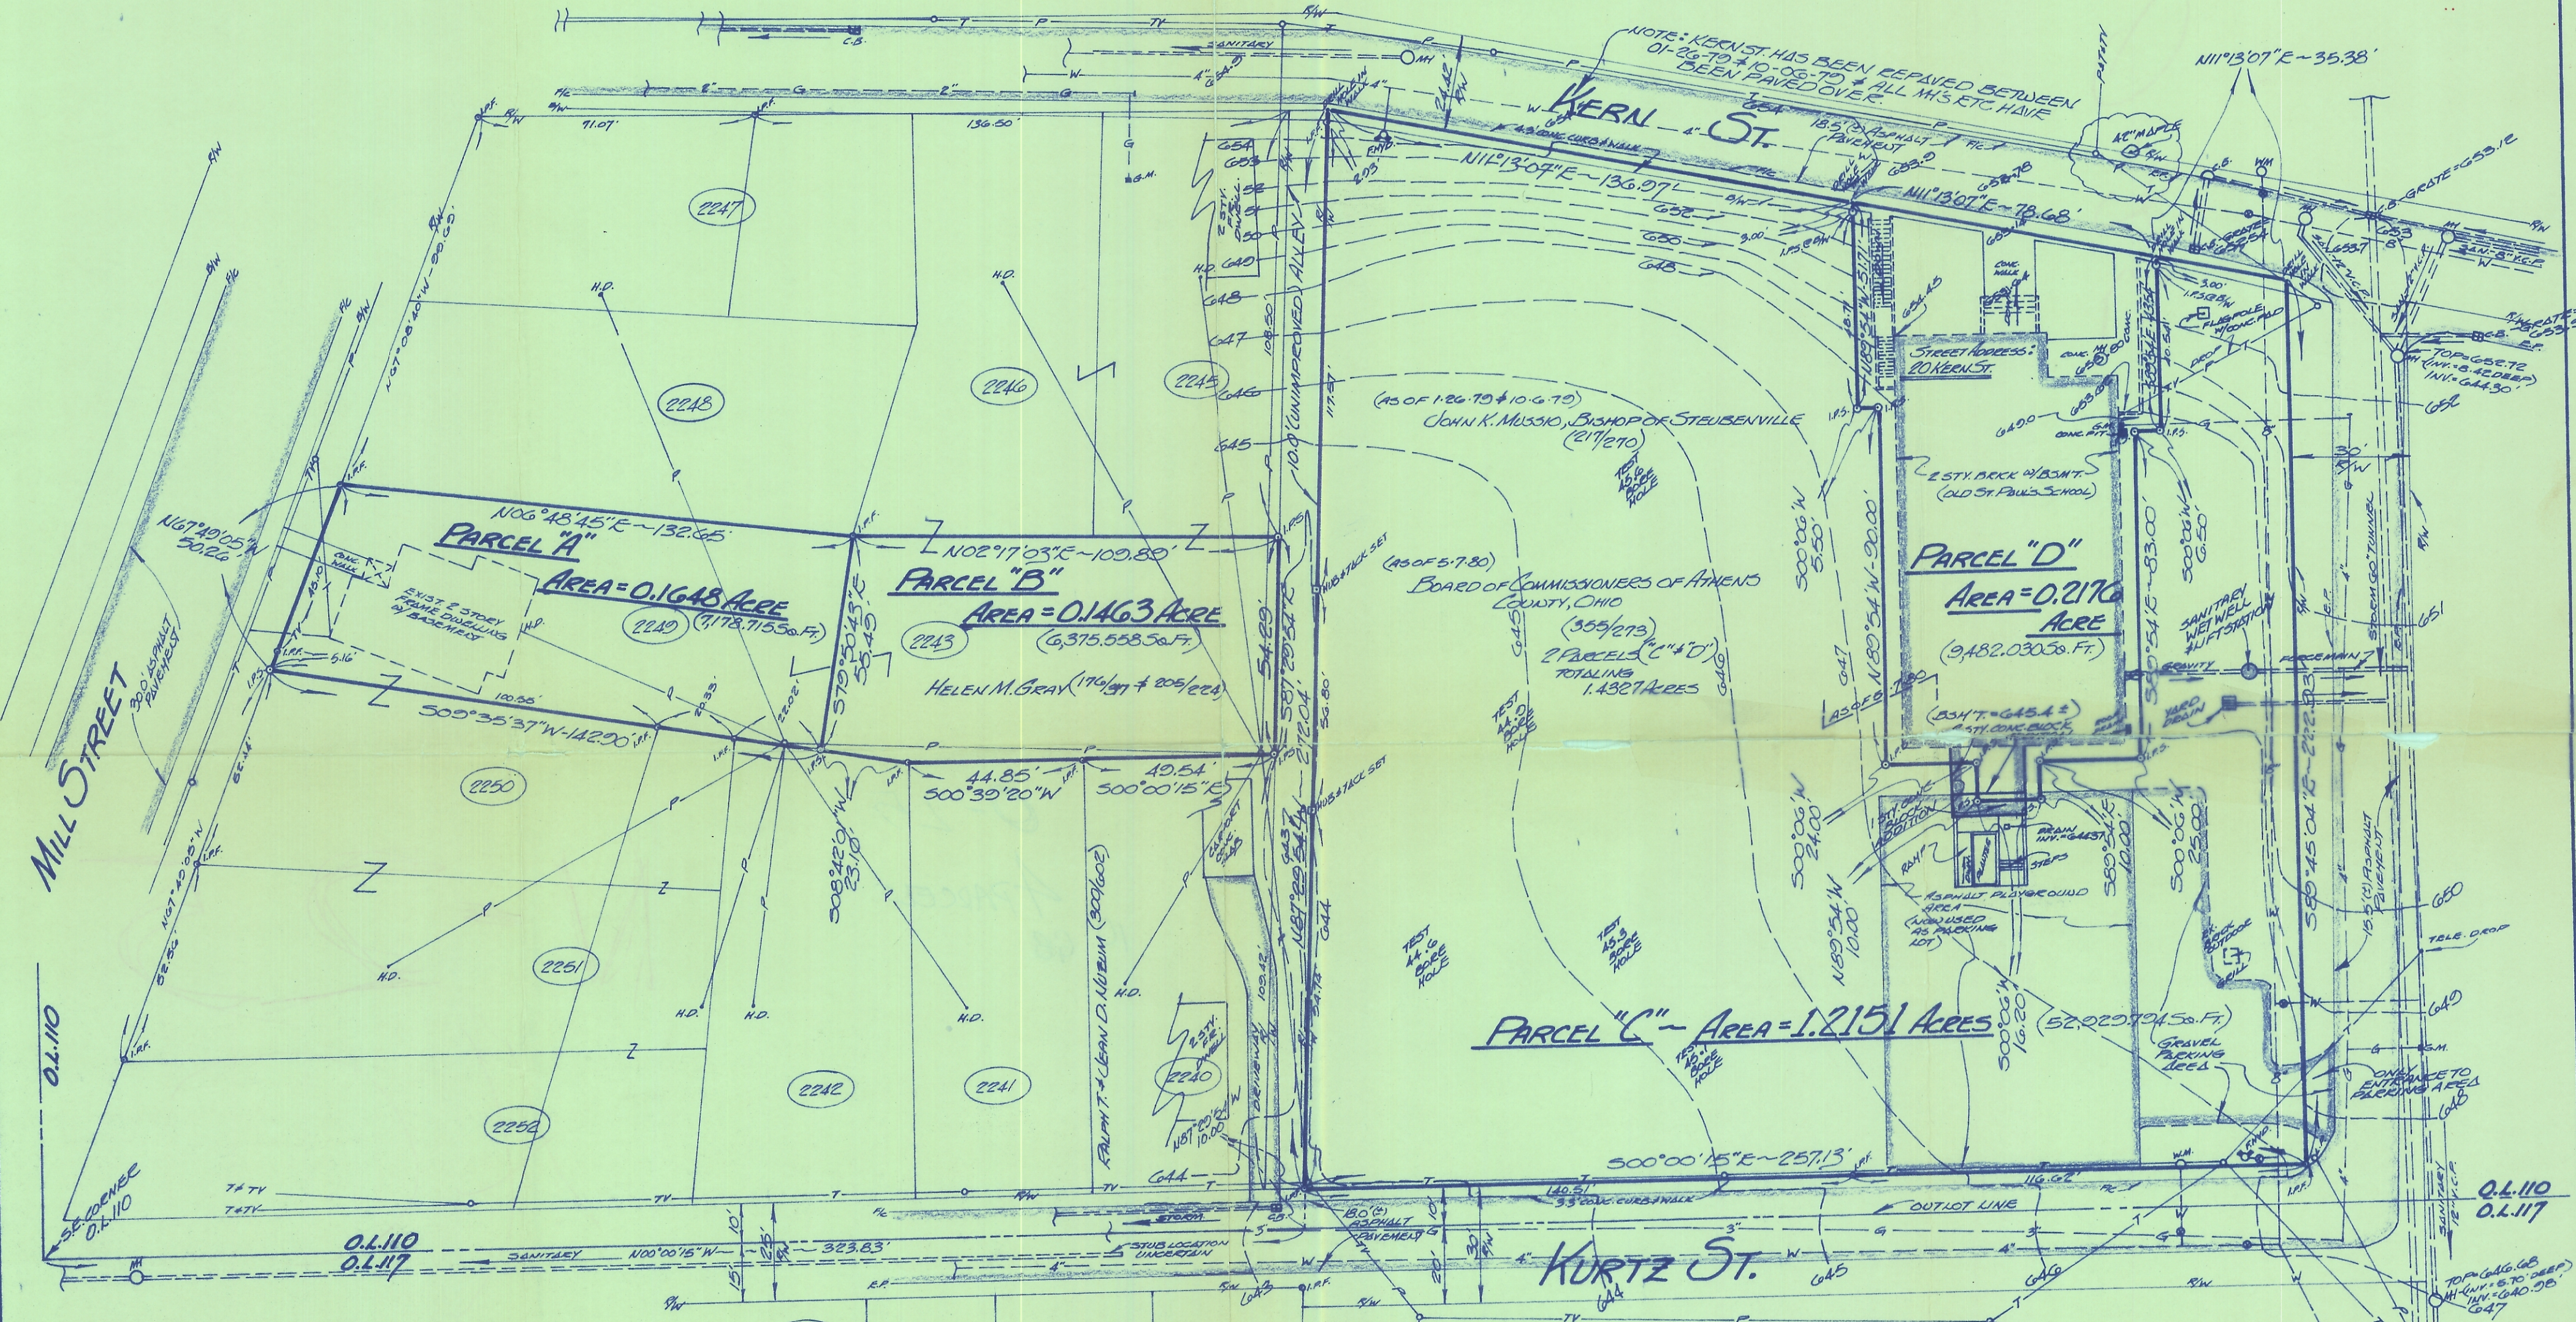

**UTILITY OWNERS**


SEWERS (STORM & SANITARY) & WATER: CITY OF ATHENS, CITY HALL, ATHENS, OHIO.  
 GAS (NATURAL): COLUMBIA GAS OF OHIO, U.S. RTE. 50 E, ATHENS, OHIO.  
 TELEPHONE: GENERAL TELEPHONE CO. OF OHIO, 16 W. WASH. ST., ATHENS, OHIO.  
 ELECTRIC: C. & S. O. E. CO., 100 S. MAY AVE., ATHENS, OHIO.  
 T.V. CABLE: CONTINENTAL CABLEVISION OF OHIO, INC., 1 MOUND ST., ATHENS, OHIO.

**NOTES:**

- 1) GAS LINES SHOWN HEREON WERE ELECTRONICALLY LOCATED BY A CREW FROM COLUMBIA GAS OF OHIO ON 23 JAN. 1979 @ 10:00 AM.
- 2) WATER LINES SHOWN HEREON ARE DEPICTED APPROX. BY A CREW FROM THE CITY OF ATHENS & EXACT LOCATION (± 2'-10") WILL HAVE TO BE DETERMINED BY EXCAVATION AT TIME OF CONSTRUCTION.

**Final Print**  
 MAY 06 1980

To All Parties Interested in the Title to the Premises Surveyed on this "PLAT OF SURVEY":  
 I, hereby certify that I personally made an actual survey of the premises shown hereon on 26 Jan. 1979 & again (to add top) on 6 Oct. 1979 (with final certification field check made by me on 7 May 1980) & that this "PLAT OF SURVEY" is a correct representation of the premises as determined by said survey. I further certify that there are no encroachments, either way, across any boundary line of the premises, except as shown hereon, signed at Athens, Ohio, this 5th day of May, 1980.  
 Gerald W. Bayha, Registered Professional Surveyor

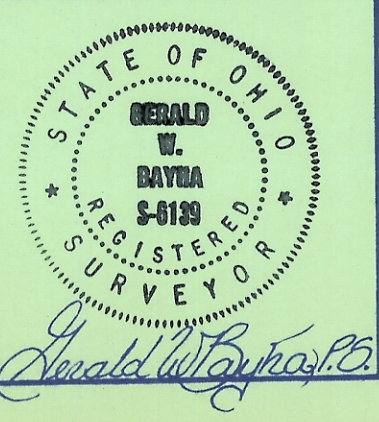

FOR: **ATHENS COUNTY BOARD OF COMMISSIONERS**  
 Athens County Court House (Annex)  
 300 W. WASH. ST.  
 ATHENS, OHIO 45701

BY: **GERALD W. BAYHA, P.S.**  
 Registered Professional Surveyor No. 5-6189  
 Route No. 5 - Box No. 204  
 (Pleasant Hill) Athens, Ohio 45701 - (614) 592-4308

**PLAT OF SURVEY**

OF (4) PARCELS SITUATE IN OUTLOT 110 & INLOTS 2243 & 2249 - SECTION 10 - T.9 N - R.14 W - ATHENS CITY - ATHENS TOWNSHIP - ATHENS COUNTY - OHIO - U.S.A.

Drawn	Checked	REVISIONS	DATE	Job No.
GB	GB	TOPOGRAPHY & DETAILS - 10-26-79 (BY GUY)	06 OCT. 1979	#179-02
			26 JAN. 1979 7 MAY 1980	

CERTIFICATION SITE VISITATION 5-7-80