


HIGHLAND SURVEYING

REGISTERED PROFESSIONAL LAND SURVEYOR

Description checked for
Mathematical Accuracy
ATHENS COUNTY
ENGINEER'S OFFICE

BY: *S. Blawie*
DATE: *9-29-98*

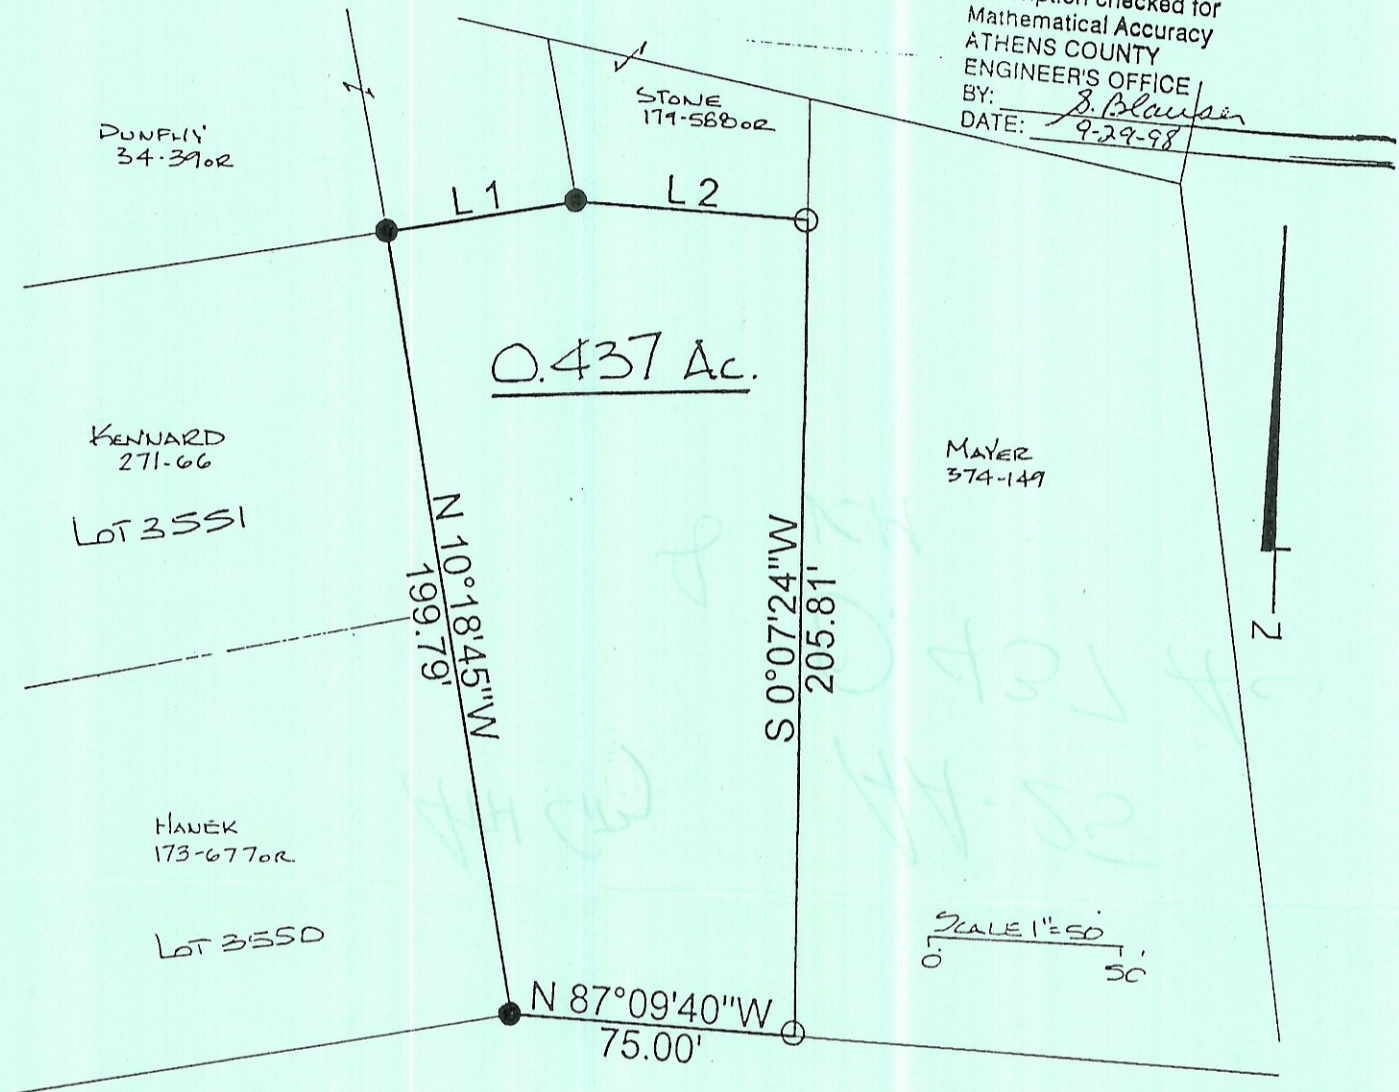

○ = Iron Pin Set

● = Iron Pin Found

Line	Bearing	Distance
1	N 80° 13' 26" E	50.50'
2	S 87° 09' 40" E	61.42'

PLAT of SURVEY OF A 0.437 AC. TRACT
 SURVEYED for DAVID STONE
 SUBDIVISION —
 TOWNSHIP ATHENS SECTION — TOWN — RANGE —
 CORPORATION ATHENS COUNTY ATHENS STATE OHIO
 SCALE 1" = 50' DATE SEPT. 1998

NOTE: THIS IS A TRANSFER
 BETWEEN ADJOINING OWNERS.
 THIS 0.437 ACRE TRACT MUST
 REMAIN UNDIVIDED AND
 CONTAIN LOT 3551



KENNETH E. HIGHLAND
 80 FAYETTE STREET
 NELSONVILLE, OHIO 45764
 614-753-1264

Kenneth E. Highland
 Kenneth E. Highland S-7581