


SOUTHEASTERN LAND SURVEYS

LEONARD F. SWOYER
REGISTERED PROFESSIONAL LAND SURVEYOR

3428 Pleasant Hill Road
Athens, Ohio 45701
614/593-8701

*OK to transfer
Athens City Co
Health Dept
Peter Connors
2-12-96*

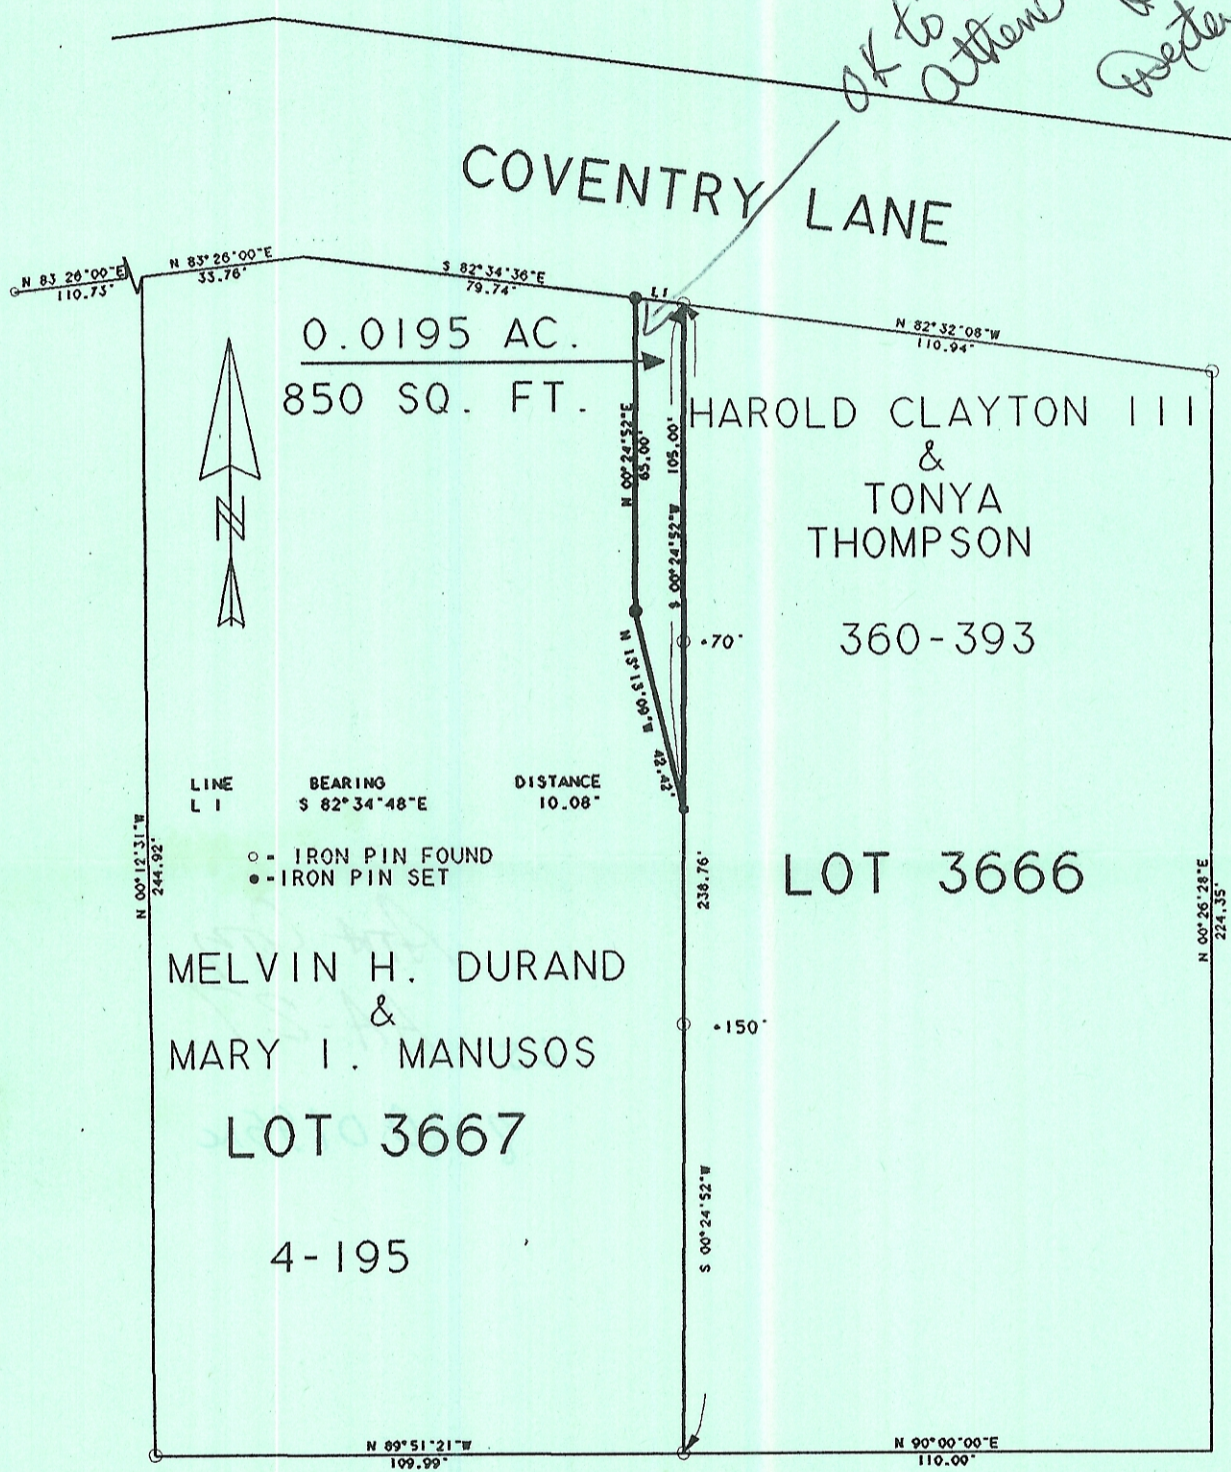

Plat of 0.0195 Ac. Scale 1" = 40'

Surveyed for Harold Thompson Date Jan. 23, 1996

Subdivision LaMar Heights 3rd Addition

Township Athens Section 8 Town 9 Range 14

Corporation Athens County Athens State Oh.

Leonard F. Swoyer Jr.

Leonard F. Swoyer Jr. Reg. Prof. Land Surveyor No. 6765