
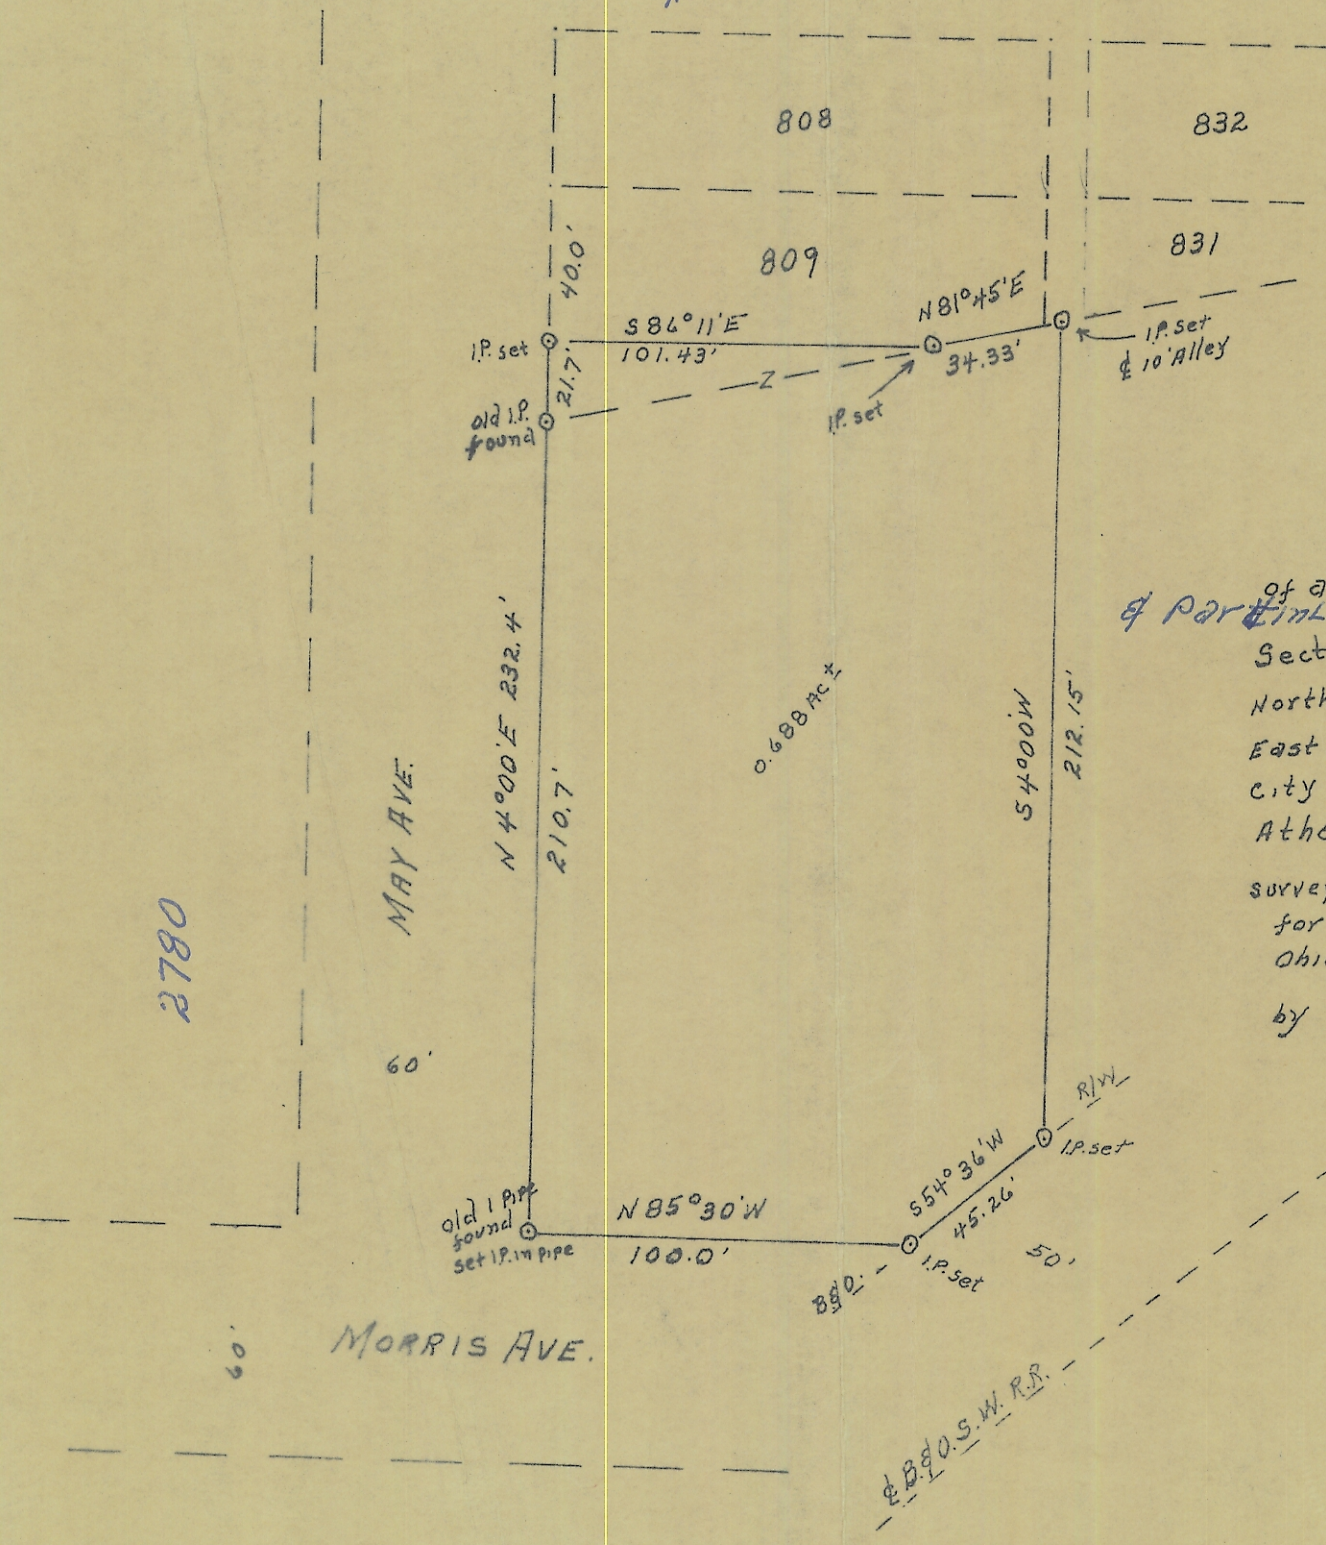


Sec 10
Athens City

Hudson Add.

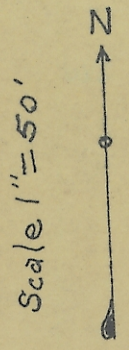

PLAT

of a part of F.L. 44
of part of Lot 809 - Hudson Add.
Section 10 T. 9, R. 14,
North of Morris Ave. &
East of May Ave. in the
City of Athens Ohio
Athens Twp.
surveyed 8-12-61
for Columbus & Southern
Ohio Electric Co.
by Joe L. Galvin
Reg. Sur. 1684.

