


160-172

Sec 24
Athens
305-179

Sec. 24

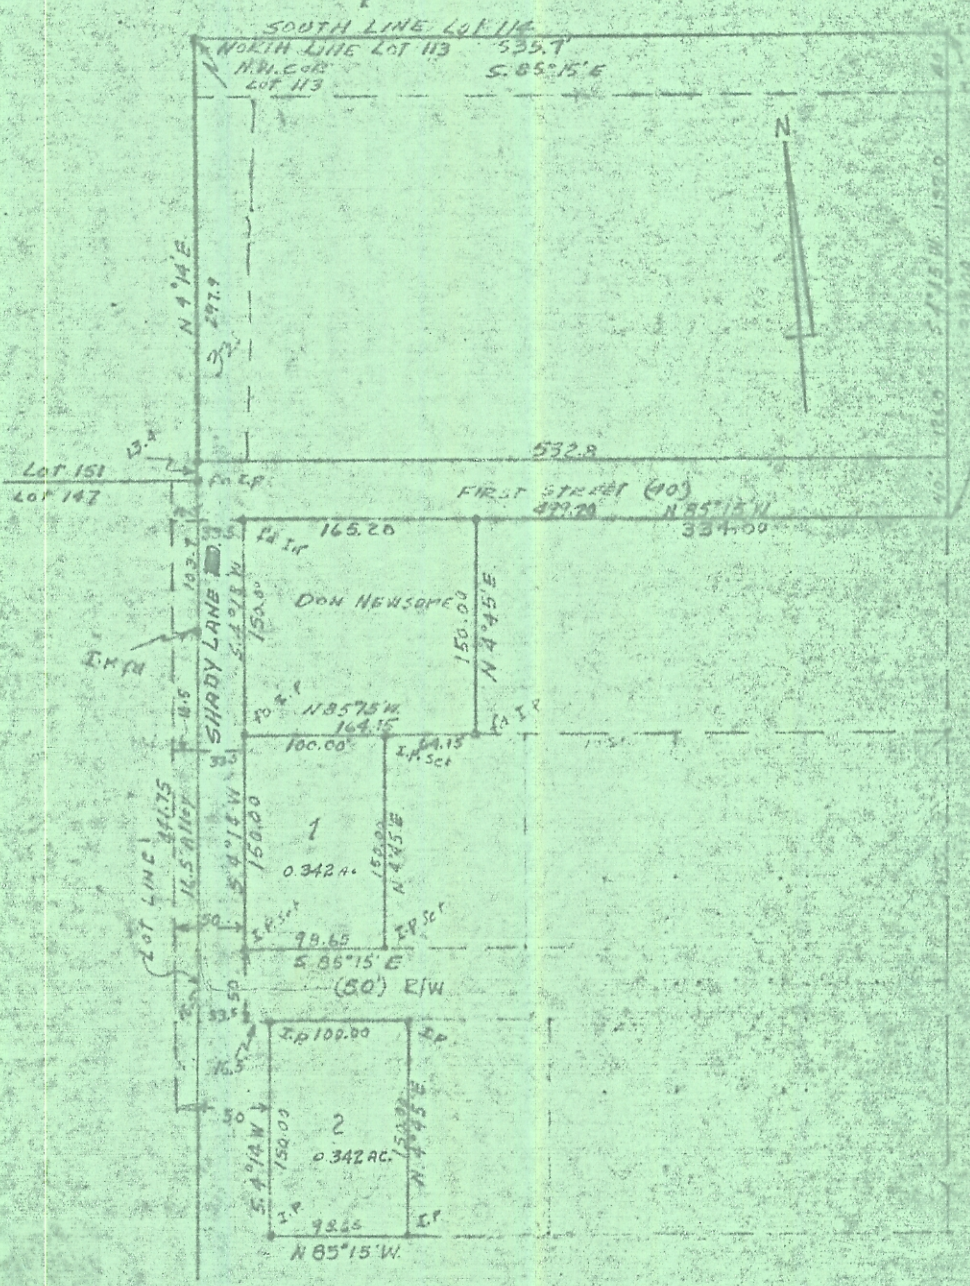

SURVEY OF TWO 0.342 AC TRACTS IN LEASE LOT NO. 113
 SEC. 24, T. 3, R. 14, ATHENS TOWNSHIP, ATHENS COUNTY, OHIO
 for E.A. COTTINGHAM

SURVEYED JULY 23, 1971 by HAROLD D. WHITLEY
Harold D. Whitley