




BEING A PART OF LOT 713 IN MICHAEL'S
SIXTH ADDITION TO THE VILLAGE OF
VERITY, SECTION 24, TOWNSHIP 9,
RANGE 14, ATHENS TOWNSHIP, ATHENS
COUNTY, OHIO.

SCALE: 1" = 50'
IRON PIN
FOUND

D. DAVIS

LOT 714

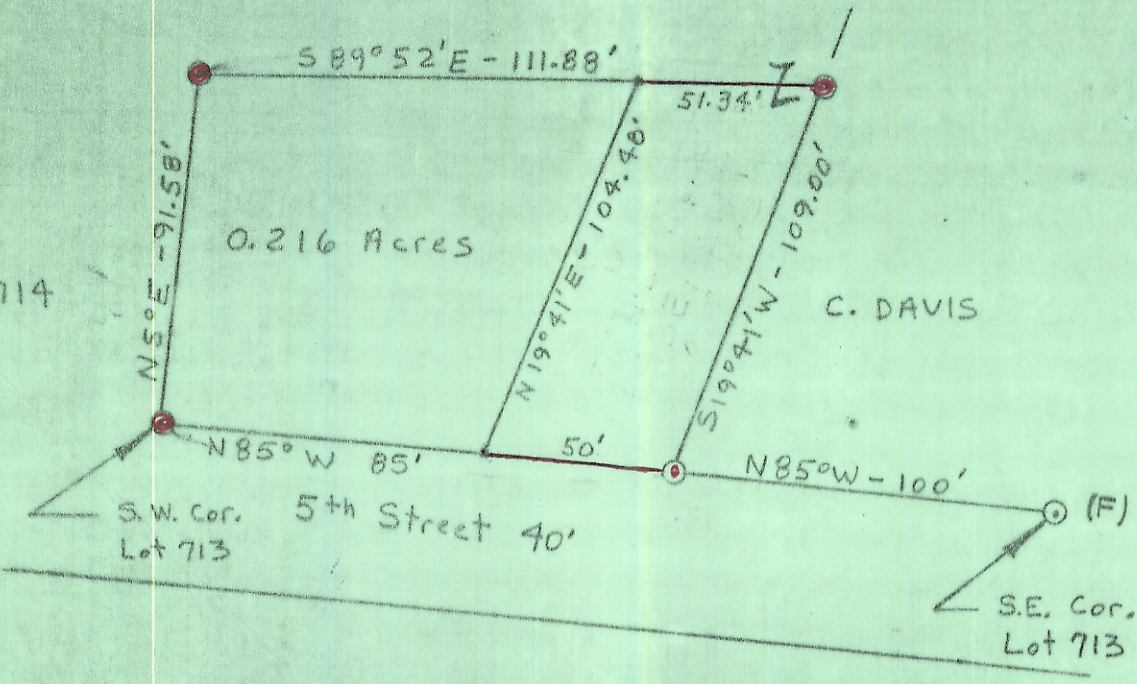

0.216 Acres

C. DAVIS

S.W. Cor.
Lot 713

5th Street 40'

S.E. Cor.
Lot 713

I HEREBY CERTIFY THAT AN ACTUAL SURVEY WAS MADE BY STEVEN C. SKINNER
UNDER MY SUPERVISION OF THE PREMISES SHOWN HEREON ON THE 4th DAY
OF AUGUST 1979 AND THAT THE PLAT IS A CORRECT REPRESENTATION OF
THE PREMISES AS DETERMINED BY SAID SURVEY.

Description checked for
Mathematical Accuracy
ATHENS COUNTY
ENGINEER'S OFFICE

Larry P. Geratner
REGISTERED SURVEYOR NO. 6344

BY: Charles McKinney
DATE: 6-9-81