


Sec 25  
Athens  
308-313

Sec. 25

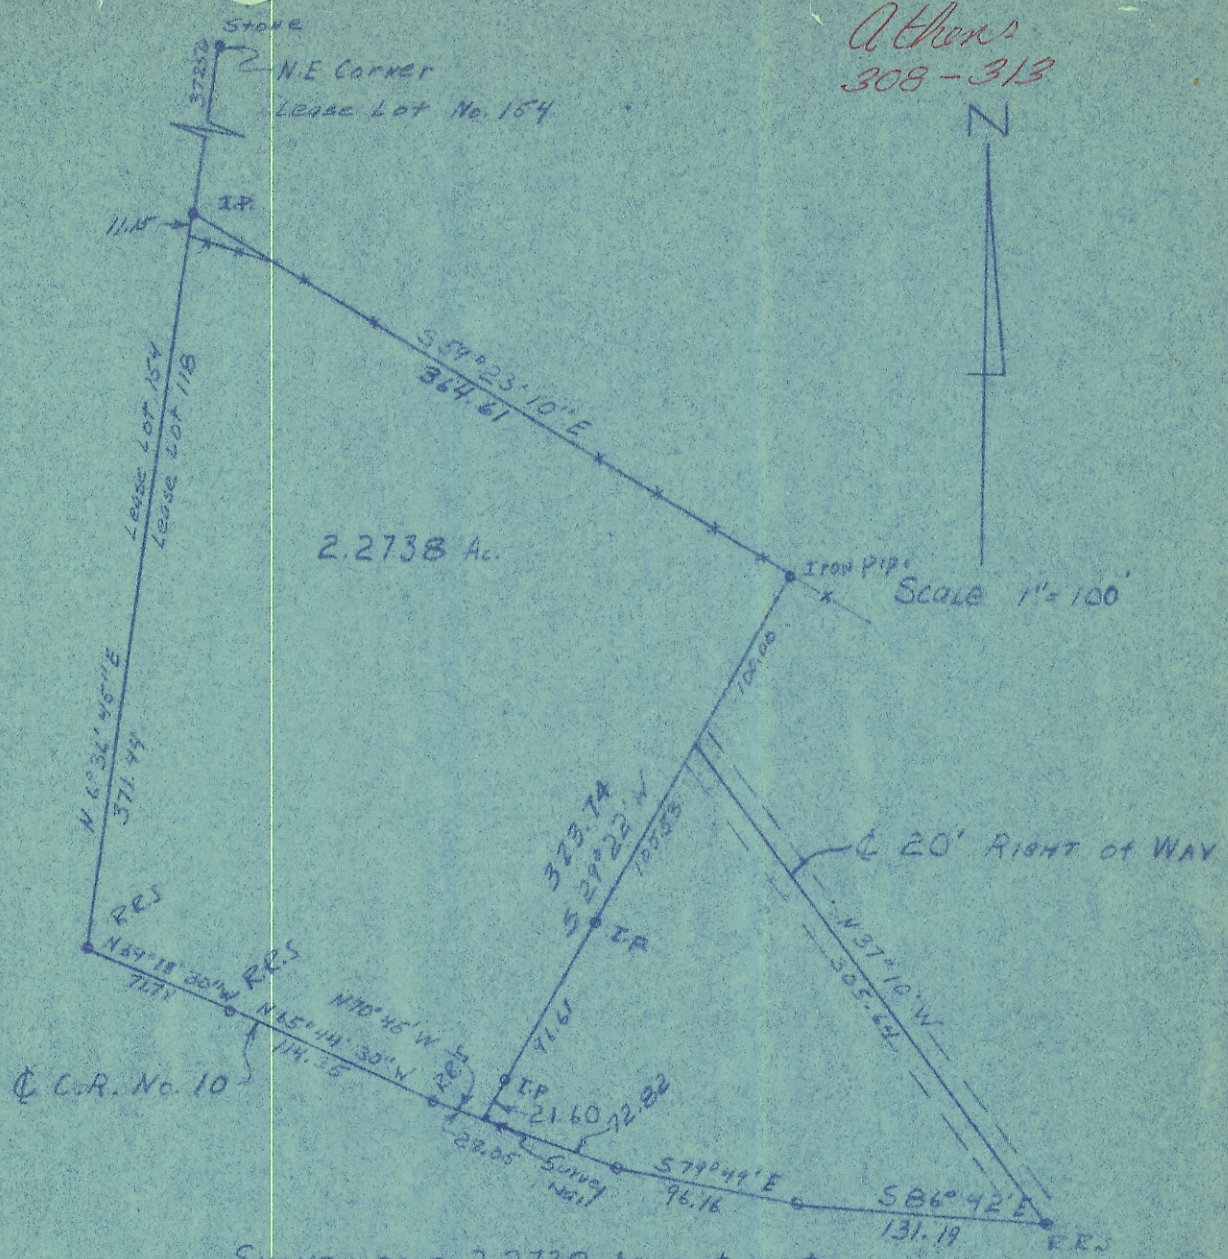

Survey of a 2.2738 Acre tract  
 Lease Lot No. 118, Sec 25, T.9,  
 R. 14, ATHENS TOWNSHIP, ATHENS Co., OHIO  
 FOR CARL CONROTH

Surveyed APRIL 11, 1912 by HAROLD D. WAMEY  
 Harold D. Wamey  
 Reg. Surv. No. 4986