


Sec 26  
Athens

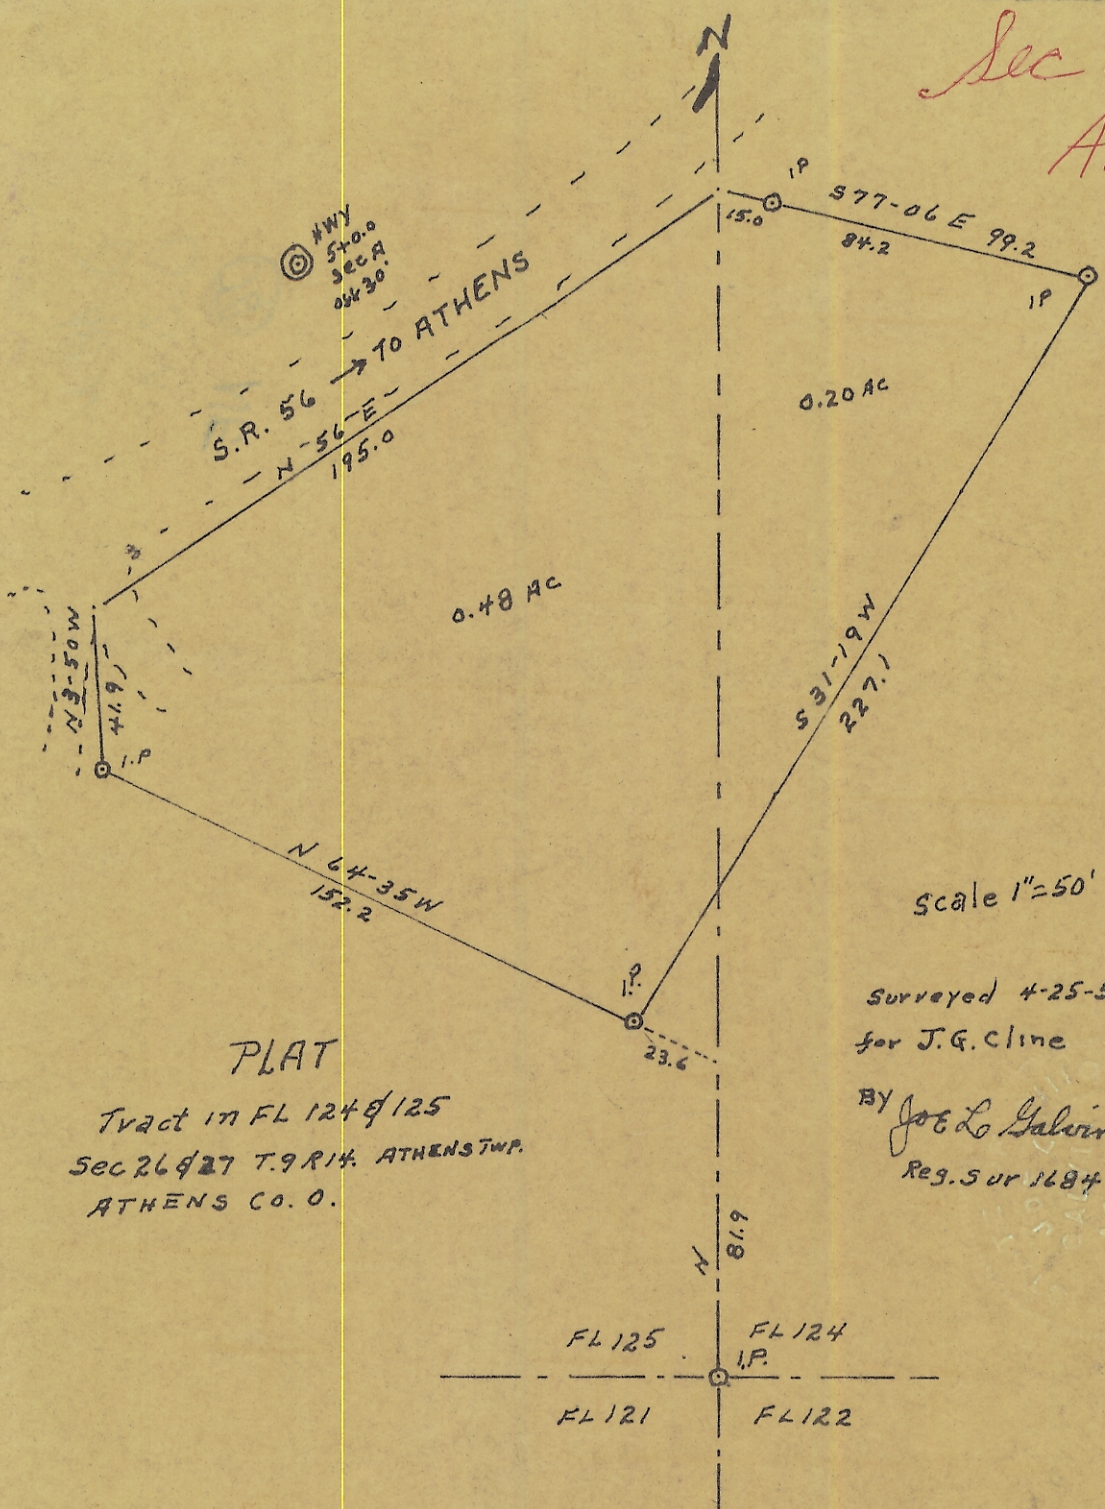


scale 1"=50'

Surveyed 4-25-58  
for J.G. Cline

By Joe L. Galvin  
Reg. Sur 1684

PLAT  
Tract in FL 124 & 125  
Sec 26 & 27 T.9 R.14. ATHENS TWP.  
ATHENS CO. O.

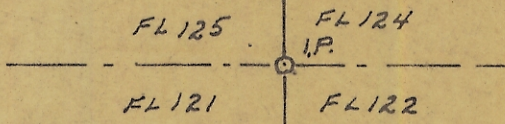

John. Cline - Survey  
4/26-'58