


199-347

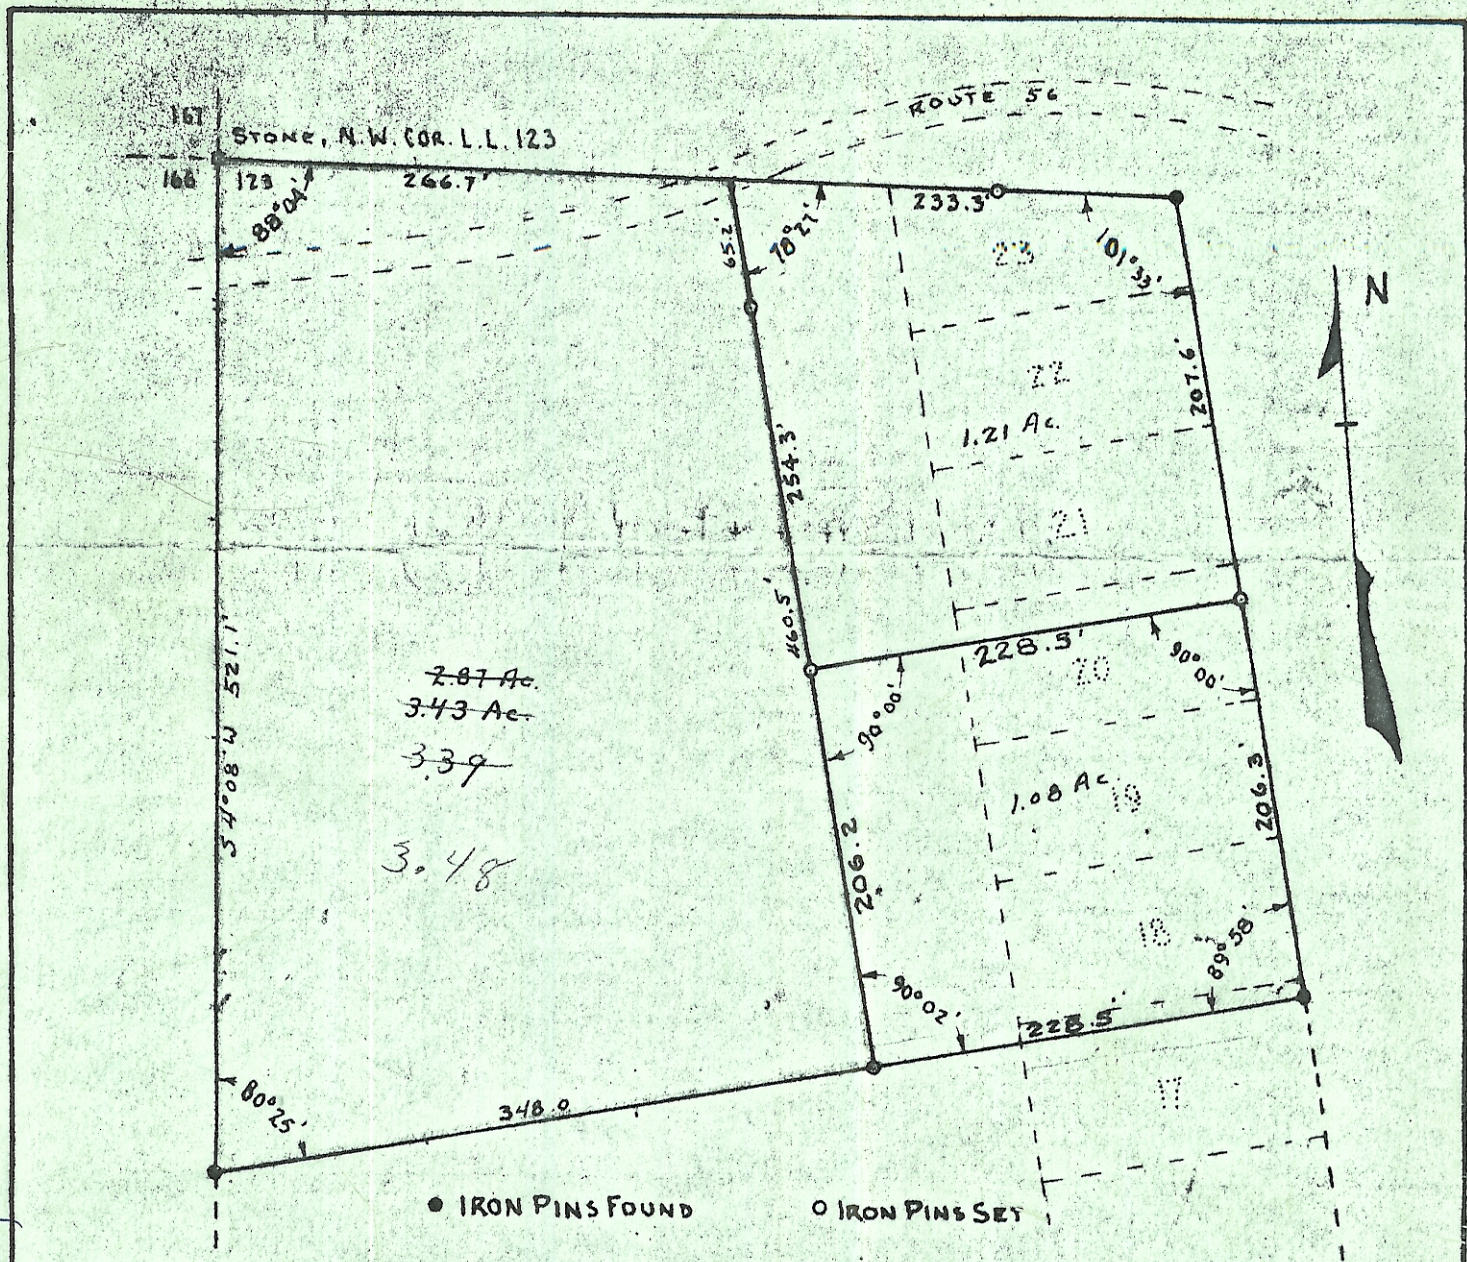

Sec 26 & 32

SURVEY FOR  
**WILLIAM M. WEISENBACH**

LEASE LOT 123 SEC 26 & 32 TOWN 9 RANGE 14  
 OHIO RIVER SURVEY

Scale 1"=100'

March 2, 1954

**GEORGE W. CLARK**  
 REG. SURV.