




SOUTHEASTERN LAND SURVEYS

LEONARD F. SWOYER
REGISTERED PROFESSIONAL LAND SURVEYOR

3428 Pleasant Hill Road
Athens, Ohio 45701
614/593-8701

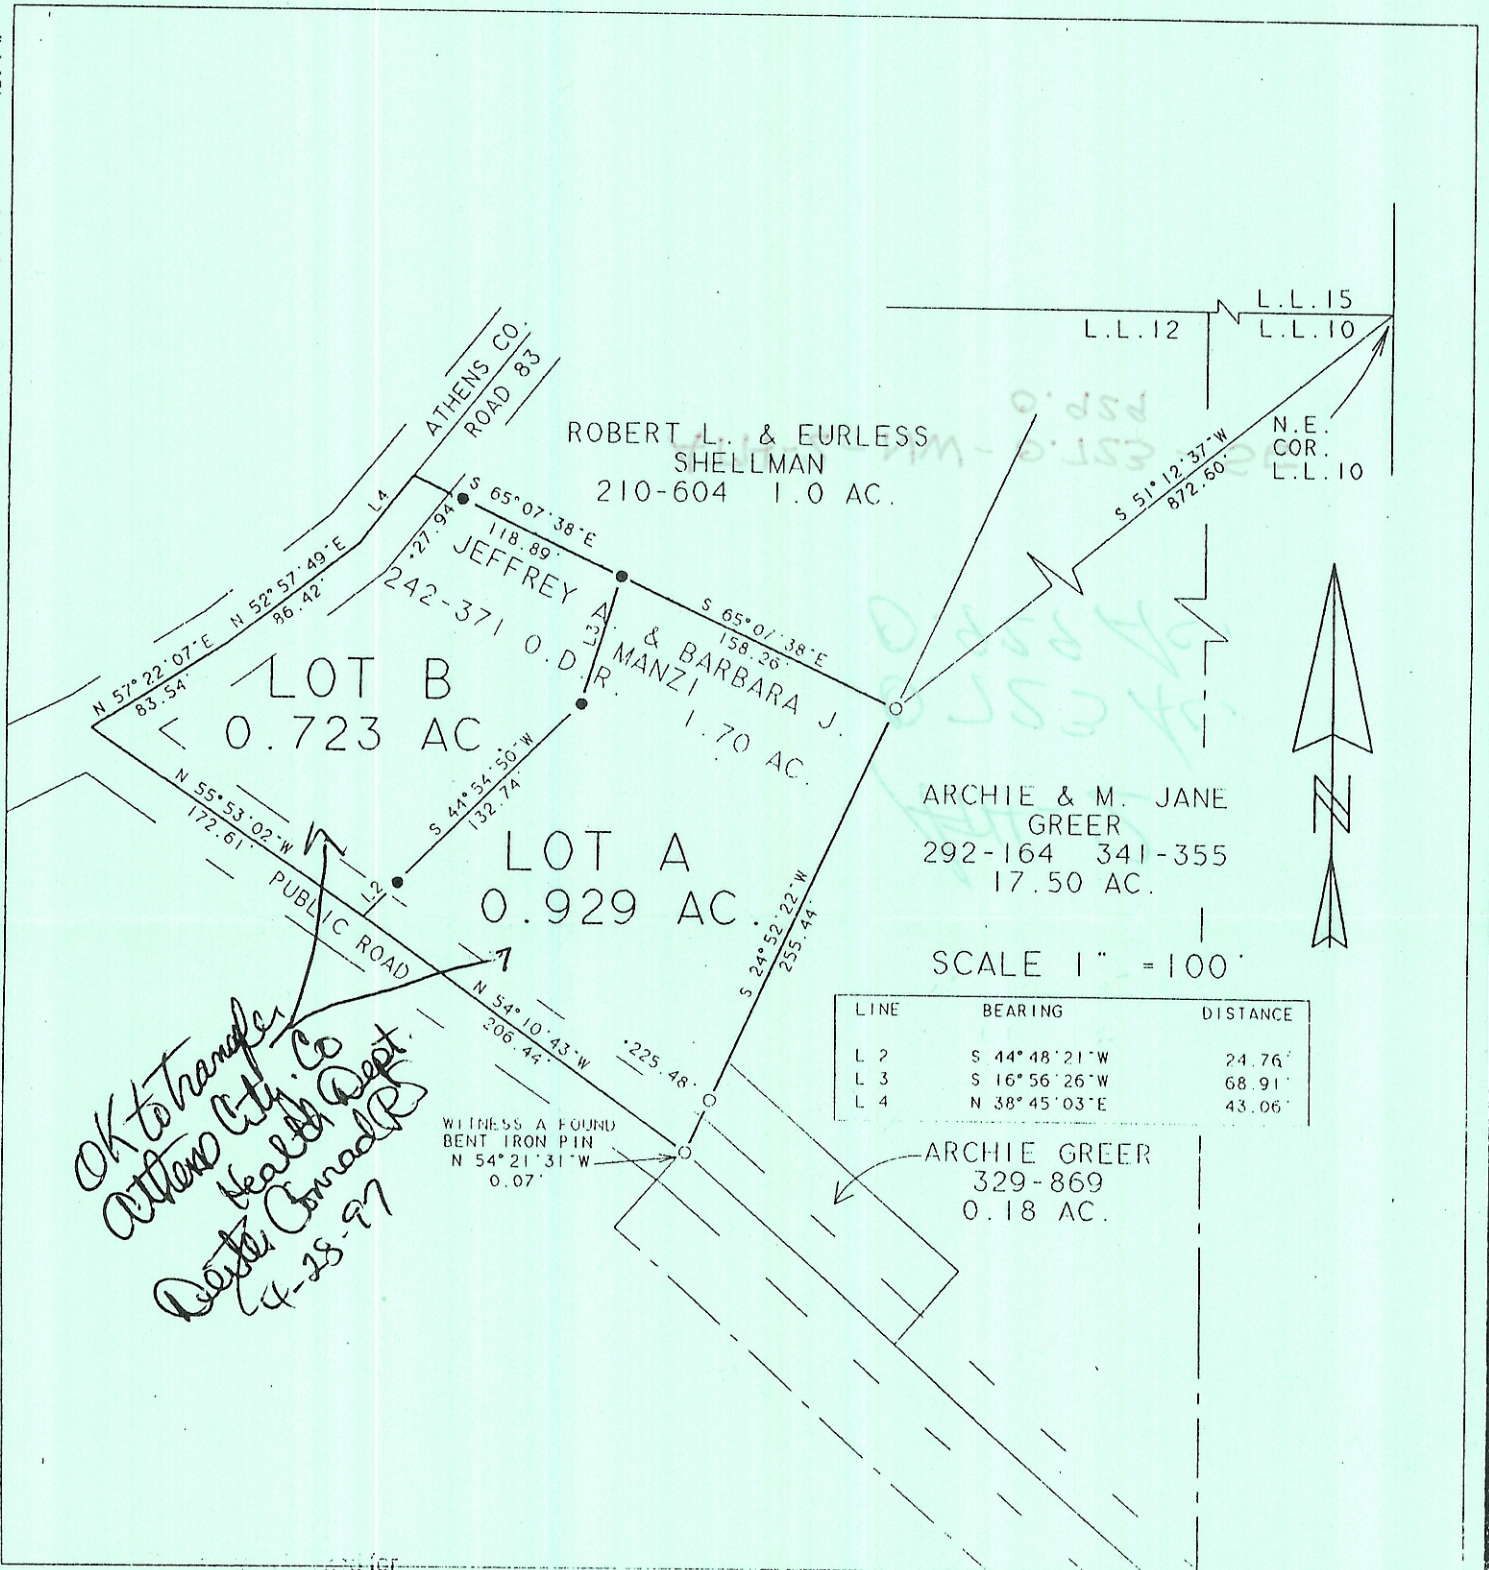

REC'D
ATHENS COUNTY
S. Blausler
4-7-97

Plat of Survey of Lots A & B Scale 1" = 100'

Surveyed for Mr. Jeffrey Manzi Date 4/01/97

Subdivision L.L. 12

Township Athens Section 2 Town 9 Range 14

Corporation --- County Athens State Oh.

Leonard F. Swoyer Jr.
Leonard F. Swoyer Jr. Reg. Prof. Land Surveyor No. 6765

ATH #2