




# SOUTHEASTERN LAND SURVEYS

LEONARD F. SWOYER  
REGISTERED PROFESSIONAL LAND SURVEYOR

3428 Pleasant Hill Road  
Athens, Ohio 45701  
614/593-8701

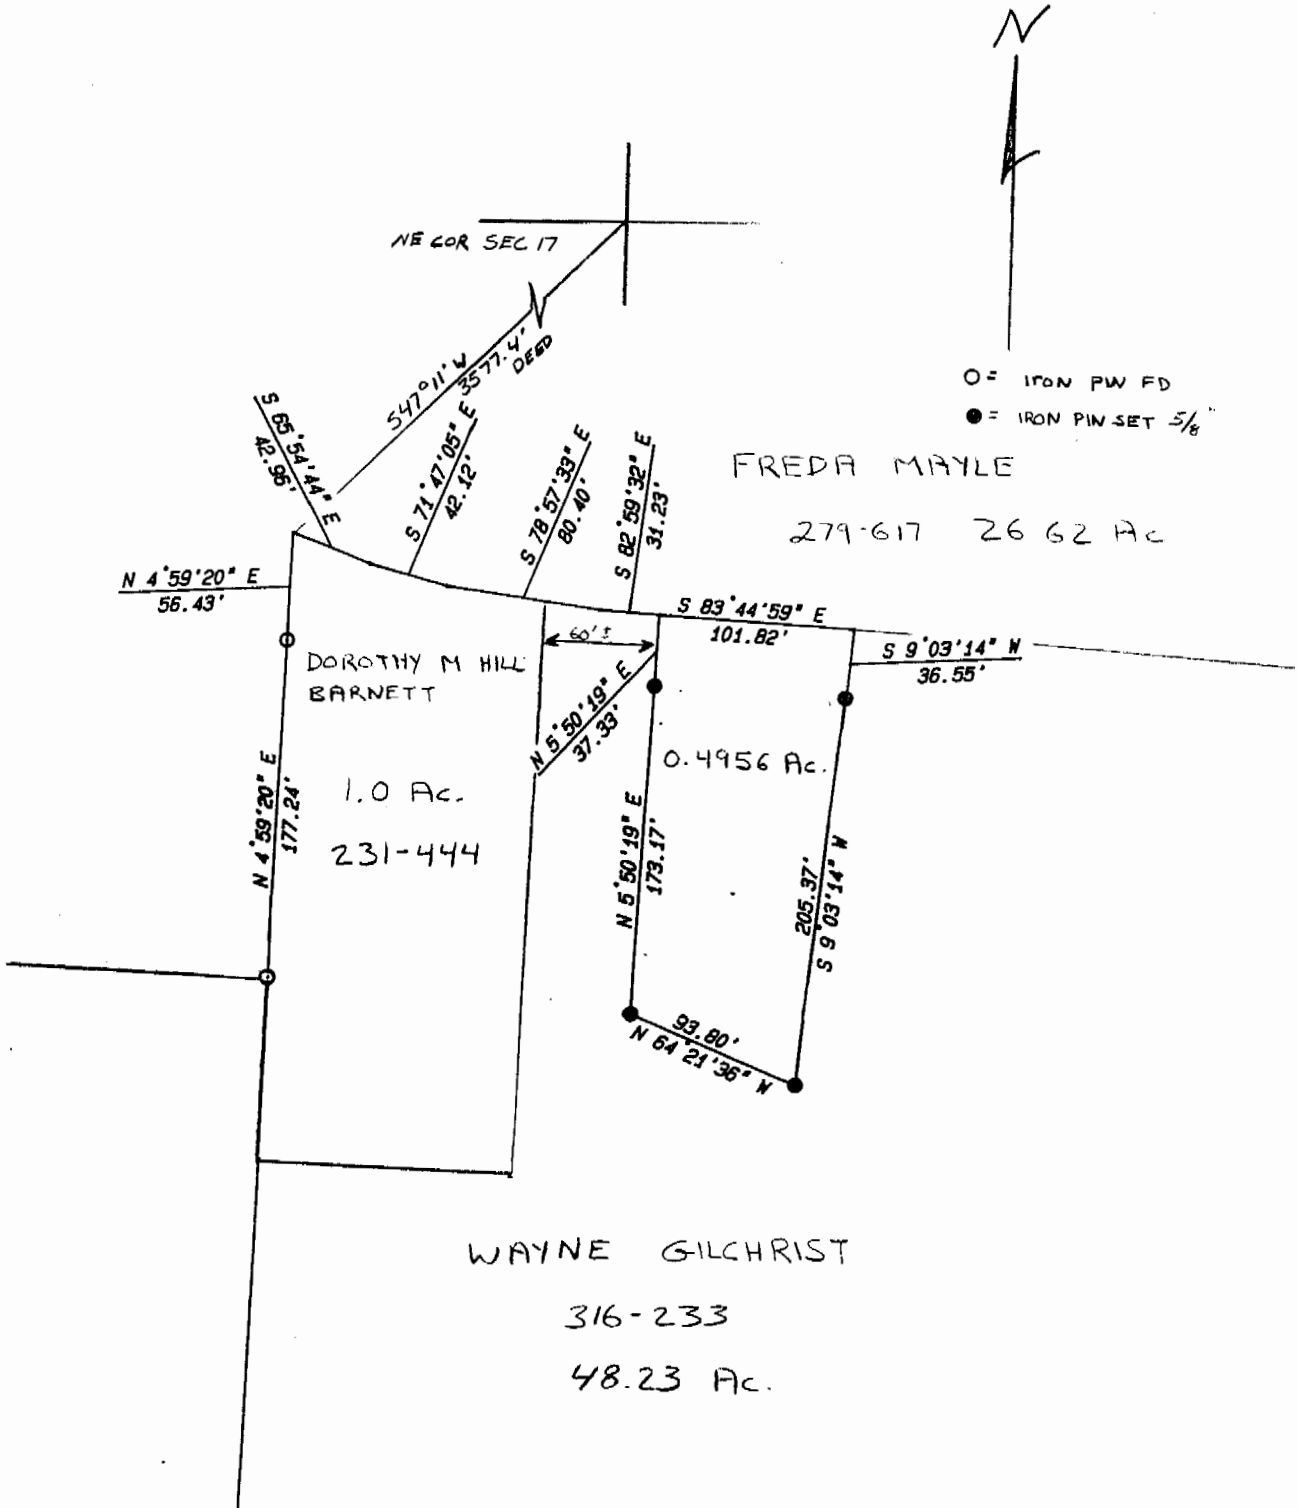

Plat of 0.4956 Acre Scale 1" = 100'  
 Surveyed for Wayne Gilchrist Date 6/1/92  
 Subdivision -----  
 Township Bern Section 17 Town 7 Range 12  
 Corporation --- County Athens State Ohio  
 Leonard F. Swoyer Jr. Reg. Prof. Land Surveyor No. 6765