


N Cannon Land Surveying

7945 Twp. Rd. 114 NE
 New Lexington, Ohio 43764
 (614) 342-2835

Bearings Shown Hereon are to an Assumed Meridian and Are Used to Denote Angles Only.
 Data References: U.S.G.S. Maps, Tax Maps, Deed Descriptions, and Existing Monumentation.


This Survey is Subject to any Facts That May be Disclosed by a Full and Accurate Title Search.

Scale 1" = 200'

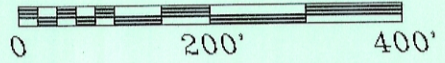

December 10 1998
OK. to transfer
0.50 acre and 0.75 acre tracts
per ATHENS City-Co. HEALTH Dept.
Charles Hammer, R.S.
 ⊕ NO BUILDING SITES
 POSSIBLE FOR EITHER TRACT.

Description checked for
 Mathematical Accuracy
 ATHENS COUNTY
 ENGINEER'S OFFICE
 BY: S. Blausen
 DATE: 10-16-98

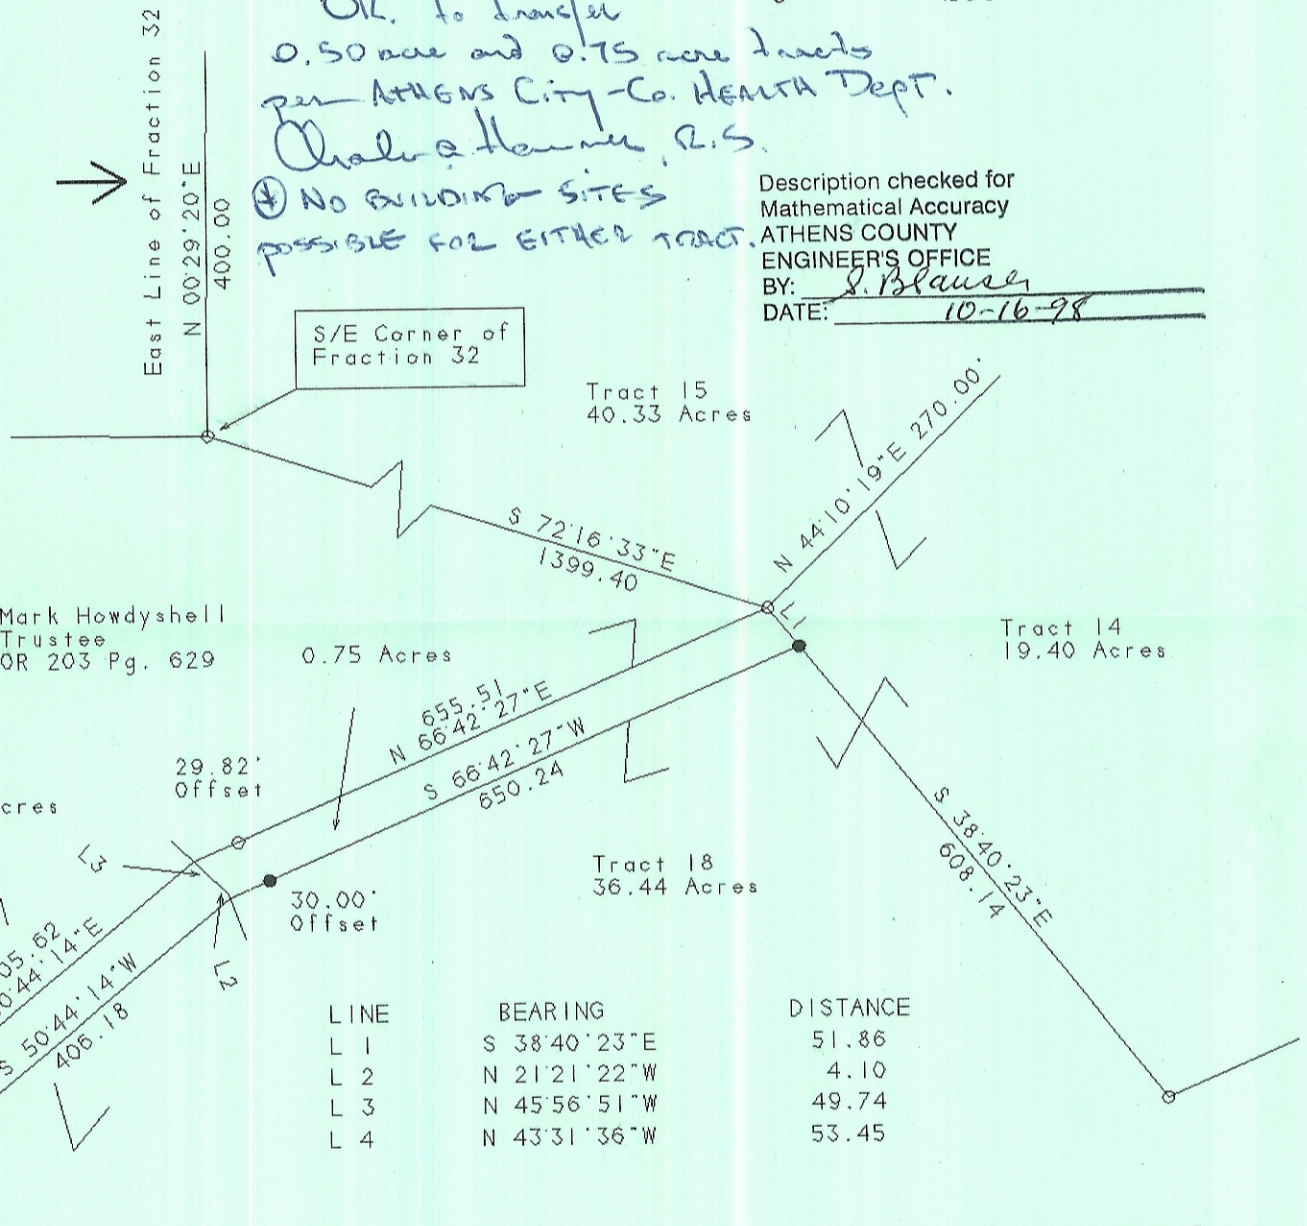

Mark Howdyshell
 Trustee
 OR 203 Pg. 629

LINE	BEARING	DISTANCE
L 1	S 38°40'23"E	51.86
L 2	N 21°21'22"W	4.10
L 3	N 45°56'51"W	49.74
L 4	N 43°31'36"W	53.45

Legend

- Iron Pin Set
- 5/8" Rebar W/Cap
- Iron Pin Found
- ⊗ Post
- ▲ R.R. Spike Set
- △ R.R. Spike Found
- Drilled Hole 5/8"
- Stone Found
- ⊙ PK Nail Set
- ⊙ PK Nail Found
- *-* Fence
- ➔ Basis Of Bearings

Kevin Cannon
 Kevin Cannon
 Reg. # 7224

10/16/98
 Date

Survey For: Paul Oberhauser
 State: Ohio
 County: Athens
 Township: Bern
 T- 7 R- 12 Lot: N/A
 Section: Fraction 31
 City or Village: N/A
 Subdivision: N/A
 Parcel #: N/A



200 80