



Sec. 28

PLAT
 of property line location
 between F. H. Gifford &
 H. M. Goddard in Section
 34 & Fr. 24 & 34 in Section
 28 T. 7 R., 12 Bern Twp.
 Athens Co. Ohio
 surveyed April 1963
 by Joe L. Galvin
 Reg. Sur. 1684.

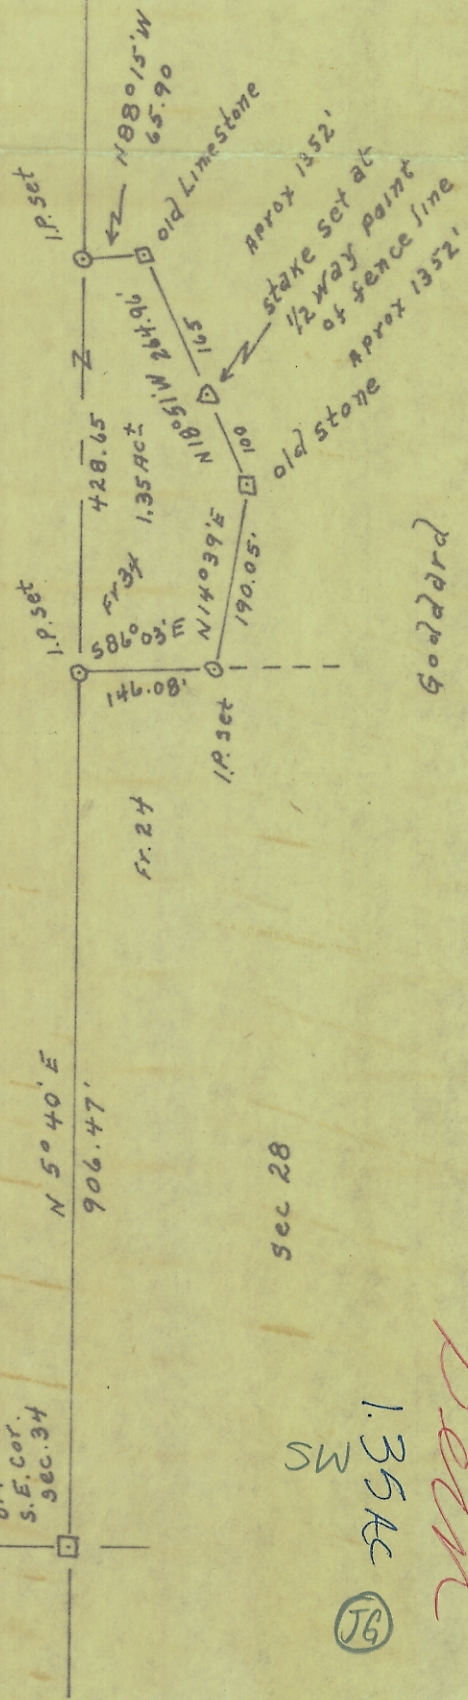

Sec 28
 Bern
 1.35A
 MS
 JB

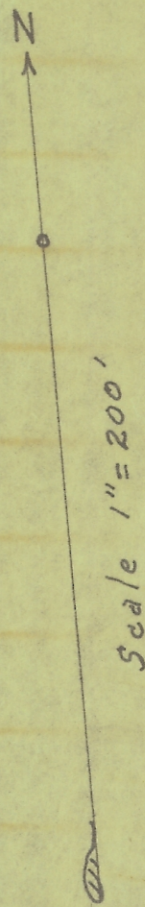