


SOUTHEASTERN LAND SURVEYS

LEONARD F. SWOYER
REGISTERED PROFESSIONAL LAND SURVEYOR

3428 Pleasant Hill Road
Athens, Ohio 45701
614/593-8701

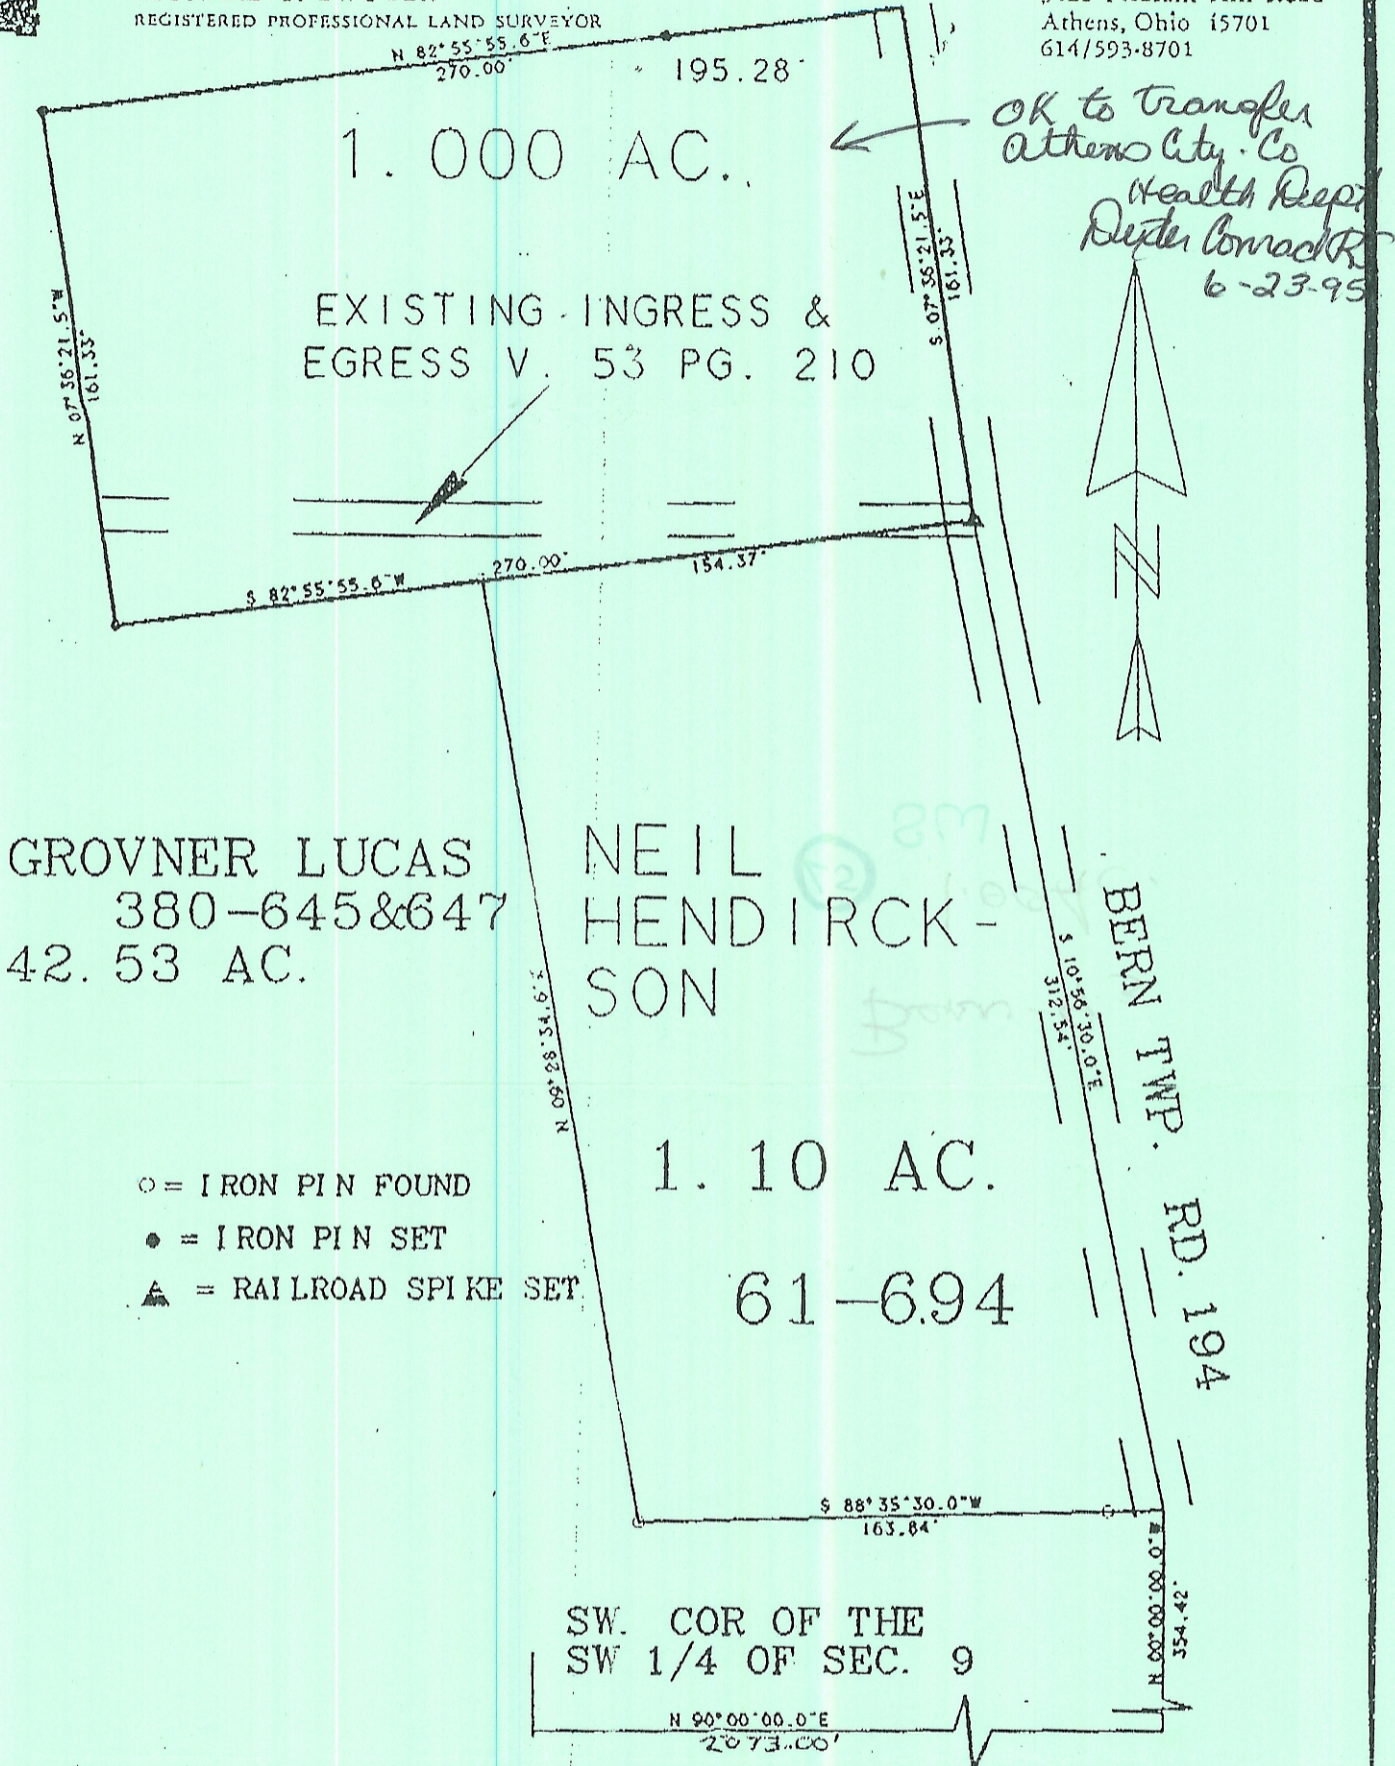

Plat of 1.00 Acre Scale 1" = 60'
 Surveyed for Ivan Walker + LOLA LUCAS Date June 6, 1995
 Subdivision _____
 Township Bern Section 9 Town 7 Range 12
 Corporation _____ County Athens State Oh.

Leonard F. Swoyer
 Registered Professional Land Surveyor No. 6765