
CARPENTER PLACE PARKING

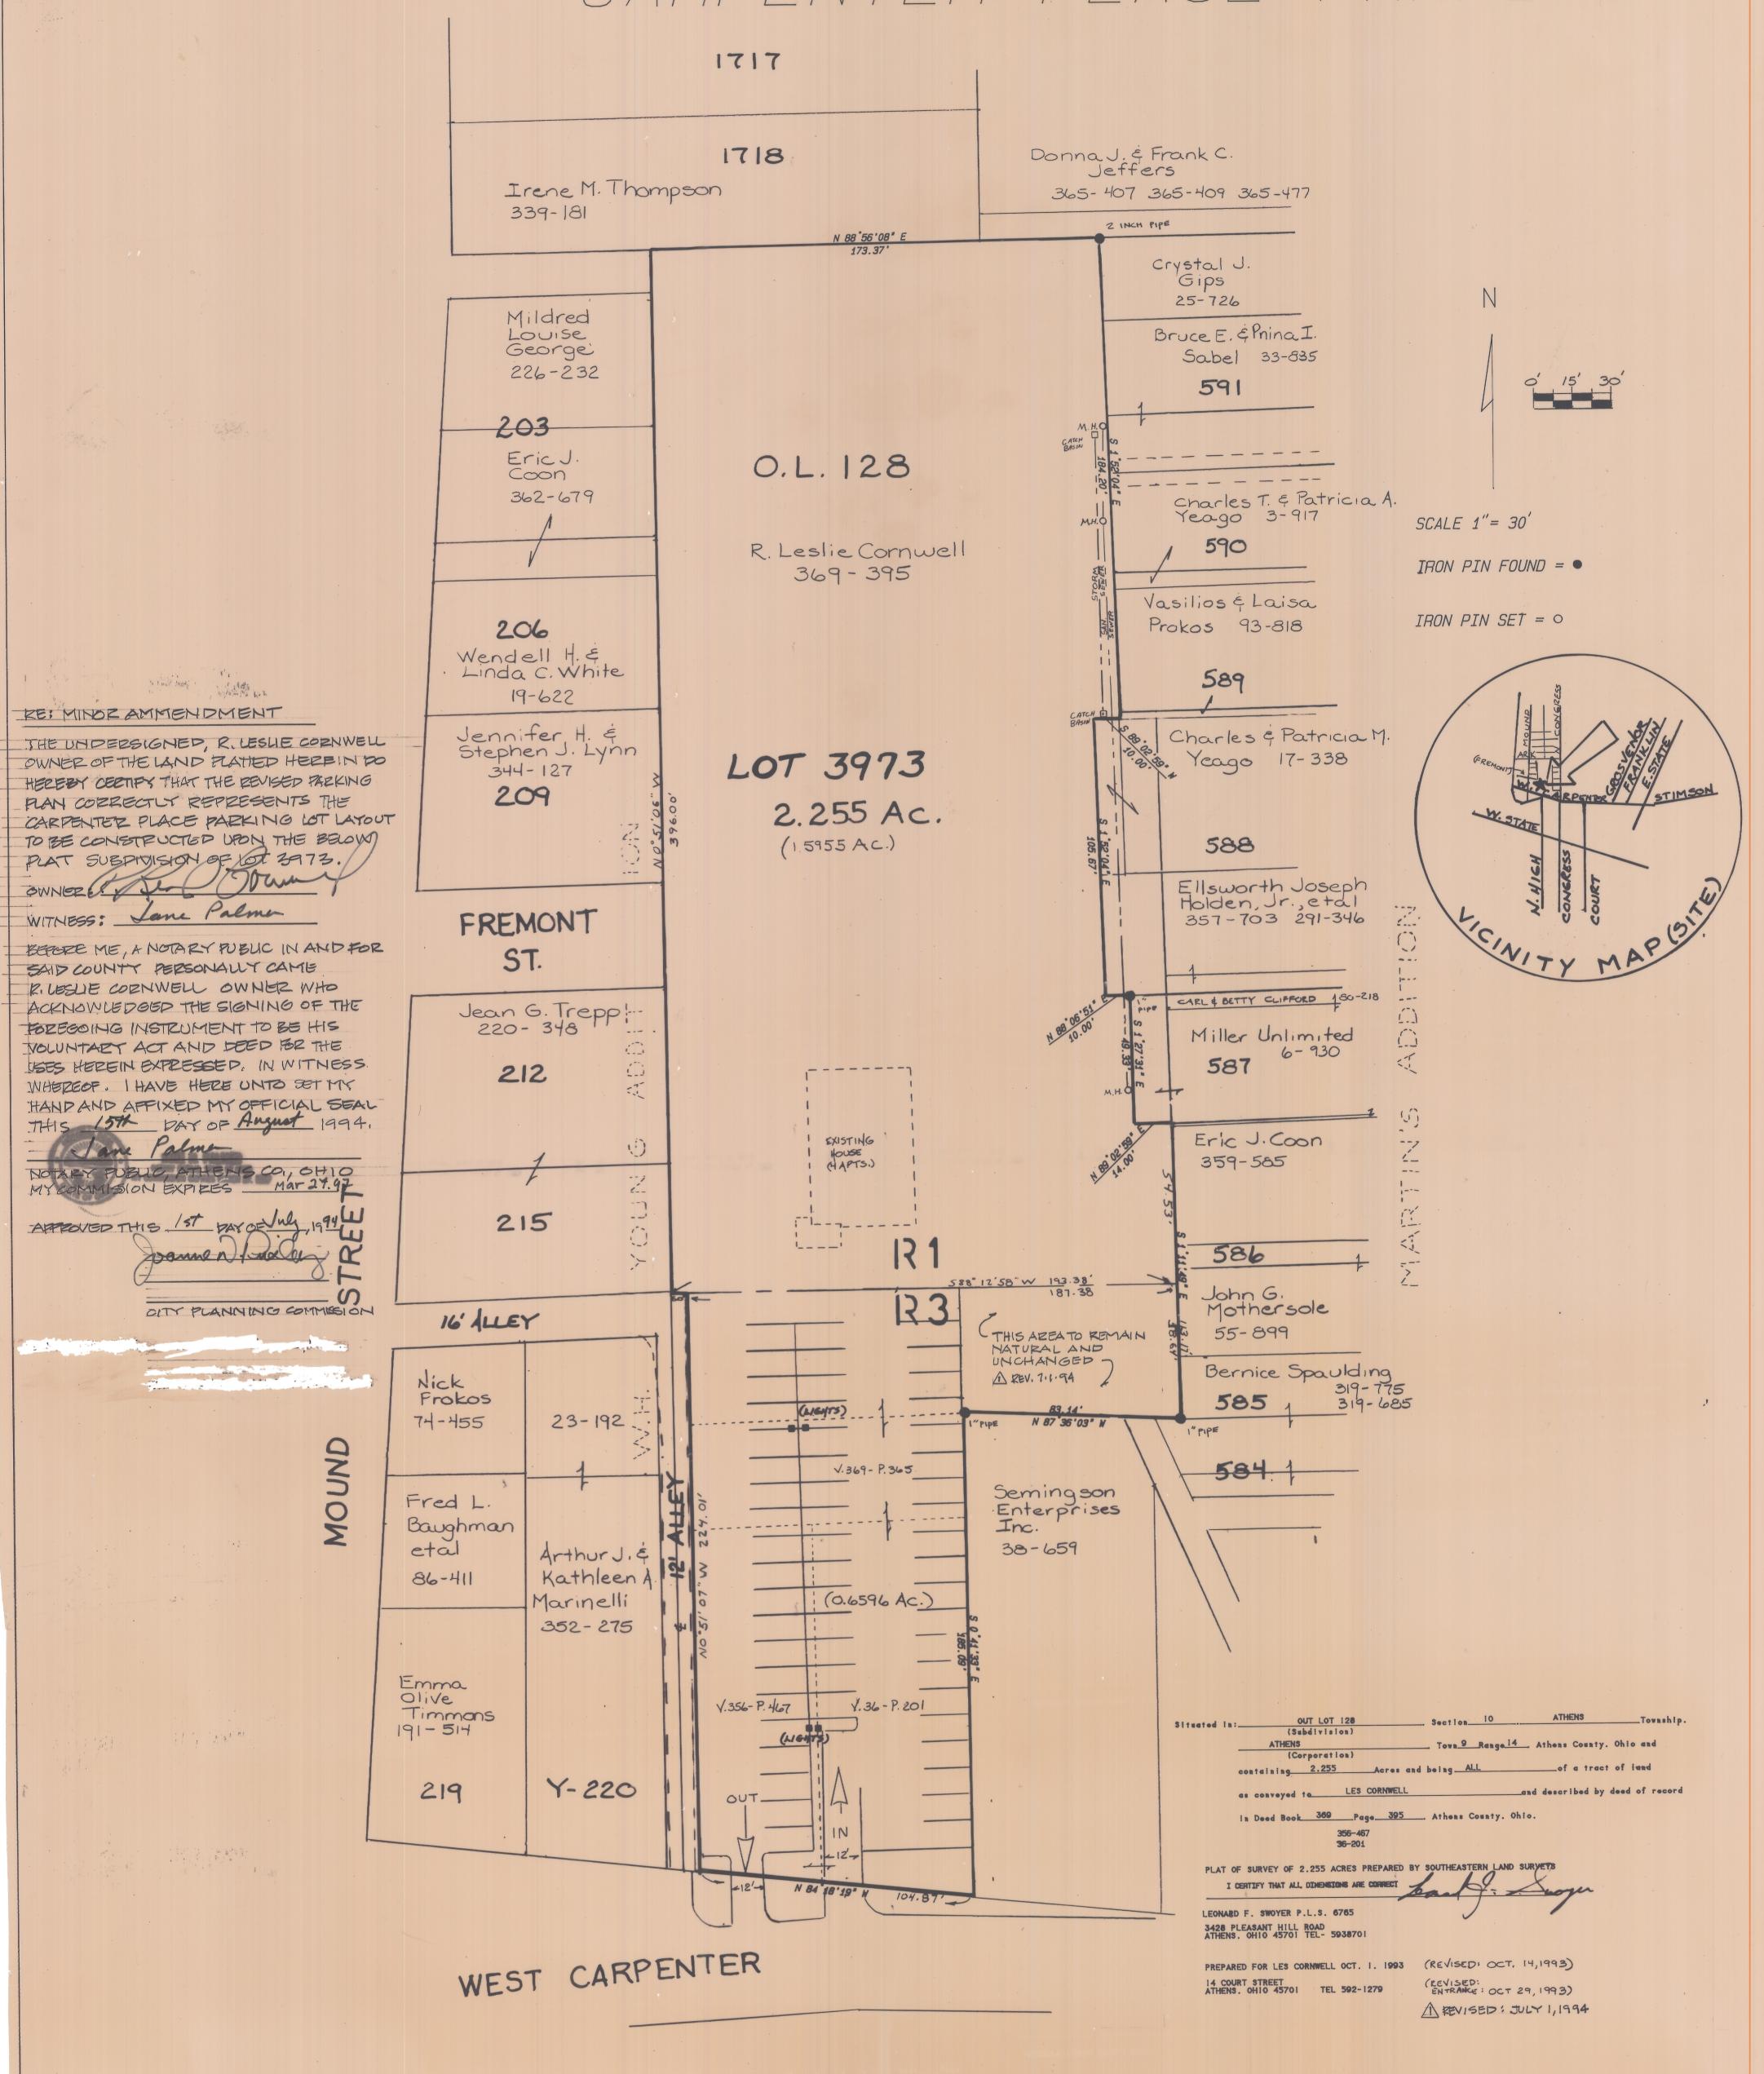


Transferred this 15th day of august 1994 By: Putu Co. Couladis
Not Necessary

Auditor. Athens County. Ohio Filed for record this 15 day of august 1994 at M. in Plat Book Page

RECORDER ATHENS COUNTY OHIO

CARPENTER PLACE PARKING

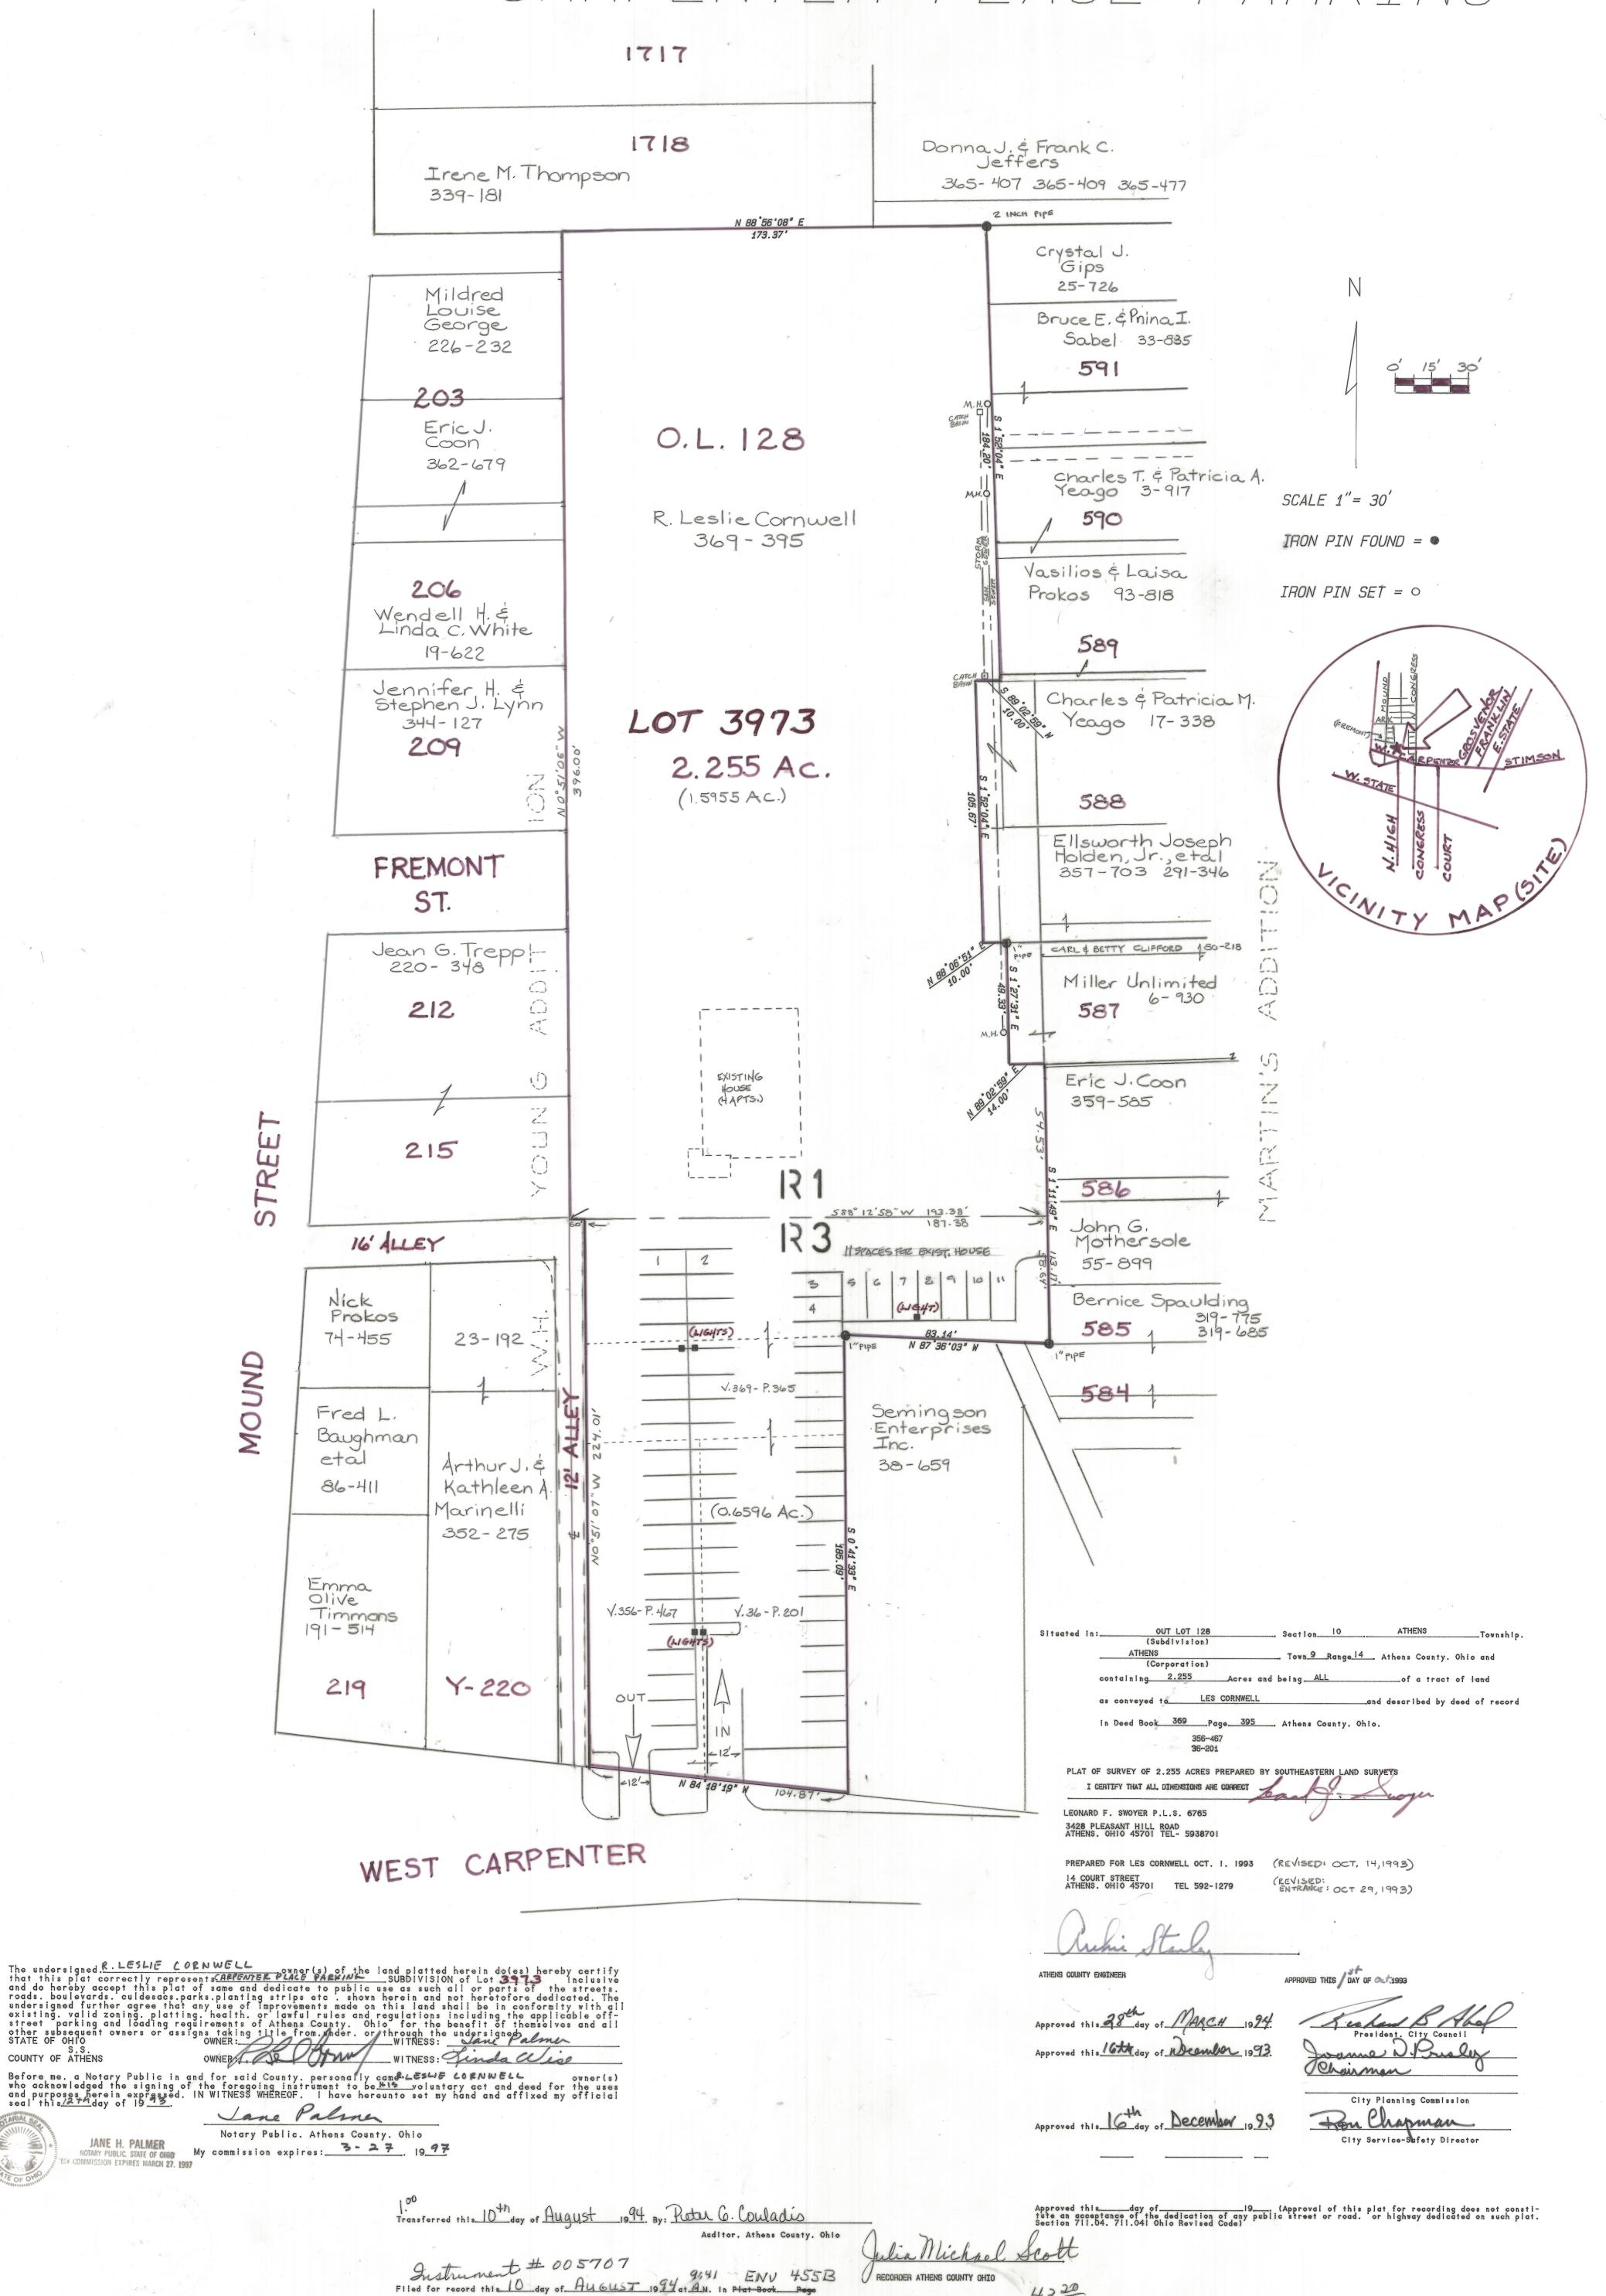

Support of