Description of 5.0000 Acres

Situated in Section 18, Town 5, Range 13, Canaan Township, Athens County,
Ohio and being more particularly described as follows:

Commencing at the Southwest corner of said Section 18, thence along the South:line of said section West 957.00 feet to a stone found; thence N 1°07'34" W 161.86 feet to a railroad spike in the centerline of County Road 20 (passing an iron pin at 141.86 feet); thence along the centerline of said road N 79°51'21" E 65.58 feet to a railroad spike set at the point of beginning of the tract herein described; thence leaving the road N 2°52'17"W 406.06 feet to an iron pin set (passing an iron pin set at 30.00 feet); thence N 64°56'39" E 489.53 feet to an iron pin set; thence S 4°20'53" E 503.68 feet to a railroad spike in the centerline of said road; thence along the centerline the following counses and distances to points marked 518°26'57"W 4.52607; by railroad spikes; S 65°12'18" W 85.15 feet; S 69°37'55" W; S 81°47'47" W; and S 83°15'09" W 194.79 feet to the point of beginning containing 5.0000 acres.


Prior Deed reference Vol.349 Page 59 Athenx County Deed Records

Surgery K. Wusts
Gregory K. Wright S-6535

Deceription checked for Methomatical Accuracy WHENS COUNTY

06-26-04

Canam Sec. Ti

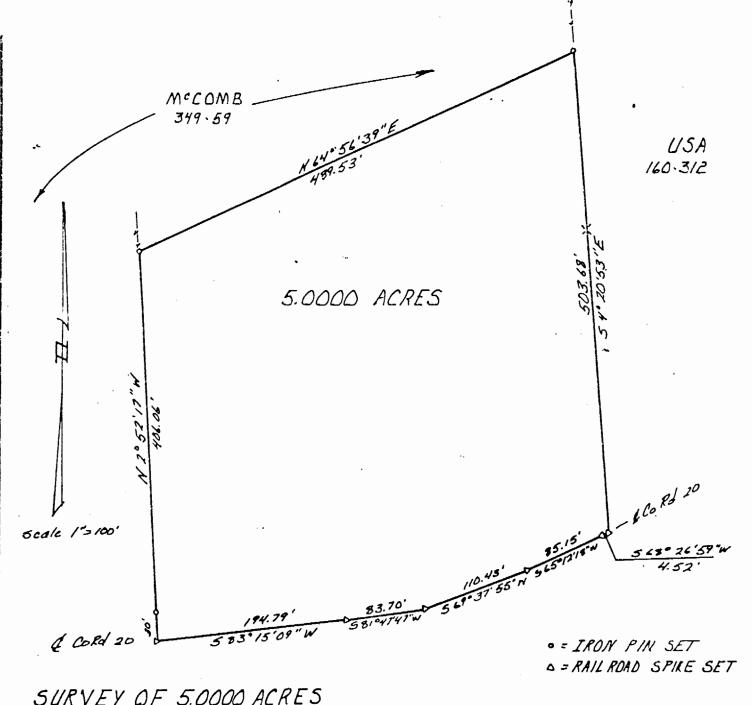

SURVEY OF <u>5.0000</u> ACRES SURVEYED MAY 8.1981 FOR <u>BILL MªCOMB</u> LOCATED IN SECTION 18, TOWN 5. RANGE 13, CANAAN TOWNSHIP, ATHENS COUNTY, OHIO

Dat cription checked for Methomatical Accuracy ATHENS OCUNTY

ENGINEER'S OFFICE BY: al. w. Stuff.

DATE 06-25-84

Sugary K. Wings
CREGORY K WRIGHT 5-6535