

Description of 1.0181 Acres

Situated in the Northwest Quarter, Section 33, Town 5, Range 13, Canaan Township, Athens County, Ohio, and being more particularly described as follows:

Commencing at the Southeast corner, Northwest Quarter, Section 33; thence North 5 degrees 56' 40" East, 1,042.97 feet to an iron pin found on a fence line and the true point of beginning for the following described tract: Thence South 88 degrees 11' 30" West to 115.17 feet; Thence North 33 degrees 43' 05" West 426.05 feet to a railroad spike found in the center line of township road 133; Thence along center line of said road North 59 degrees 37' East 97.93 feet to a railroad spike found; Thence leaving the road South 33 degrees 43' 05" East 481.23 feet (passing an iron pin found at 19.60 feet) to the point of beginning containing 1.0181 acres.


Prior Deed Reference: Volume 344-617

Steven C. Skinner
registered surveyor



3

CAN#33

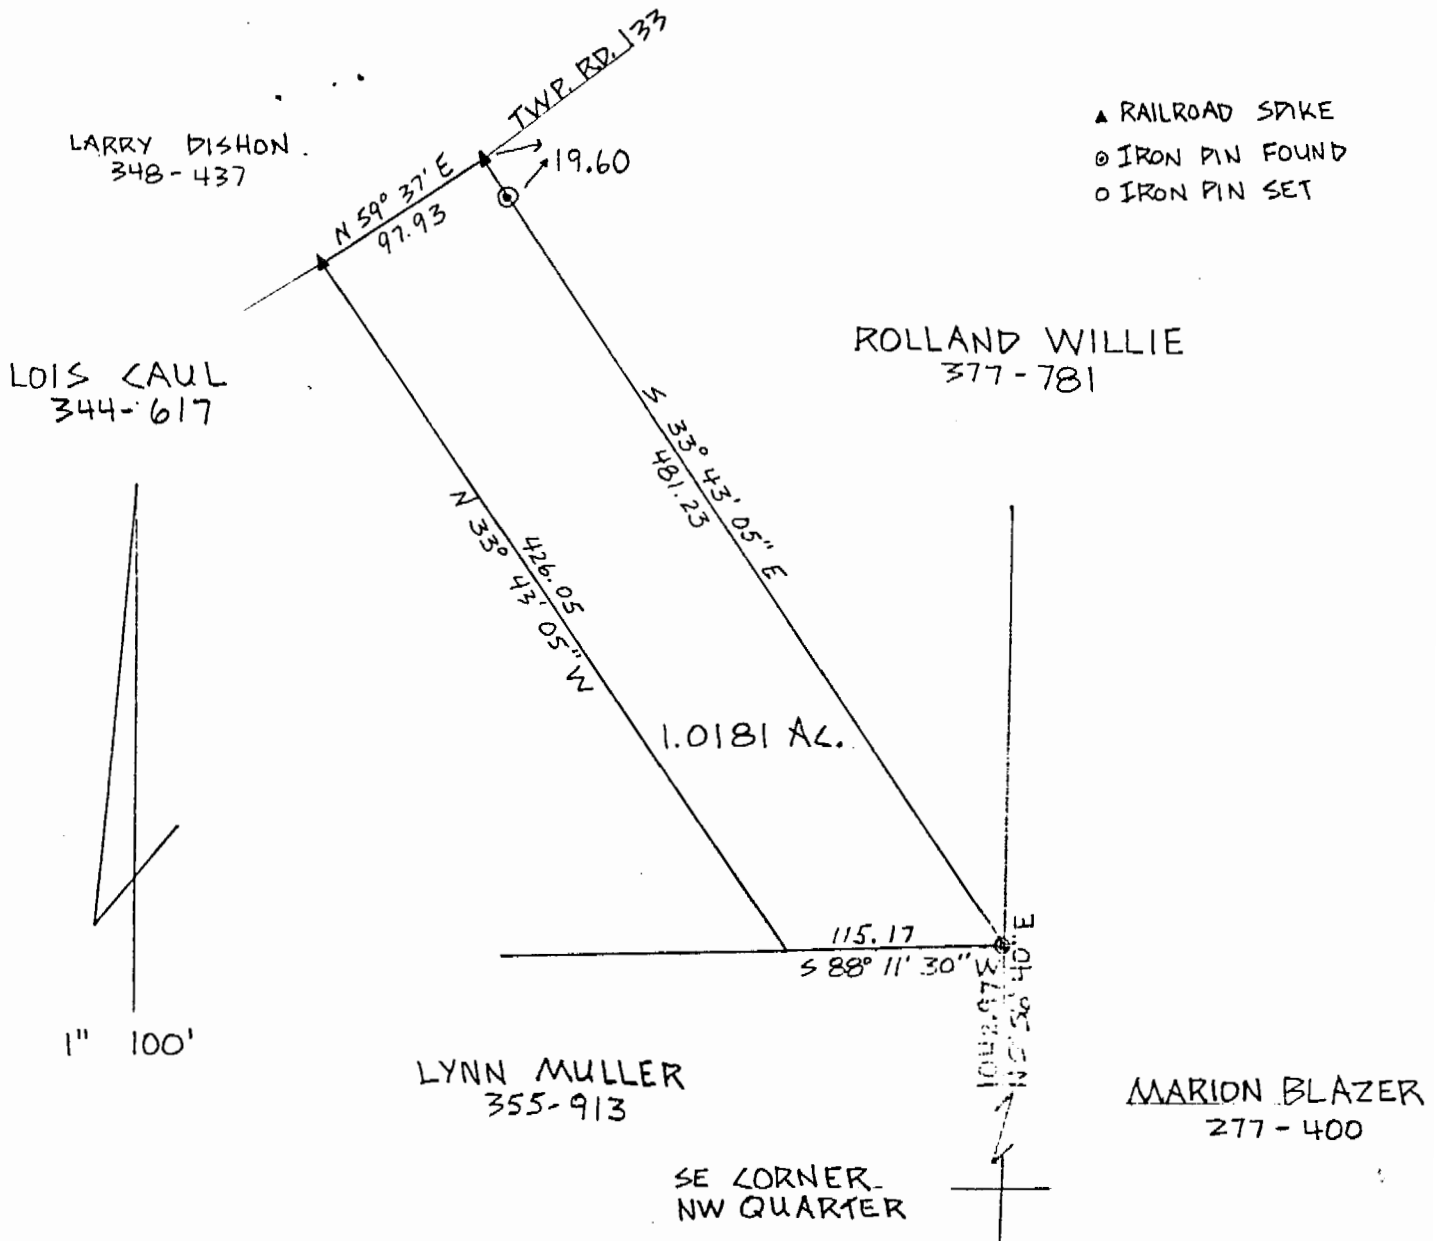

PLAT OF SURVEY
 1.0181 ACRES
 SITUATED IN SECTION 33,
 TOWN 5, RANGE 13, CANAAN TOWNSHIP
 ATHENS COUNTY, OHIO
 FOR STEVE CAUL, SURVEYED 6-4-86

Steven C. Skinner
 REGISTERED SURVEYOR 56700



28