BRANNER SURVEYING

MEMBER-PROFESSIONAL LAND SURVEYORS OF OHIO

12500 PEACH RIDGE ROAD ATHENS, OHIO 45701

JOHN M. BRANNER Registered Land Surveyor

TELEPHONE (614) 592-5778

DESCRIPTION OF A 0.80 ACRE TRACT

Situated in Fraction 2. Section 9, T.5, R.13, Canaan Township, Athens County, Ohio and being more particularly described as follows:

Commencing at the North West corner of Fraction 3, thence, South 23.64 chains (deed) to a point; thence, South 04 Degrees 30 Minutes West, 519.95 feet (deed) to a point; thence, South 04 Degrees 30 Minutes West, 135.6 feet to a point; thence, South 39 Degrees 18 Minutes 14 Seconds West, 254.24 feet to a point in the center of U.S. 50; thence, along said road, North 44 Degrees 25 Minutes 28 Seconds West, 263.74 feet to a point; thence, North 45 Degrees 52 Minutes 22 Seconds East, 203.00 feet (passing an iron pin at 53.0 feet) to an iron pin at the Northeast corner of a 0.516 acre tract, said pin being the point of beginning for the tract of land herein described:

Thence, along the North-line of said 0.516 acre tract, North 45 Degrees 48 Minutes 25 Seconds West, 150.00 feet to a point at the North-west corner of said tract; thence, along the West-line, South 45 Degrees 52 Minutes 22 Seconds West, 150.00 feet to a point in the North right of way of U.S 50; thence, along said right of way, North 41 Degrees 48 Minutes 24 Seconds West, 207.65 feet to a point in the South-east corner of a 0.875 acre tract; thence, along the east-line of said tract, North 55 Degrees 21 Minutes 47 Seconds East, 179.04 feet to an iron pin set, passing an iron pin at 15.12 feet; thence, South 38 Degrees 47 Minutes 41 Seconds East, 329.31 feet to the point of beginning and containing 0.80 acres.


Grantor reserves a 50 feet wide easement for ingress and egress along the North-westerly line of the above described 0.80 acre tract

Subject to all easements and rights of way of record.

John M. Branner P.S. 6805

Desc iplica chacked for Whomewood Asserting between adjust YTHRUO COUNTY

DATE: 1-27-88

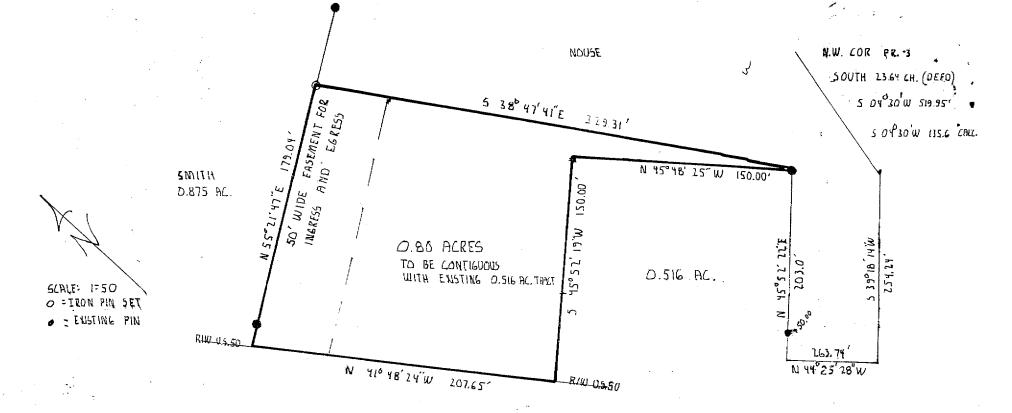

SURVEY OF A 0.80 AFRE TRACT
IN FR. Z, SEC.9, T.S, K.13,
CANAAN TWP, ATHENS Ca, O.
SURVEYED JAN. 1988

JOHN M. BRANNER P.S. 6805

8