
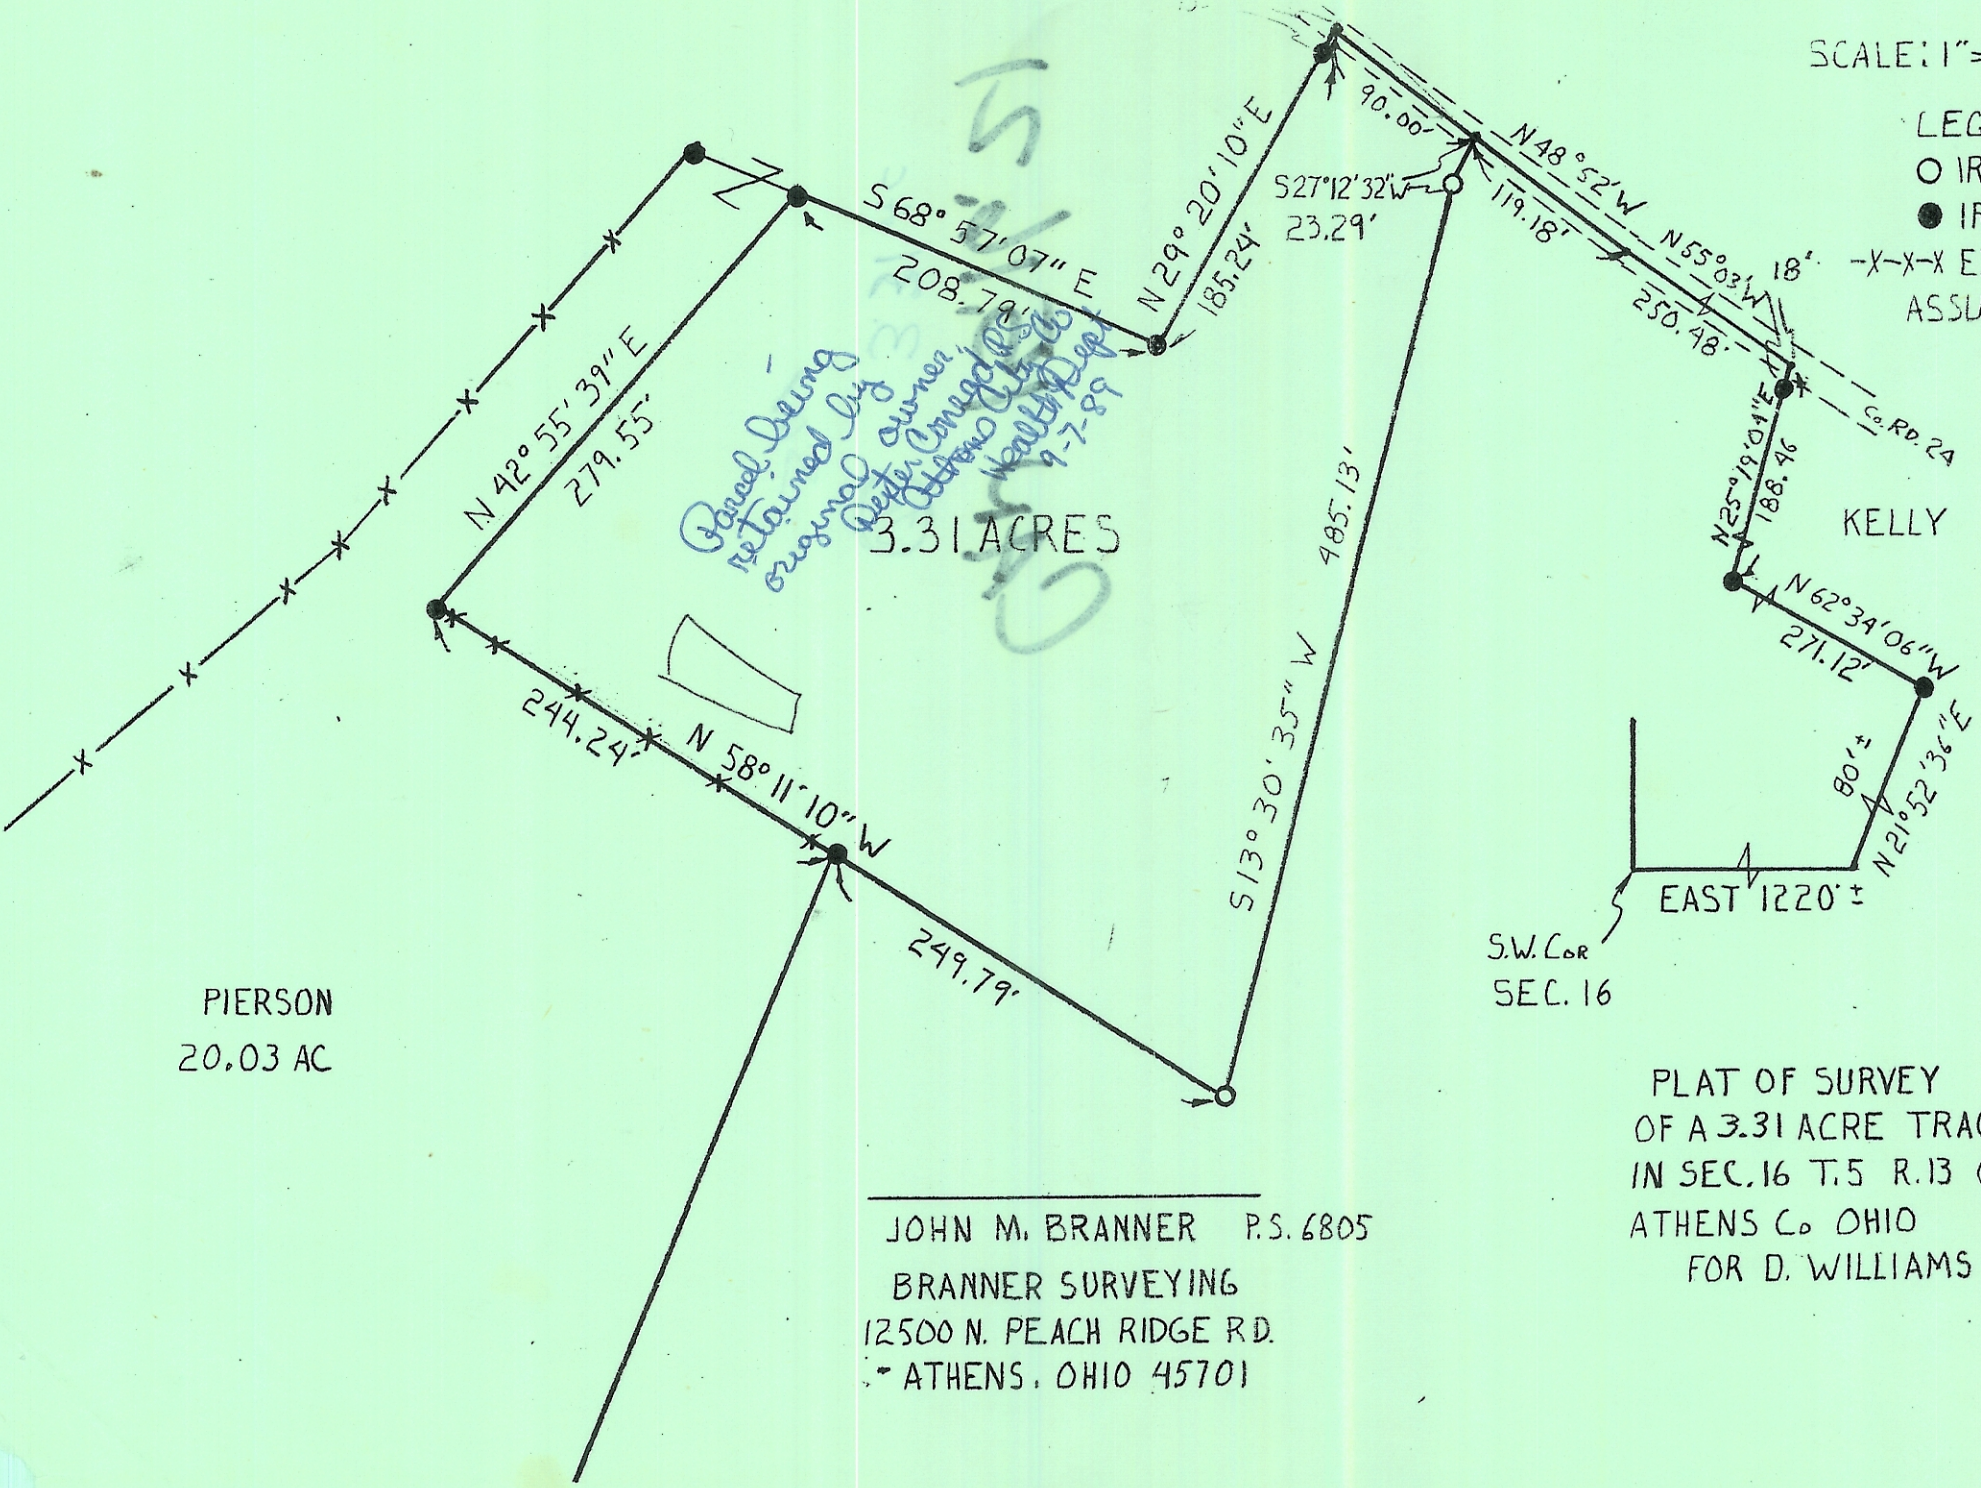


SCALE: 1"=100'

- LEGEND
- IRON PIN SET
 - IRON PIN FOUND
 - X-X- EXISTING FENCE
 - ASSUMED BEARINGS

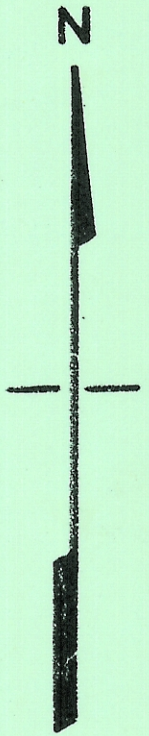

Placed during retained by Dexter, owner Athens Co. Health Dept 9-7-89

3.31 ACRES

PIERSON
20.03 AC

S.W. COR
SEC. 16

PLAT OF SURVEY
OF A 3.31 ACRE TRACT
IN SEC. 16 T. 5 R. 13 CANAAN TWP
ATHENS Co. OHIO
FOR D. WILLIAMS

JOHN M. BRANNER P.S. 6805
BRANNER SURVEYING
12500 N. PEACH RIDGE RD.
ATHENS, OHIO 45701