

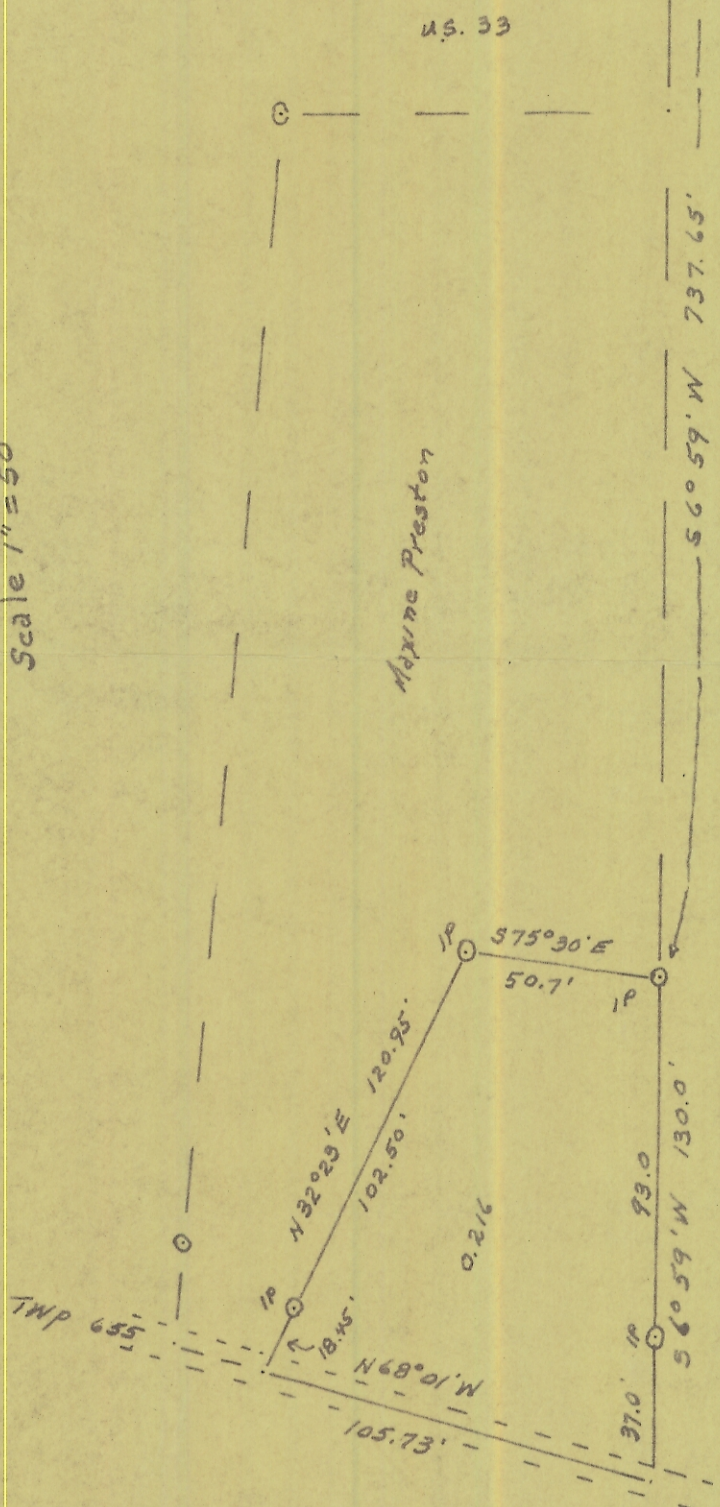


Sec. 31
 0.206 ac
 (JB) N/E

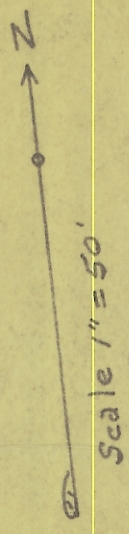

PLAT
 a part of section 31
 Dover Twp. Athens Co. O.
 surveyed 7-18-68
 by Joe L. Galvin
 Reg. SUR. 1684

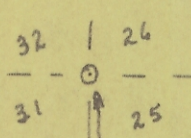