LEETUP, Sac. \$3

Situated in the Township of Lee, County of Athens, and State of Ohio, being a part of the Southwest Quarter of Section 3, Township No. 10, Range No. 15, and bounded and described as follows:

Commencing at the Northeast corner of the Southwest Quarter of Section 3; thence North 89° 00° 35° West along the North line of said Southwest Quarter of Section 3, 585.21 feet to a railroad spike at the Northeast corner of Lot No 15° in the "Seel's Golden 21 Subdivision" as recorded in Plat Book 10, Page 13 in the Athens County Recorder's office; thence South 0° 17° West 200.85 feet to an iron pin being the point of beginning; thence South 0° 17° West 616.65 feet to an iron pin; thence North 89° 55° West 146.33 feet to an iron pin; thence North 0° 29° East 121.86 feet to an iron pincon the South side of Jellico Road; thence along the South line of Jellico Road South 89° 31° East 270.42 feet to an iron pin at the P.C. of a curve to the left having a radius of 70.00 feet, an arc distance of 109.60 feet, and a cord bearing North 15° 36° East 90.74 feet to an iron pin at the P.T. of the curve, thence North 1° 00° East 125.15 feet to an iron pin; thence South 89° 34° Bast 100.00 feet to the place of beginning containing 4.821 Acres more or less and subject to all rights of way of record.


The above described tract was surveyed by Steven C. Skinner under the supervision of Larry P. Gerstner, Ohio Registered Surveyor No. 6344, May 20, 1978.

Description checked for Mathematical Accuracy

ATHENS COUNTY

ENGINEER'S OFFICE
RY. W. M. Walkin

DATE: 5/30/78

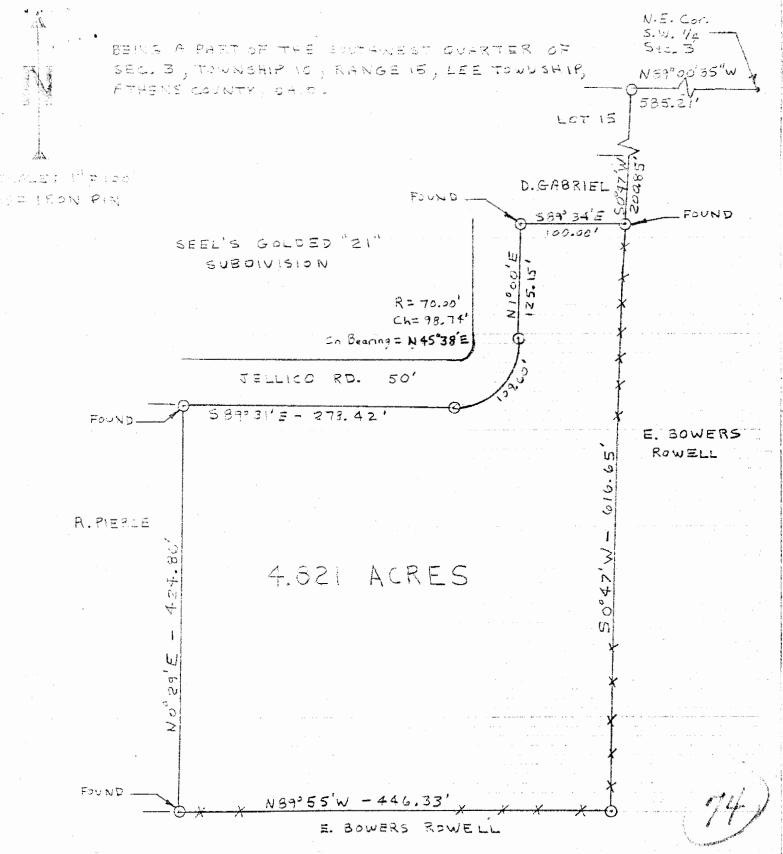

I HEREBY CERTIFY THAT AN ACTUAL SURVEY WAS MADE BY STEVEN C. SKINNER LIDER MY SUPERVISION OF THE PREMISES SHOWN HEREON ON THE 20th DAY OF MAY 1978; THAT THE PLAT IS A CORRECT REPRESENTATION OF THE PREMISES AS DETERMINED BY SAID SURVEY. I FURTHER CERTIFY THAT THERE MIRE NO ENCROACHMENTS EITHER WAY ACROSS ANY BOUNDARY LINE OF THE PREMISES EXCEPT AS SHOWN HEREON. I PAY

REGISTERED SURVEYOR NO. 6344