




SCALE 1 INCH = 100 FEET  
 - IRON PIN FOUND  
 - IRON PIN SET

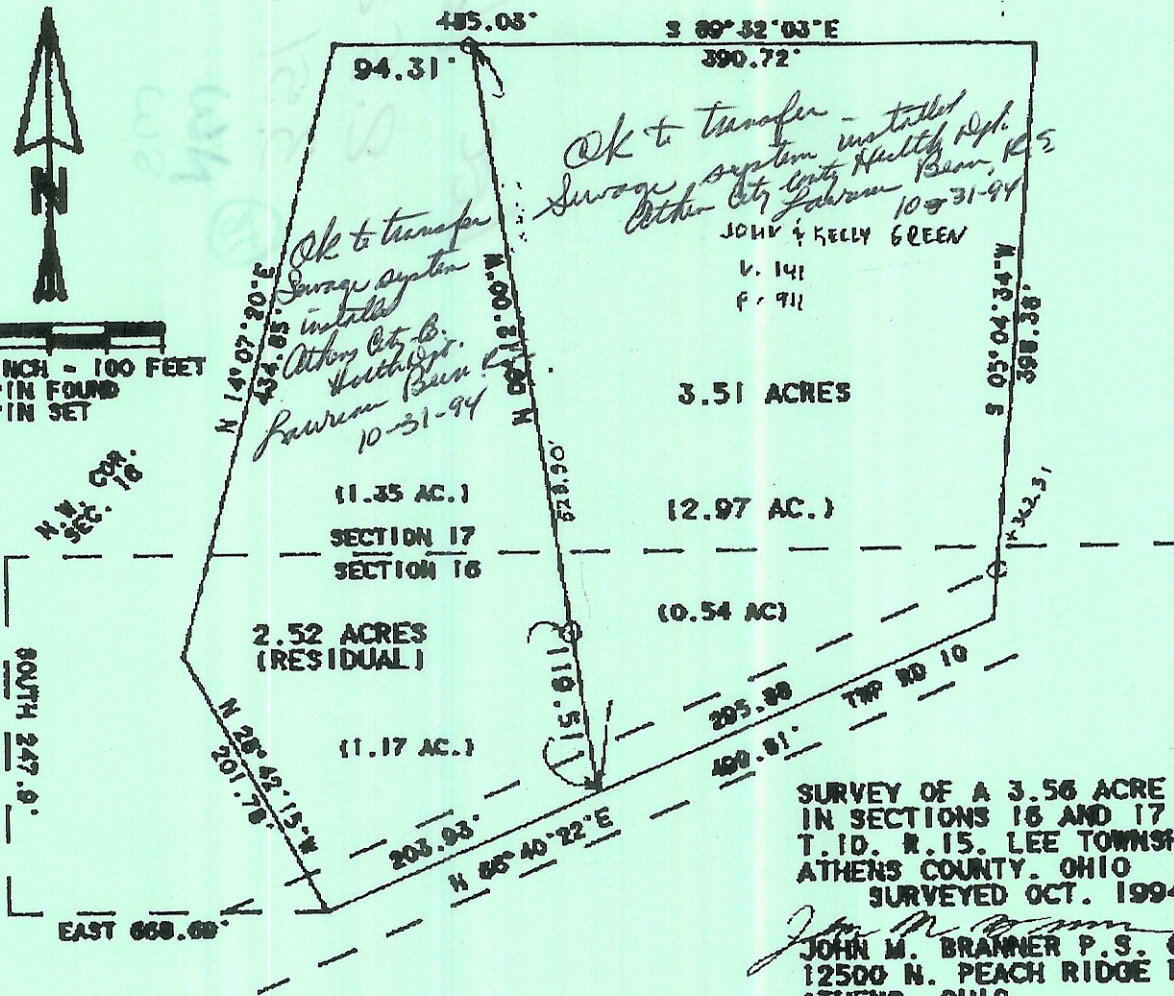

**SURVEY OF A 3.56 ACRE TRACT  
 IN SECTIONS 16 AND 17 OF  
 T.10, R.15, LEE TOWNSHIP,  
 ATHENS COUNTY, OHIO  
 SURVEYED OCT. 1994**

*John M. Branner*  
**JOHN M. BRANNER P.S. 6805  
 12500 N. PEACH RIDGE ROAD  
 ATHENS, OHIO**

