



Sec. 19

rec 19

lee

316-119

N.E. COR.
N.W. 1/4 OF THE
N.W. 1/4 SEC. 19

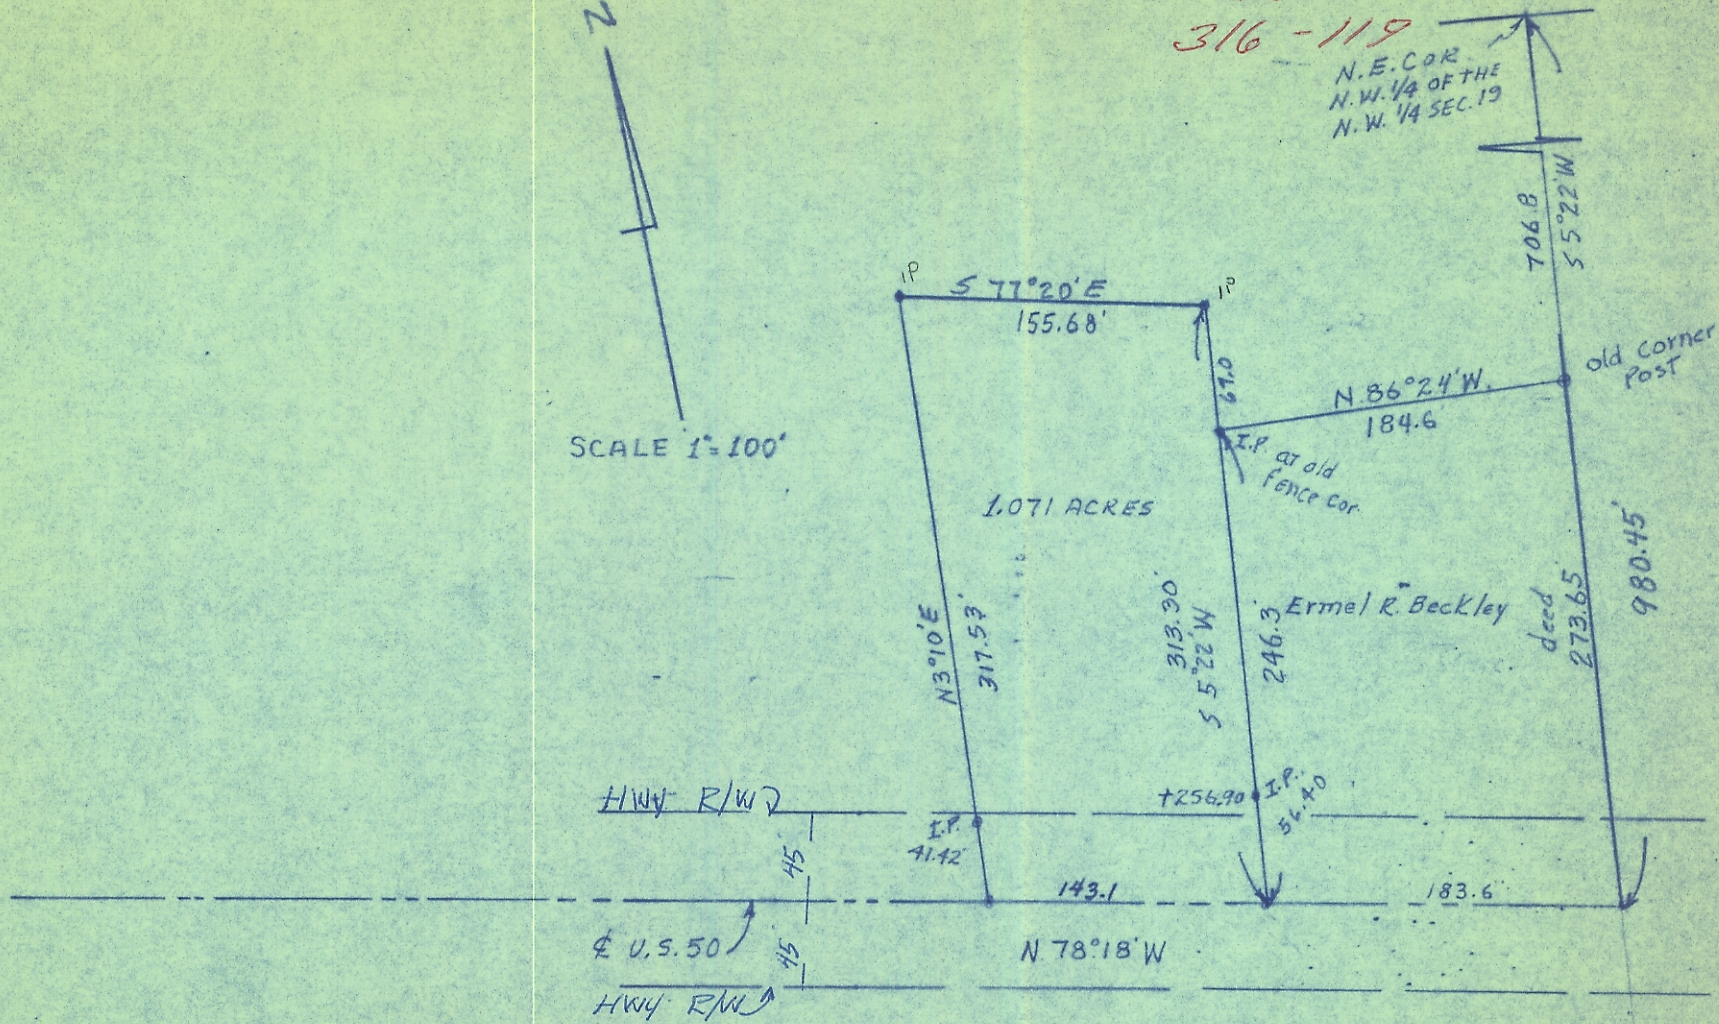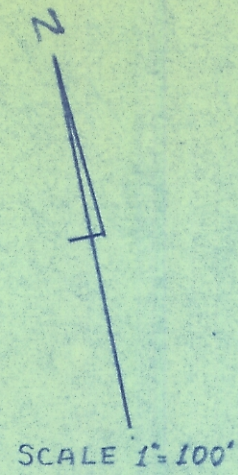

SURVEY OF A 1.071 ACRE TRACT IN THE N.W. 1/4, OF THE N.W. 1/4, OF SEC. 19,
T. 10 N., R. 15 W., LEE TOWNSHIP, ATHENS COUNTY, OHIO
for ARLENE B. DAVIS.

SURVEYED APR. 17, 1973 by HAROLD D. WHALEY

Harold D. Whaley

REG. SURV. NO. 4986