

Ernie needs copy of plat
 8.2977 ac. + divide then return to Ernie for approval

CHARLES R. SLOANE

Charles R. Sloane
 223-620


OWNER ?

OWNER ?

William Richard Phillips
 155-216 SCALE 1"=100'

8.2977
 TOTAL: 9.1528 ACRES

~~6.496~~ ac.
 5.6409

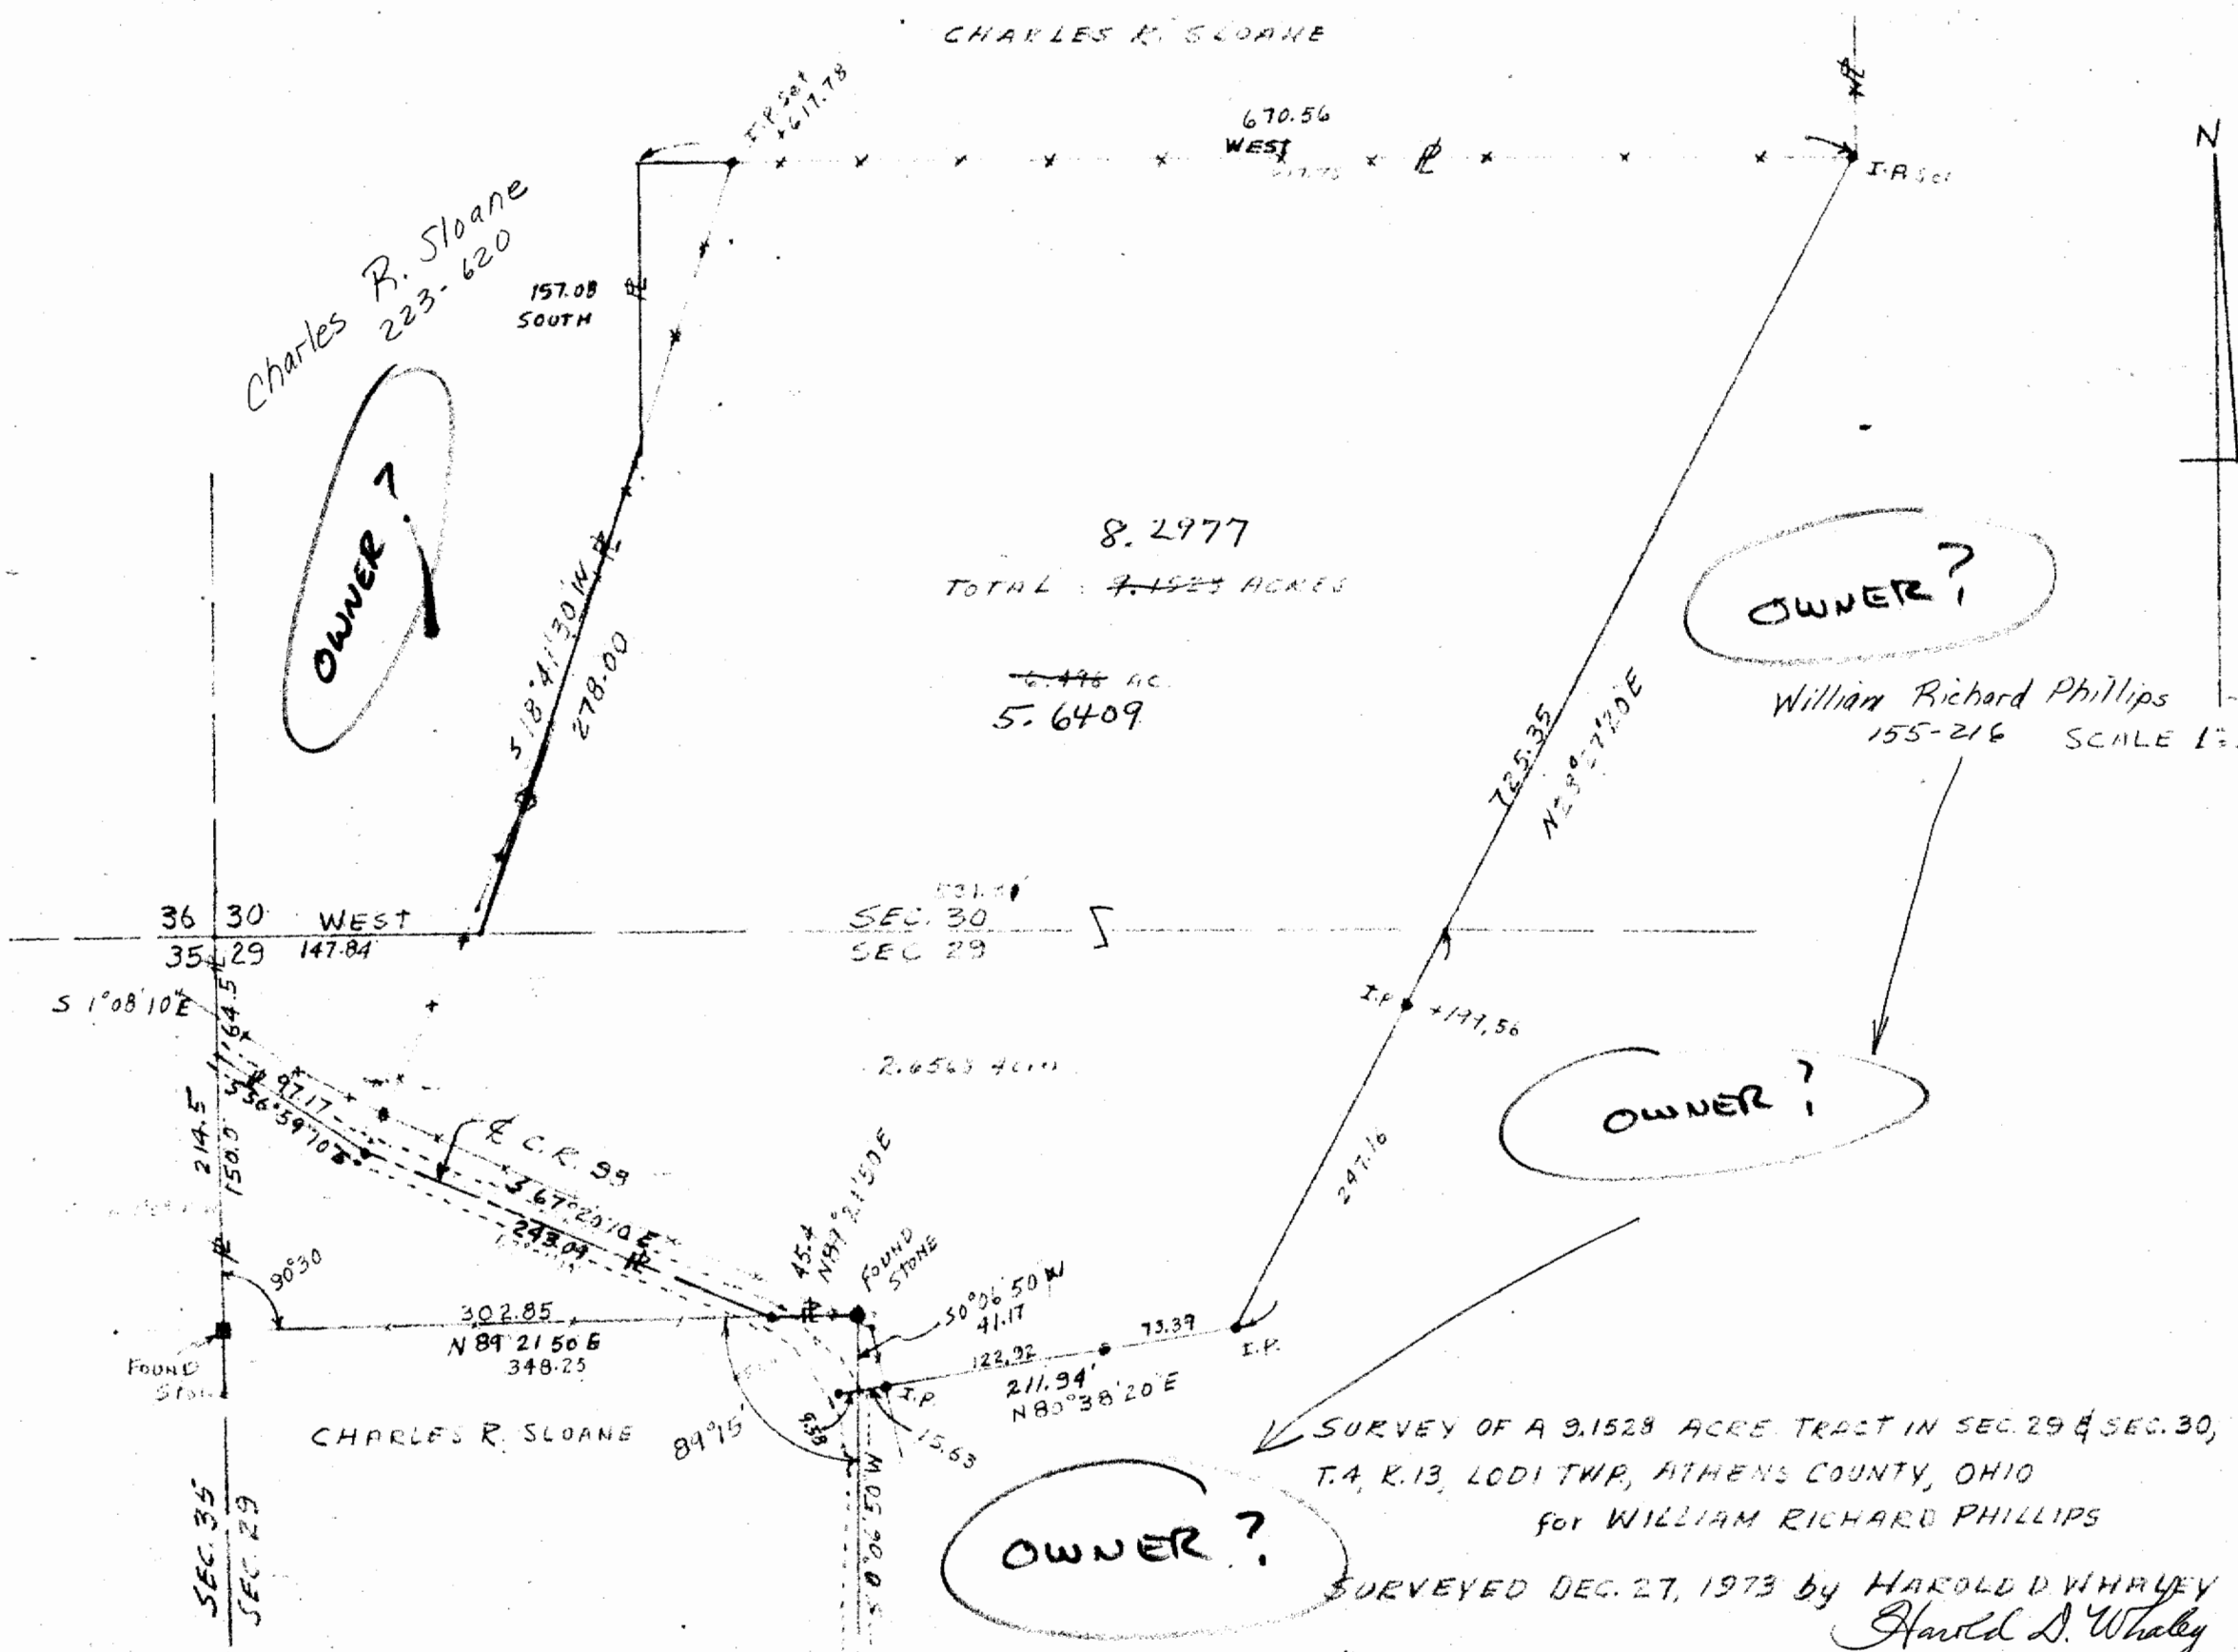

SURVEY OF A 9.1528 ACRE TRACT IN SEC. 29 & SEC. 30,
 T.4, R.13, LODI TWP, ATHENS COUNTY, OHIO
 for WILLIAM RICHARD PHILLIPS

SURVEYED DEC. 27, 1973 by HAROLD D. WHALEY
 Harold D. Whaley
 REG SURV. NO. 4986