


THOMAS C. TRANTINA
REGISTERED PROFESSIONAL LAND SURVEYOR

S.C.C.A. BLDG. 2380 OLD RT. 33 SHADE, OHIO 45766 740/696-1230

Southeastern Land Surveys

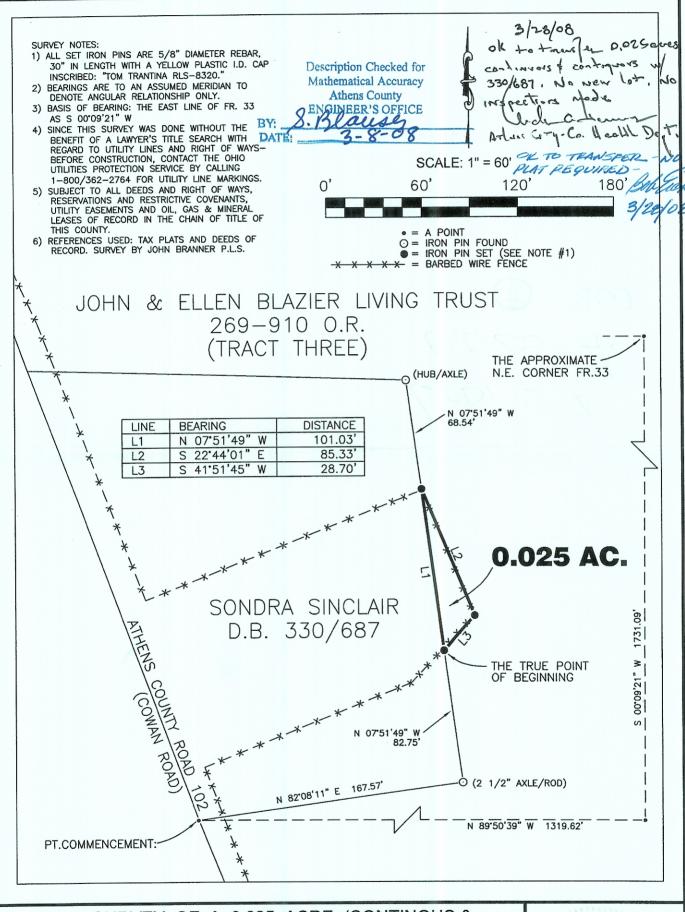

Plat of SURVEY OF A 0.025 ACRE (CONTINOUS & CONTIGUOUS TRANSFER) TRACT Scale: 1" = 60'
Surveyed for: MR. JUSTIN ROBINSON Date: 03/04/08
Subdivision FRACTION 33
Township LODI Section 27 Town 4 Range 13
Corporation - - County ATHENS Ohio
Thomas C. Trantina P.L.S. No. 8320