

1"=100'
○=IRON PIN

TRACIE E. COEN
64.06 AC
152/362


JOHN LURA SAVAGE
242/59

Description checked for
Mathematical Accuracy
ATHENS COUNTY
ENGINEER'S OFFICE

BY: *Charles Whitney*
DATE: *3-26-83*

J. DAVID & SHARON L.
STURBOIS
7.0 ACRE

COUNTY R. 125

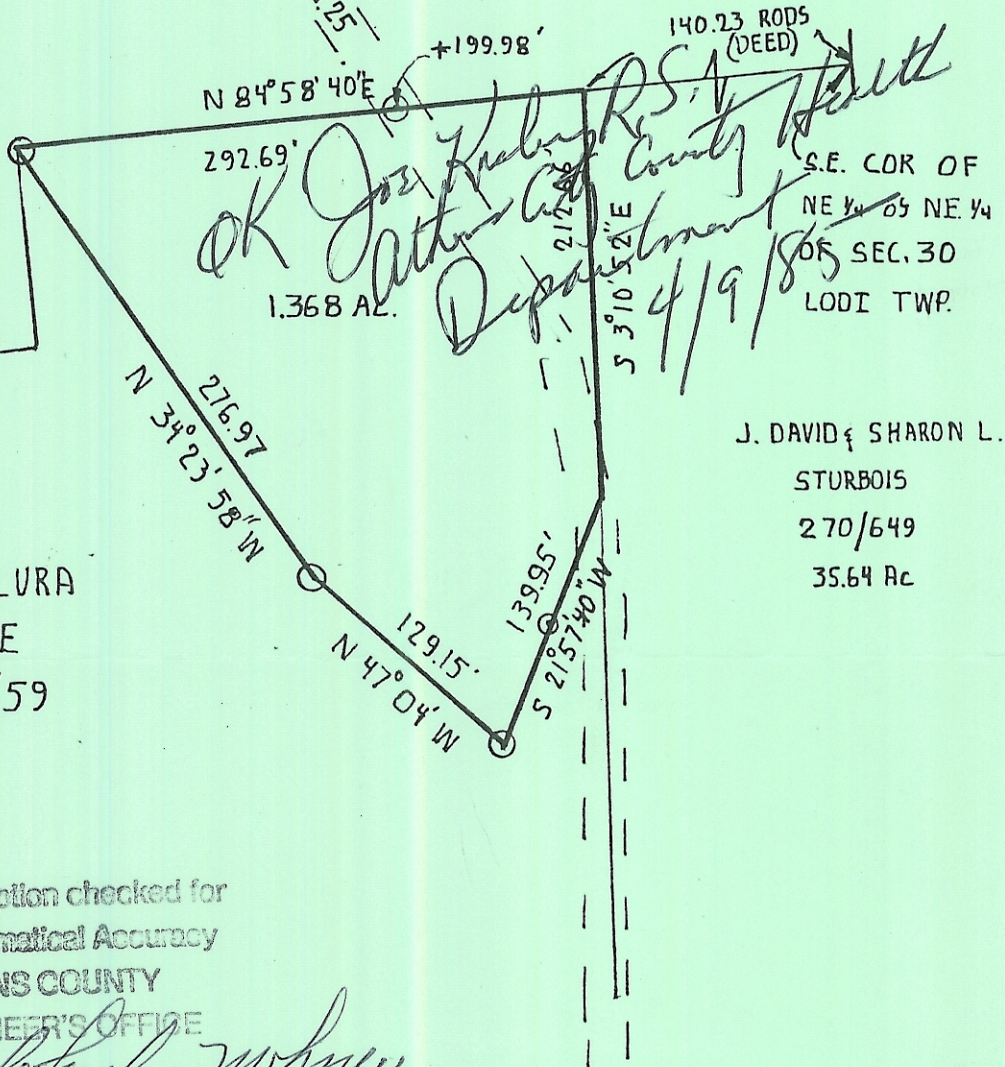

J. DAVID & SHARON L.
STURBOIS
270/649
35.64 AC

SURVEY OF A 1.368 ACRE TRACT IN
SECTION 30, T.4, R.13, LODI TWP.,
ATHENS COUNTY, OHIO
FOR J. DAVID STURBOIS (GRANTEE)
SURVEYED 3/83

John M. Branner
JOHN M. BRANNER - REG. SURVEYOR-6805

