


Plat and notes of a subdivision of out Lot
No. 11 in the Town of Nelsonville,
surveyed for Mr. W. Paston.

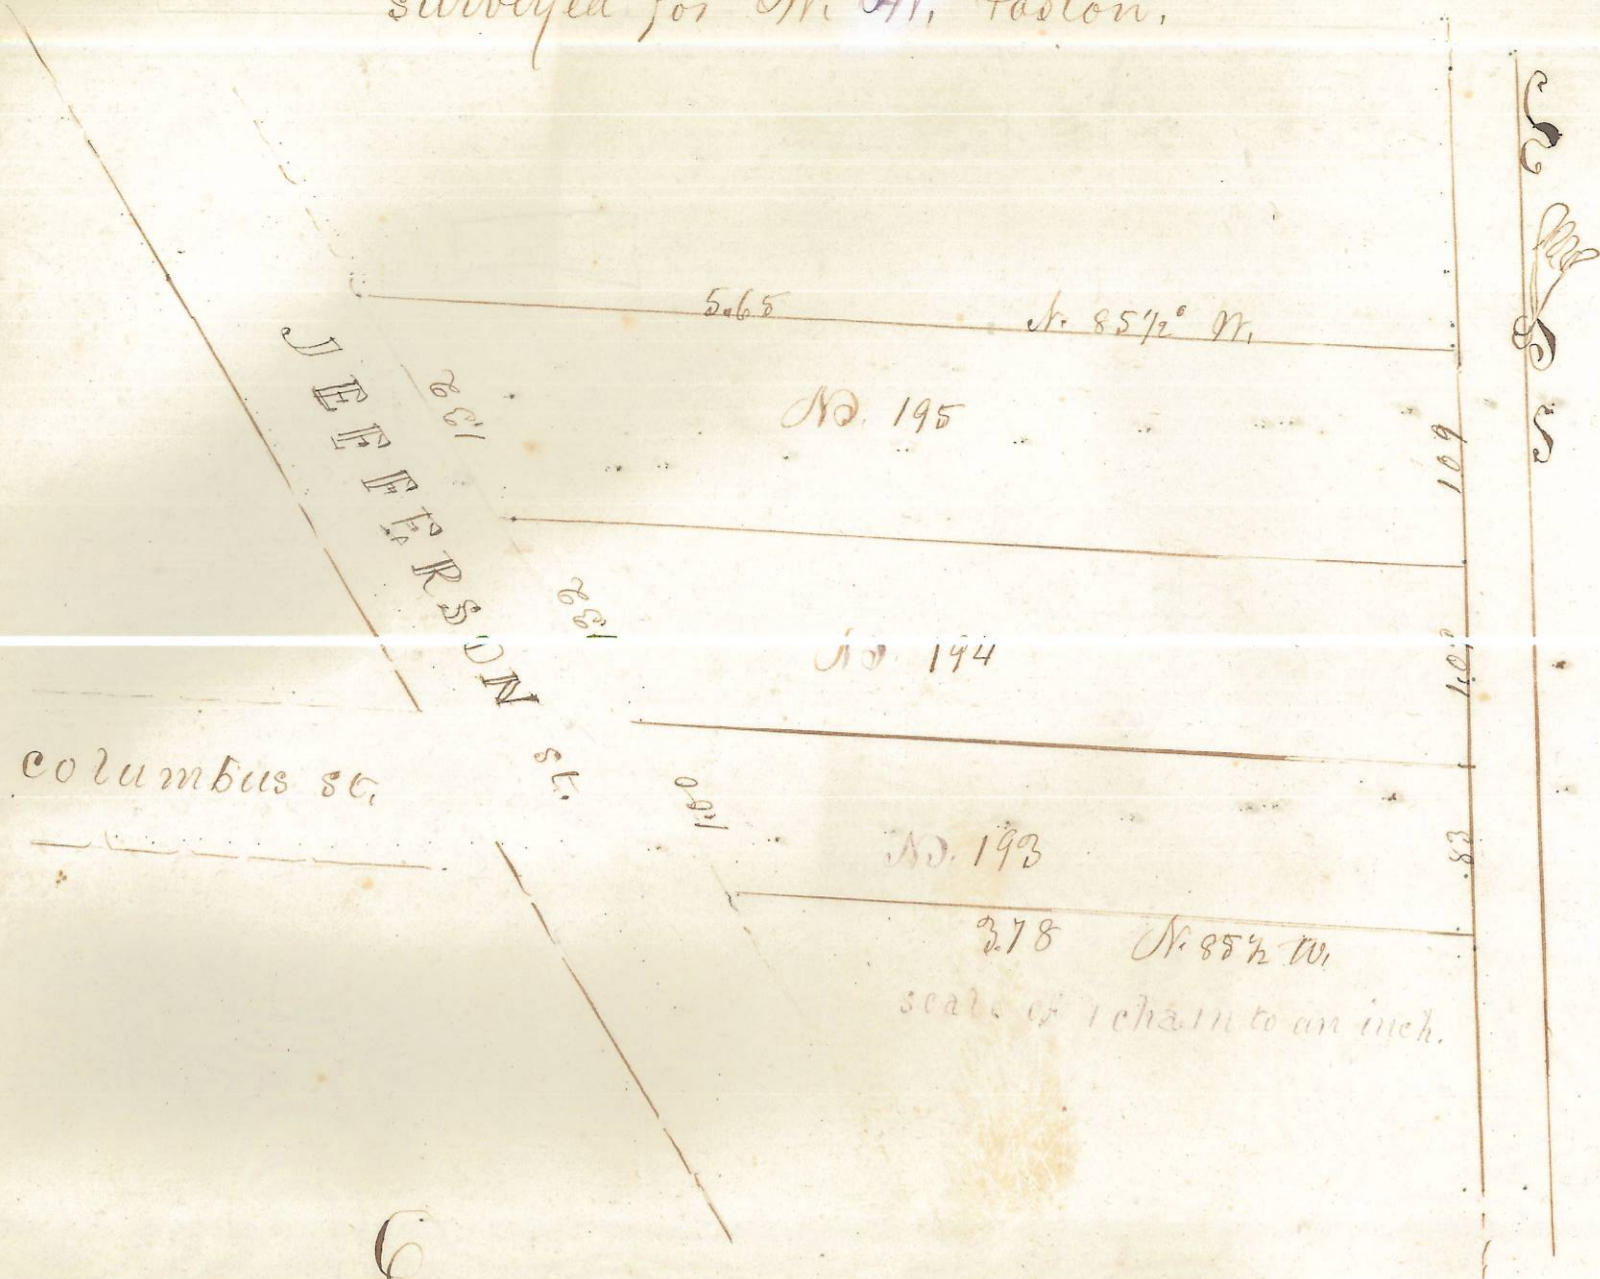

Surveyors office, Athens Co. O.
I hereby certify the above plat and
notes to be correct.

June 6th 1864, John Ackley, C. S.

Entered for Record, January 16th A. D. 1865, & Recorded February 2nd 1865,

Attest, Daniel Orphan, Recorder.

ENVELOPE: 81D
NELSONVILLE - OUTLOT 11
ADDITION to