




C. Thomas Smith
Ohio Professional Surveyor
P.O. Box 393
Racine, Ohio 45771
740-949-2524


Being a part of the Village of Stewart,
Fraction 30, Section 21,
T-6-N, R-12-W, Rome Township,
Athens County, State of Ohio.

Note: Bearings are assumed and are for
the determination of angles only.

All iron pins set are 5/8"X30" rebar with
plastic ID cap stamped "CTS-6844".

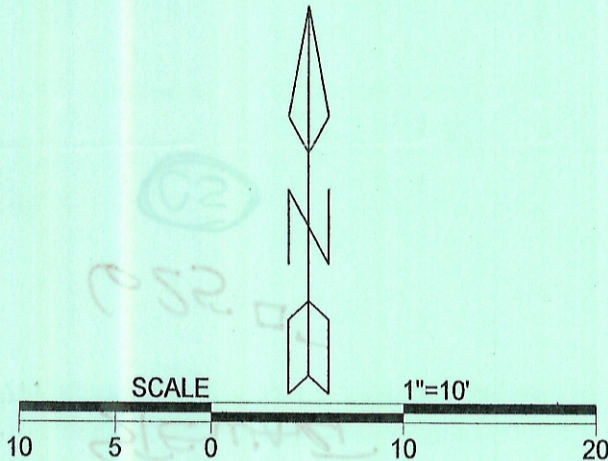

centerline Athens Avenue
Fairfax St. 40' R/W
Street name changed per conversation
with Rome Township Trustees.
Bob Eichenberg 5-30-06

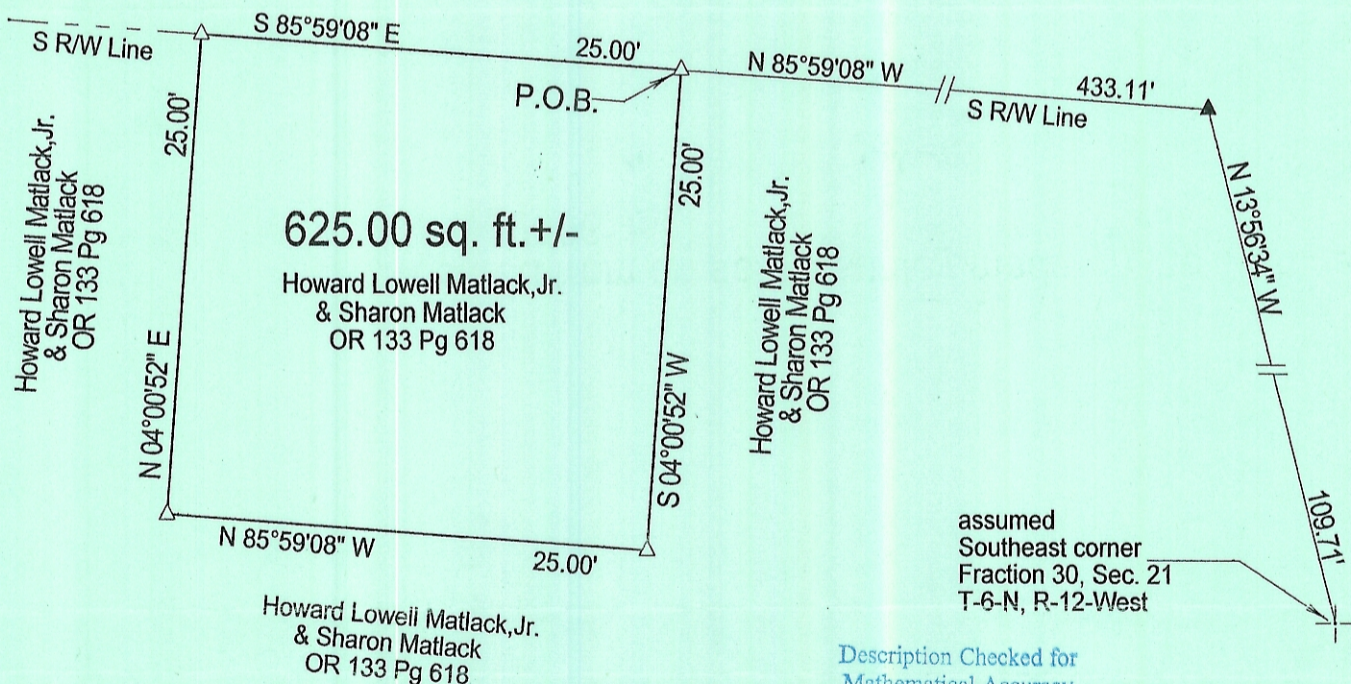

REFERENCES
Current Tax Plats
Previous surveys
Deeds: as noted

property for utility purposes
only - no Health Dept.
approval necessary - OK to transfer
Bob Eichenberg 5-30-06
BY: S. Blausch
DATE: 1-24-06

Plat prepared from an actual survey made on the 16th day
of January, 2006, by,

LEGEND

△	Iron pin set
▲	Iron pin found
•	Point

C. Thomas Smith

Ohio Professional Surveyor No. 6844