

DESCRIPTION OF A 1.001 ACRE TRACT

Situated in Section 7, T.6,R.12, Rome Township, Athens County, Ohio, and being a part of a tract of land described in Volume 369, Page 641, Athens County Deed Records and being more particularly described as follows:


Commencing at a stone found at the Northeast corner of the West one-half of the Southwest one-quarter of Section 7; thence, N 88°50'23" W, 132.00' to an iron pin, said pin being the point of beginning for the tract of land herein described:

Thence, along the West-line of a 4.441 acre tract, S 14°10'39"W, 251.80' to an iron pin set; thence, N 88°50'20" W, 178.99' to a fence corner at the Southeast corner of the existing cemetery; thence, along the East-line of said cemetery, N 14°39'30"E, 252.29' to a point on the North-line of Section 7, and the Northeast corner of said cemetery; thence, along said North-line S 88°50'23" E, 176.82' to an iron pin, said pin being the point of beginning and containing 1.001 acres.

Subject to all easements and rights of way of record.

Prepared by:

John M. Branner
JOHN M. BRANNER
REGISTERED SURVEYOR-6805

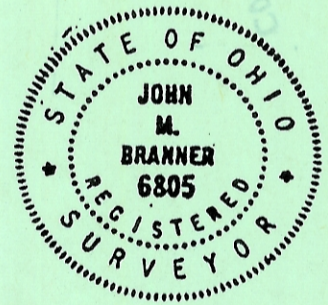

Description checked for
Mathematical Accuracy
ATHENS COUNTY
ENGINEERS OFFICE

BY: *Charles M. Jones*
DATE: 7-20-83

SCALE: 1"=100'
IRON PIN SET
IRON PIN FOUND

1.001 AC
Rome 7
SM

PREPARED BY:
BRANNER SURVEYING
R12 ATHENS OHIO
CIN. 292 2770
John M. Branner
JOHN M. BRANNER
REG. SURVEYOR-6805


SURVEYED JUNE 1983
FOR ROME TWP. TRUSTEES
TOWNSHIP, ATHENS CO., OHIO
IN SECTION 7, T.6, R.12, ROME
SURVEY OF A 1.001 AC. TRACT

DESCRIPTION OF A 1.001 ACRE TRACT

Situated in Section 7, T.6, R.12, Rome Township, Athens County, Ohio, and being a part of a tract of land described in Volume 369, Page 641, Athens County Deed Records and being more particularly described as follows:

ROBERT BUCK

361/621 38.99 Ac

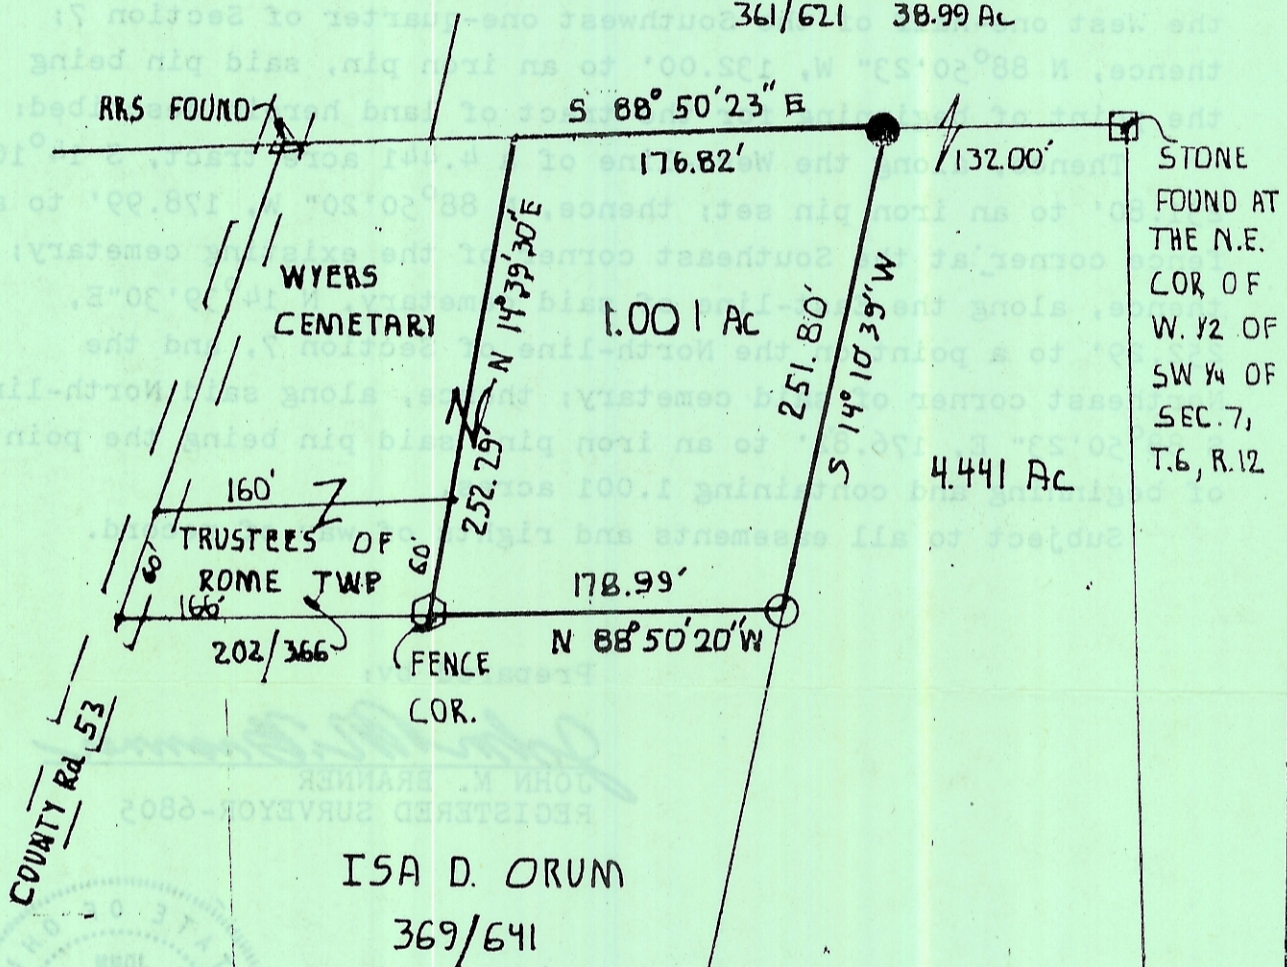

SCALE: 1"=100'

○: IRON PIN SET

●: IRON PIN FOUND

SURVEY OF A 1.001 AC. TRACT
 IN SECTION 7, T6, R 12, ROME
 TOWNSHIP, ATHENS Co., OHIO
 FOR ROME TWP. TRUSTEES
 SURVEYED JUNE 1983

PREPARED BY:
 BRANNER SURVEYING
 R+3 ATHENS OHIO
 614-592 5770

John M. Branner
 JOHN M. BRANNER
 REG. SURVEYOR-6805

