


ENVELOPE: 126B

SUGAR ORCHARD ADDITION
NELSONVILLE

"Sugar Orchard" Addition to the Village of Nelsonville, Athens County, Ohio.

Surveyed June 20 & 21, 1886. Scale 80 ft = 1 inch. Bearings magnetic of 1885. I certify the above plat and notes to be correct measurement in feet & lengths of feet.
W. E. Peters, Surveyor of Athens County Ohio.

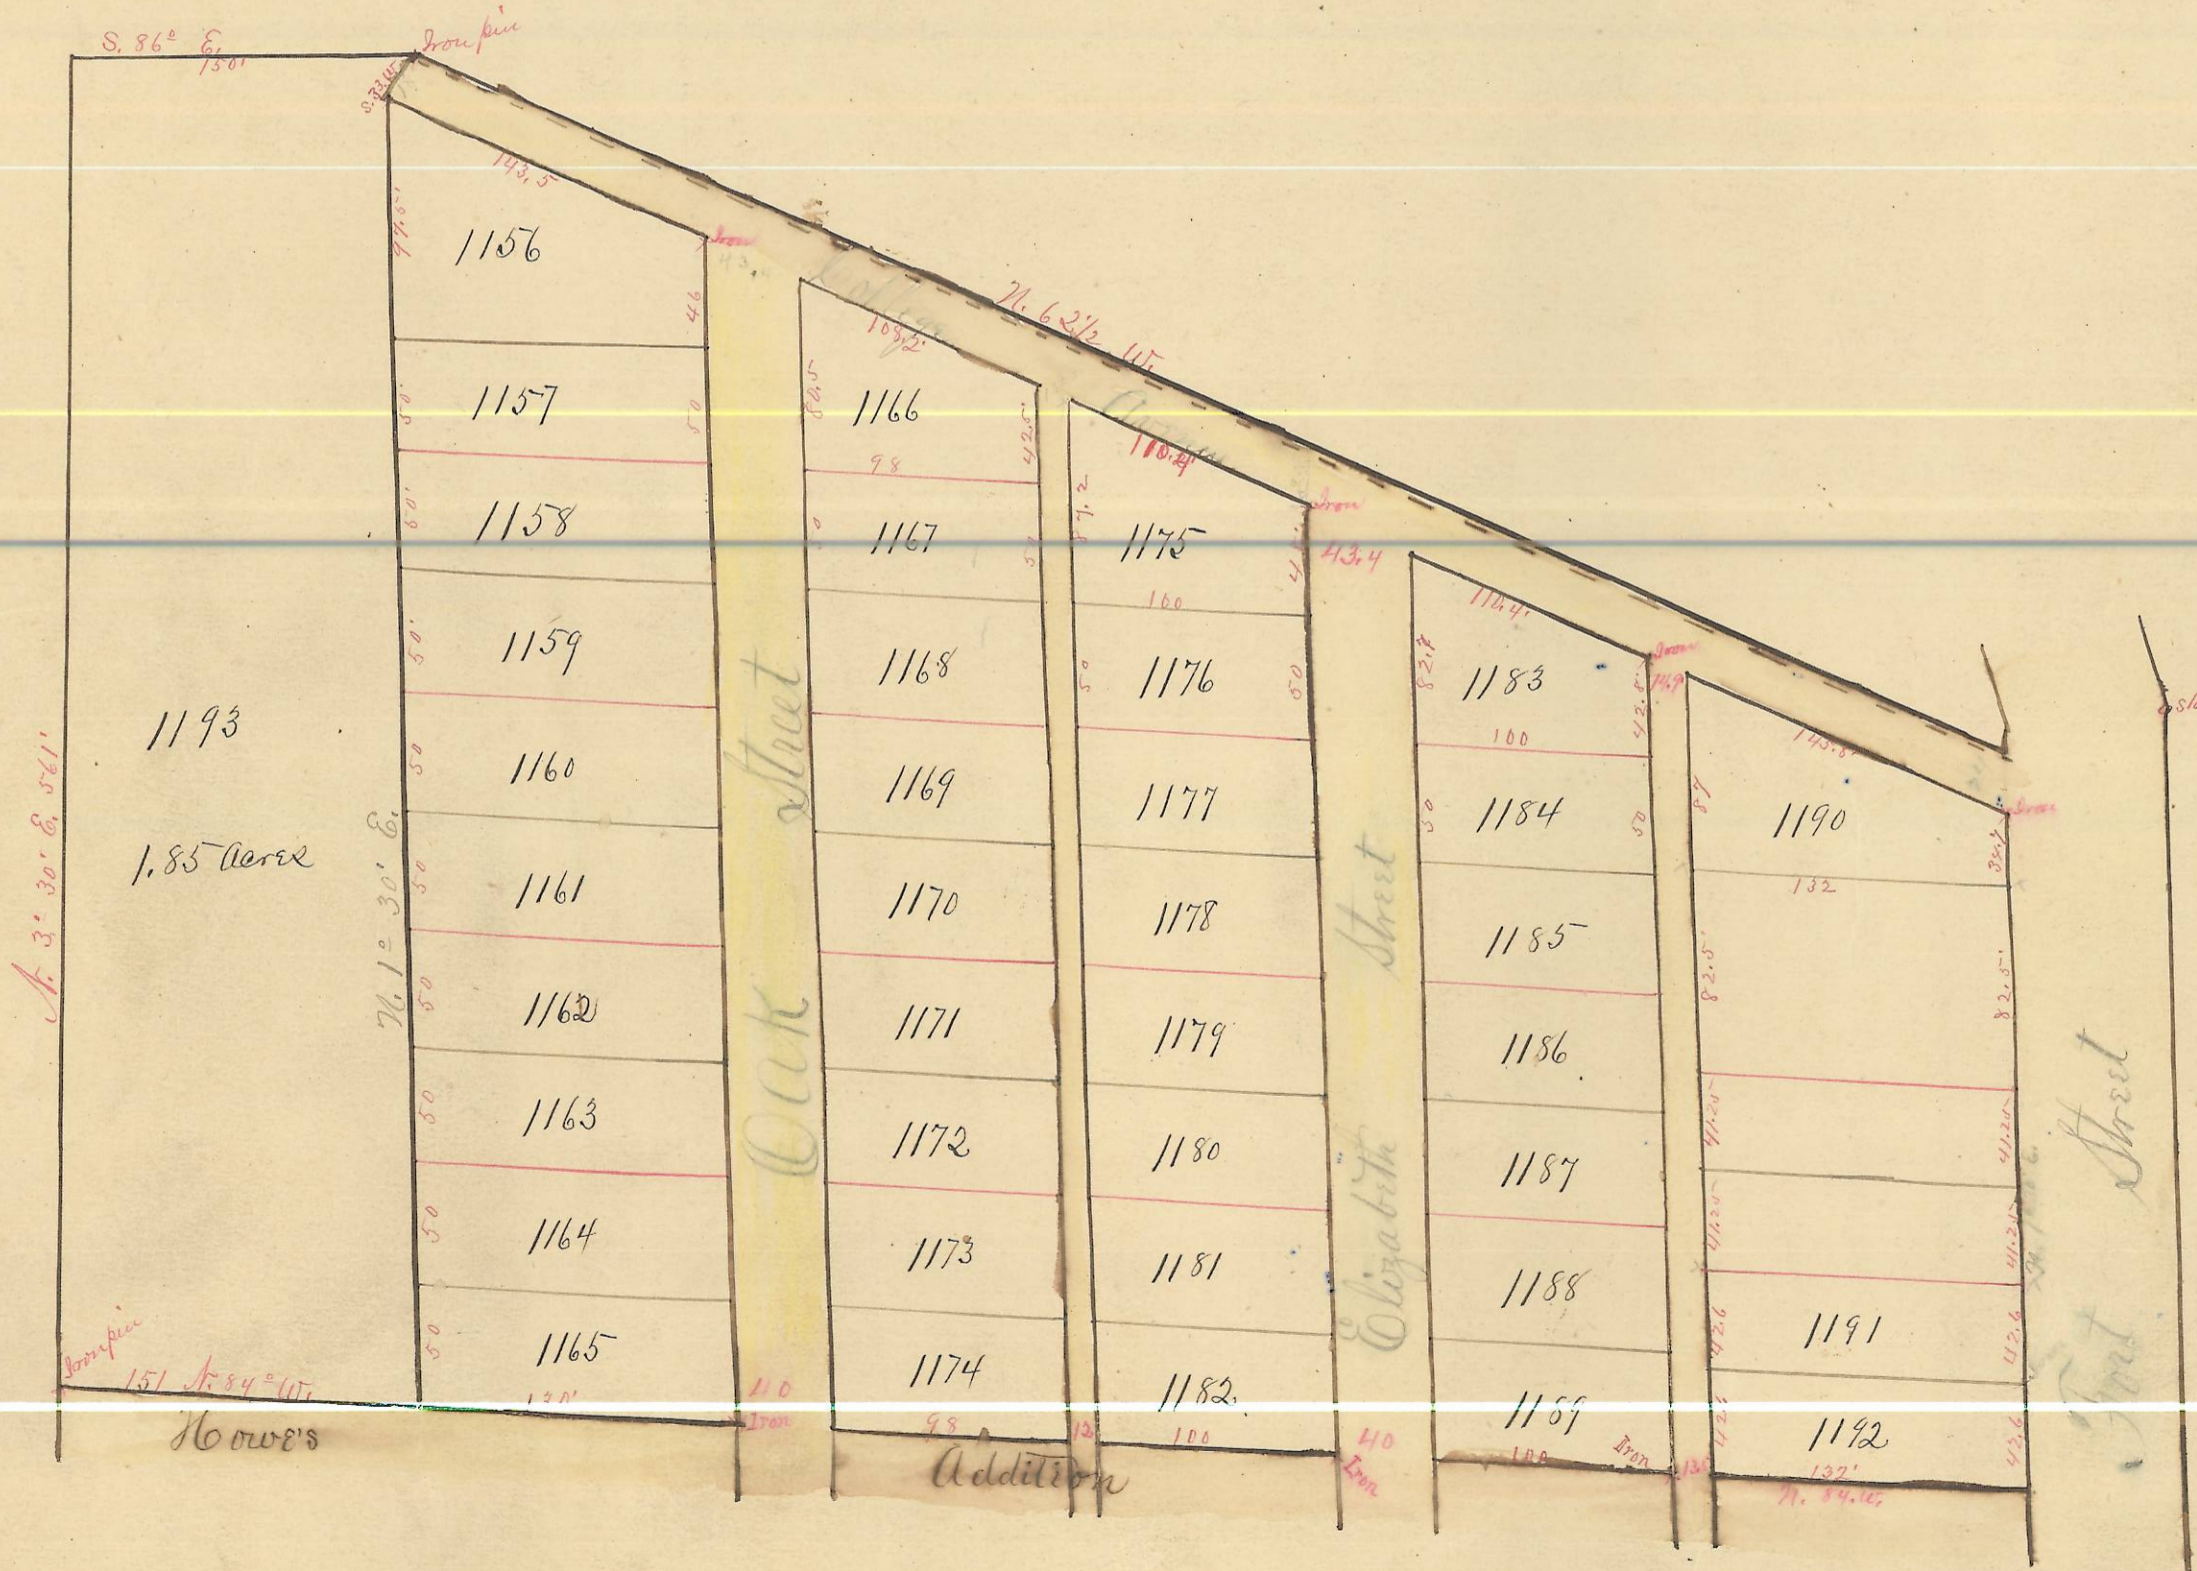

Know all men by these presents, that we H. P. Shepard & F. S. Coultrap as President and Clerk of the Board of Education of Nelsonville Athens County Ohio, and S. W. Poston owner of four (4) feet along the North side and within College Street, do as proprietors of said tract acknowledge the within plat to be a correct plat subdivision of the above tract for the uses and purposes therein shown. In Witness Whereof we have hereunto set our hands this 7th day of July, 1888

*H. P. Shepard, President
F. S. Coultrap, Clerk of said Board of Education
S. W. Poston.*

State of Ohio, Athens Counties, Be it Remembered that on this 7th day of July 1888 before me the subscriber, a Notary Public, personally came the above named H. P. Shepard, F. S. Coultrap and S. W. Poston the grantors in the foregoing plat and acknowledged the signing and sealing of the same to be their voluntary act and deed for the uses and purposes therein shown. In Testimony Whereof I have hereunto subscribed my name and affixed my Notarial seal on the day and year last aforesaid

no seal

*W. L. Keckman
Notary Public*

*Entered for record July 9th and Recorded July 10th 1888
Attest L. H. Covert Recorder*