

of a 223.81 ACRE TRACT RECORDED IN VOLUME 261 PAGE 641
OF THE ATHENS COUNTY RECORDER'S OFFICE RECORDED
DEEDS.


SITUATED IN TOWN 11, RANGE 14, SECTION 13
TRIMBLE TOWNSHIP ATHENS COUNTY, OHIO
AND BEING MORE PARTICULARLY DESCRIBED
AS FOLLOWS TO WIT:

COMMENCING AT THE SOUTHWEST CORNER
OF LOT 115, REDTOWN; THENCE ~~DATA~~
~~TO~~ WEST 100.0 FEET TO AN IRON
PIN IN THE CENTER OF TINKERS RUN
AND ~~500.0 SOUTH 10° 00' EAST 500.0 FEET~~
~~TO AN IRON PIN~~ NORTH OF
AN ~~ABANDONED~~ ABANDONED RAILROAD SPUR
AND THE TRUE POINT OF BEGINNING
OF THE HEREIN DESCRIBED TRACT;

THENCE ~~TO~~ ~~TO~~ EAST, 50.0
FEET TO THE WEST RIGHT-OF-WAY
LINE OF AN UNNAMED PLATTED STREET;
THENCE NORTH 10° 00' EAST, 500.0 FEET
TO AN IRON PIN;
THENCE WEST 75.00 FEET TO AN
IRON PIN;
THENCE SOUTH 17° 00' WEST, 420.00
FEET;
THENCE SOUTH 70° 22' EAST, 64.74 FEET,
THENCE SOUTH 69.00 FEET TO THE
POINT OF BEGINNING AND CONTAINING
0.988 ACRES AND BEING PART ~~OF~~ (53)

SE 1/4 T 11 N

ZEDTOWN
SE Q of SE Q
SEC 13
T-11, R14

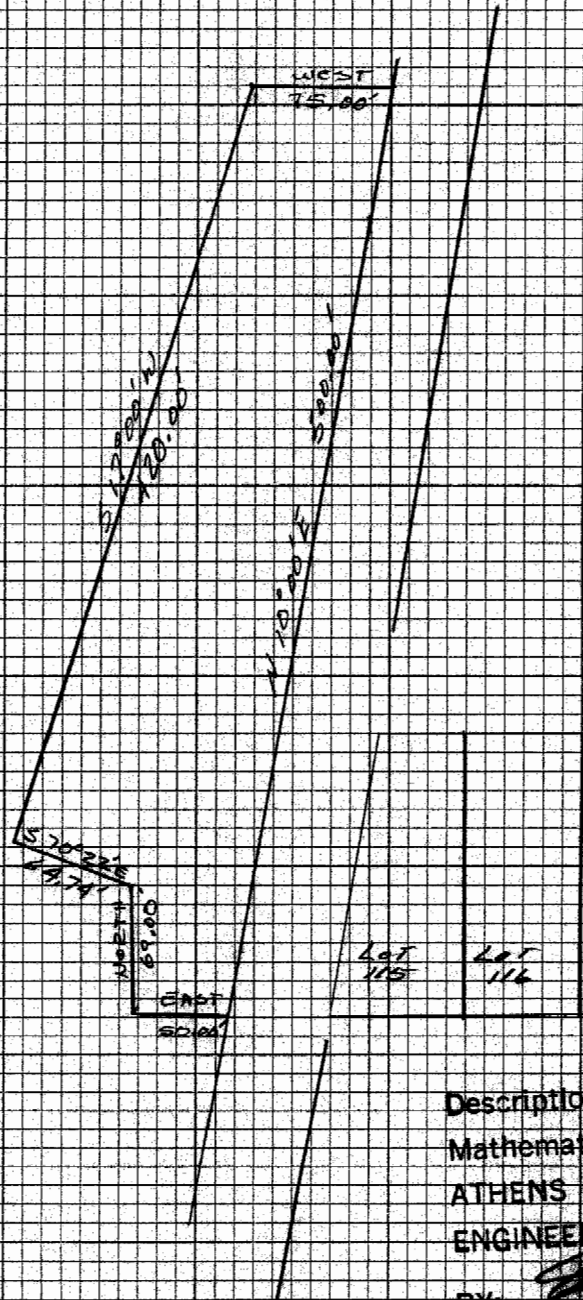

Description checked for
 Mathematical Accuracy
 ATHENS COUNTY
 ENGINEER'S OFFICE

BY: *[Signature]*
 DATE: *11-25-74*

54