

*Paul  
Tenor*

DESCRIPTION 32.458 ACRES & 44.820 ACRES

HOWARD AND CATHERINE ANTLE PROPERTY

VOLUME 297, PAGE 230

Situated in the Township of Trimble, County of Athens, State of Ohio and being a part of Fraction 36 in Section 15, Town 11, Range 14 more particularly described as follows:

Tract No. 1: Beginning at an iron pin in the north line of Fraction 36, said iron pin being north  $83^{\circ}25'32''$  west 986.09 feet from the northeast corner of Fraction 36; thence south  $5^{\circ}49'53''$  west 1985.08 feet to an iron pin; thence south  $42^{\circ}29'28''$  west 23.00 feet to an iron pin; thence north  $84^{\circ}00'32''$  west 537.22 feet to an iron pin; thence north  $2^{\circ}50'40''$  west 2036.47 feet to an iron pin in the north line of Fraction 36; thence south  $83^{\circ}25'32''$  east along the north line of the Fraction 858.21 feet to the place of beginning and containing 32.458 acres.

Tract No. 2: Beginning at the northeast corner of Fraction 36; thence south  $5^{\circ}49'50''$  west 1975.04 feet to an 18" wild cherry tree; thence north  $84^{\circ}00'32''$  west 986.04 feet to an iron pin; thence north  $5^{\circ}49'53''$  east 1985.08 feet to an iron pin in the north line of Fraction 36; thence south  $83^{\circ}25'32''$  east along the north line of the Fraction, 986.09 feet to the place of beginning and containing 44.820 acres.

The above described tracts are subject to all legal rights of way and easements of record.

Prepared by:

*William M. Watkins*

Registered Surveyor #S5216

Description checked for

Mathematical Accuracy


ATHENS COUNTY

ENGINEER'S OFFICE

By *Philip Ellback*  
for *Clas. Mohney*

DATE: Mar. 5, 1981

*Trimble Twp., Ohio, Pg. 40*

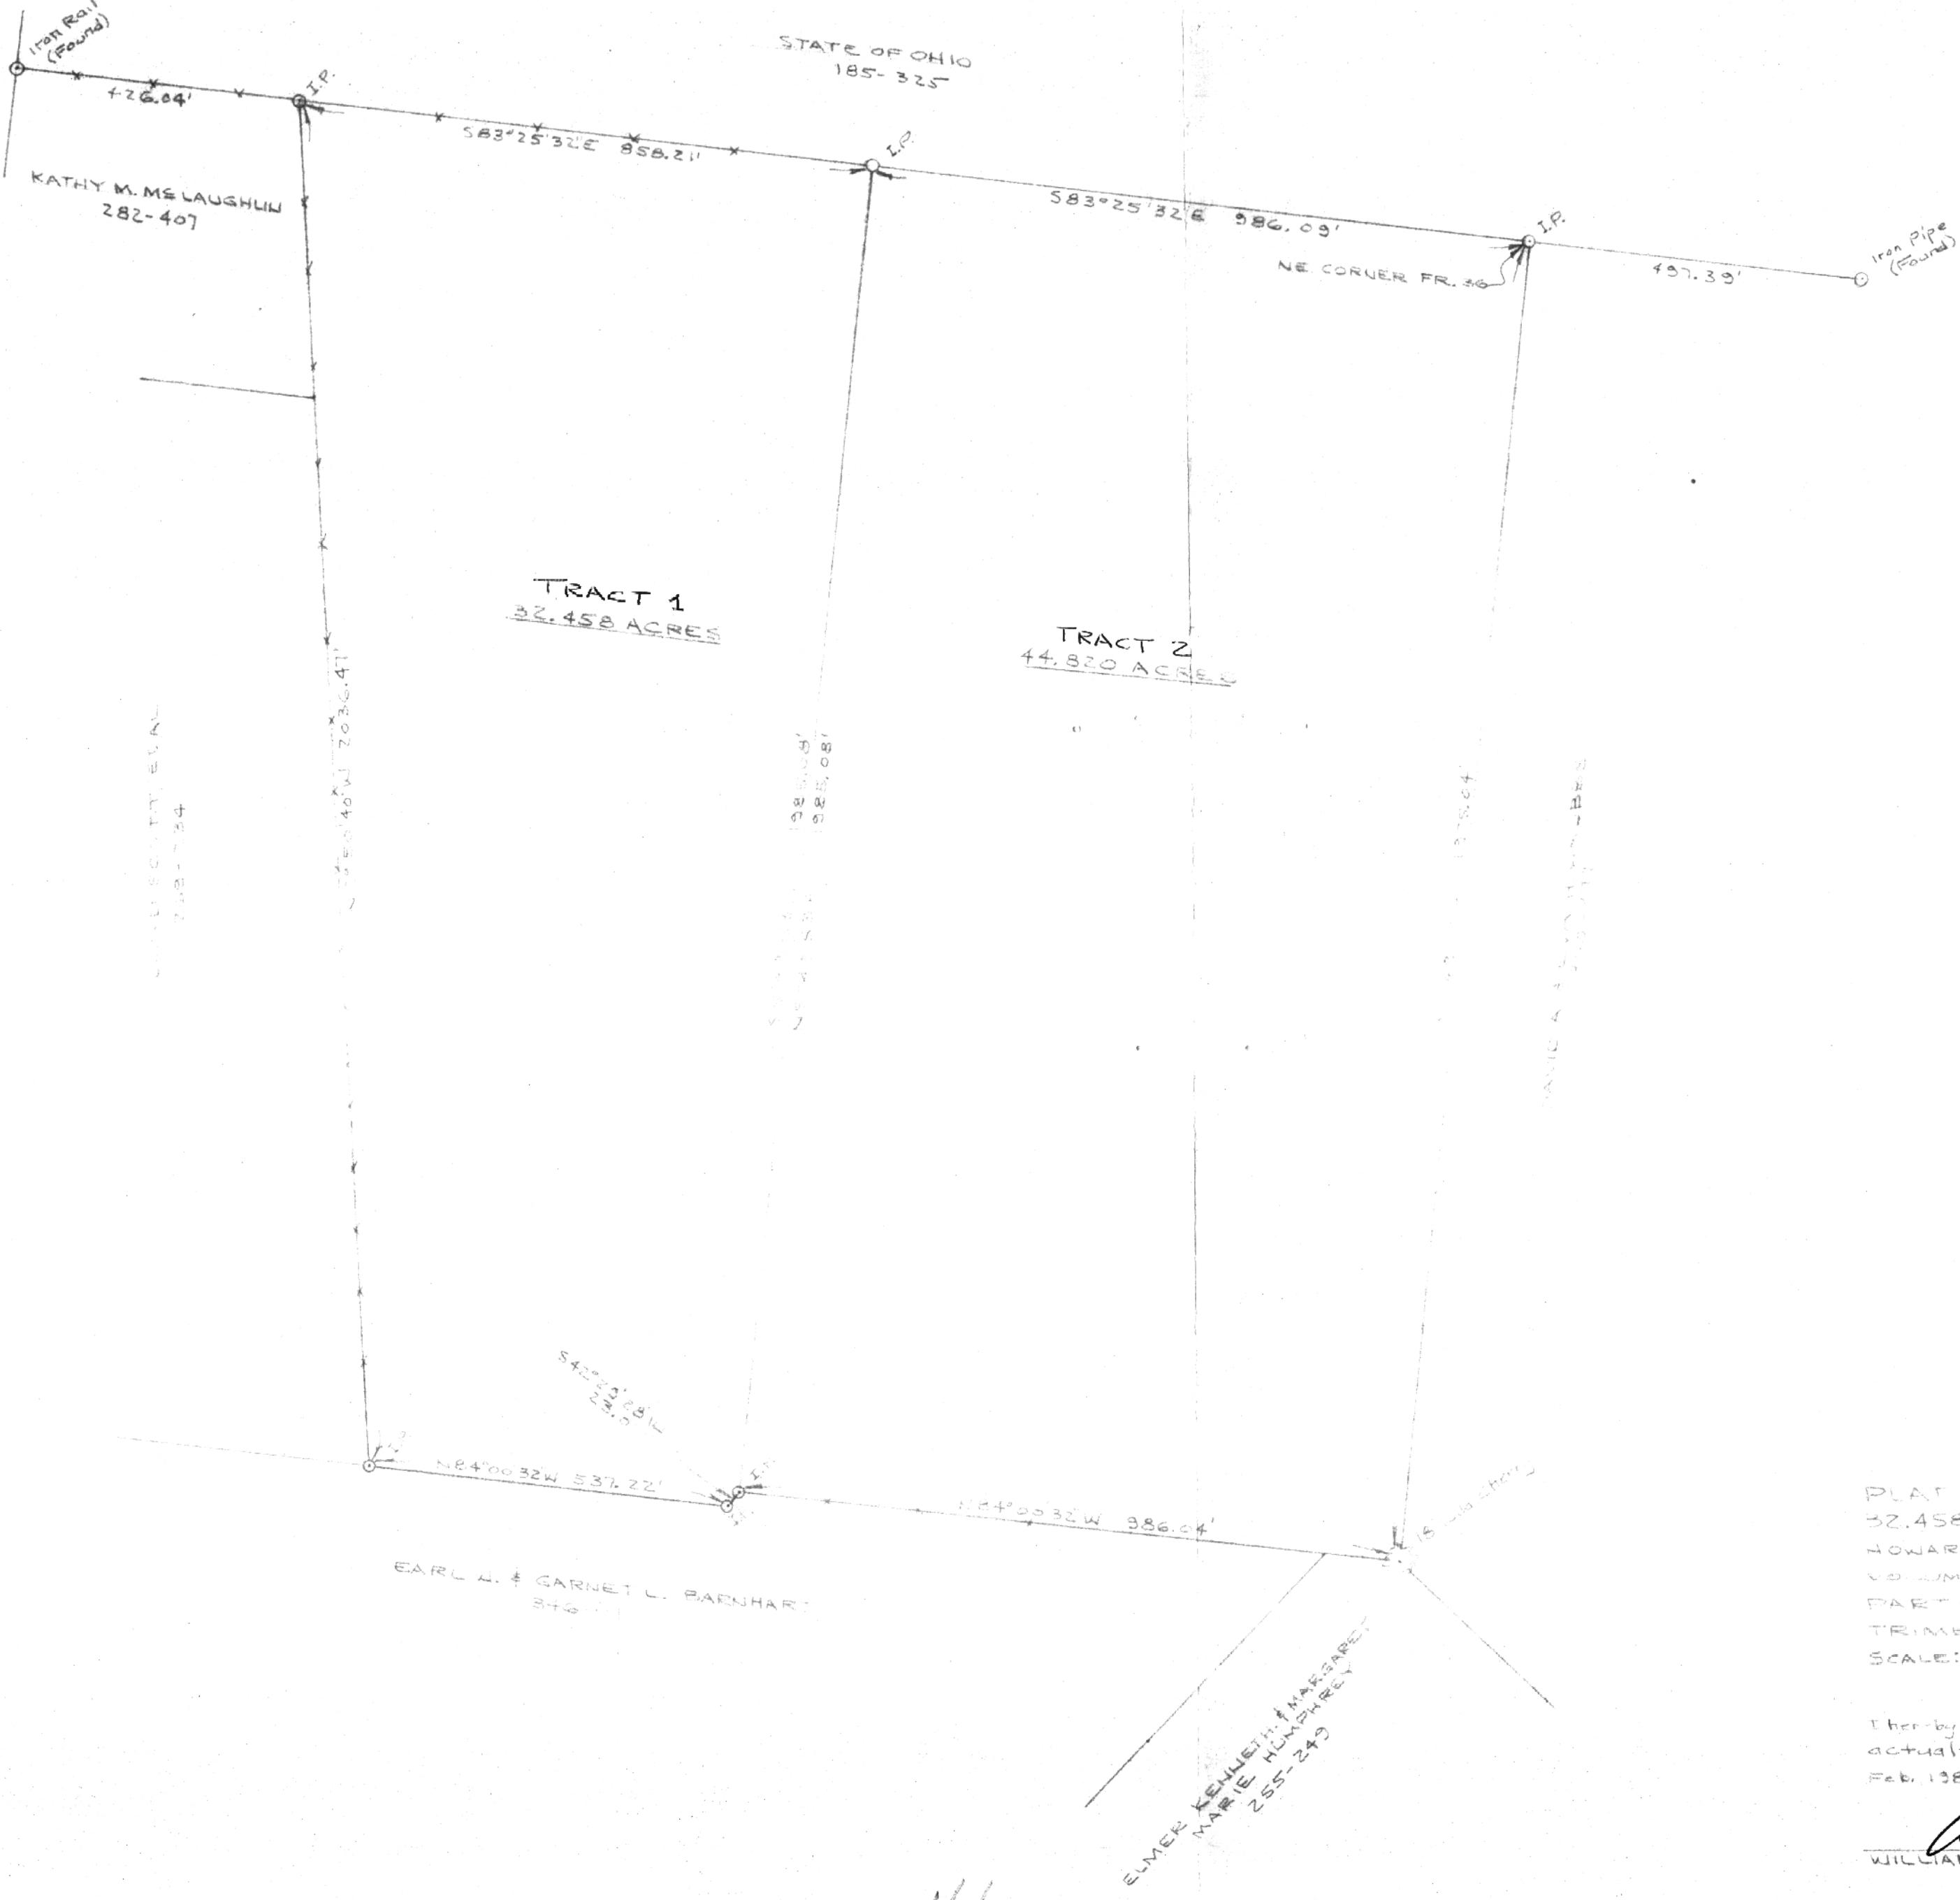

PLAT OF SURVEY OF 2 TRACTS  
32.458 ACRES & 44.820 ACRES  
HOWARD & CATHERINE ANTLE PROPERTY  
VOLUME 207, PAGE 230  
PART OF FROG, SECTION 15, TOWN 11, RANGE 14  
TRIMBLE TWP, ATHENS CO, OHIO  
SCALE: 1" = 200'  
SURVEYED-FEB. 5, 7, 8, 10, 1981

I hereby certify that this plat was prepared from an actual survey of the premises made by me in Feb. 1981.

*William M. Watkins*  
WILLIAM M. WATKINS, REG. SURVEYOR #45-5216

42