




WALNUT ST

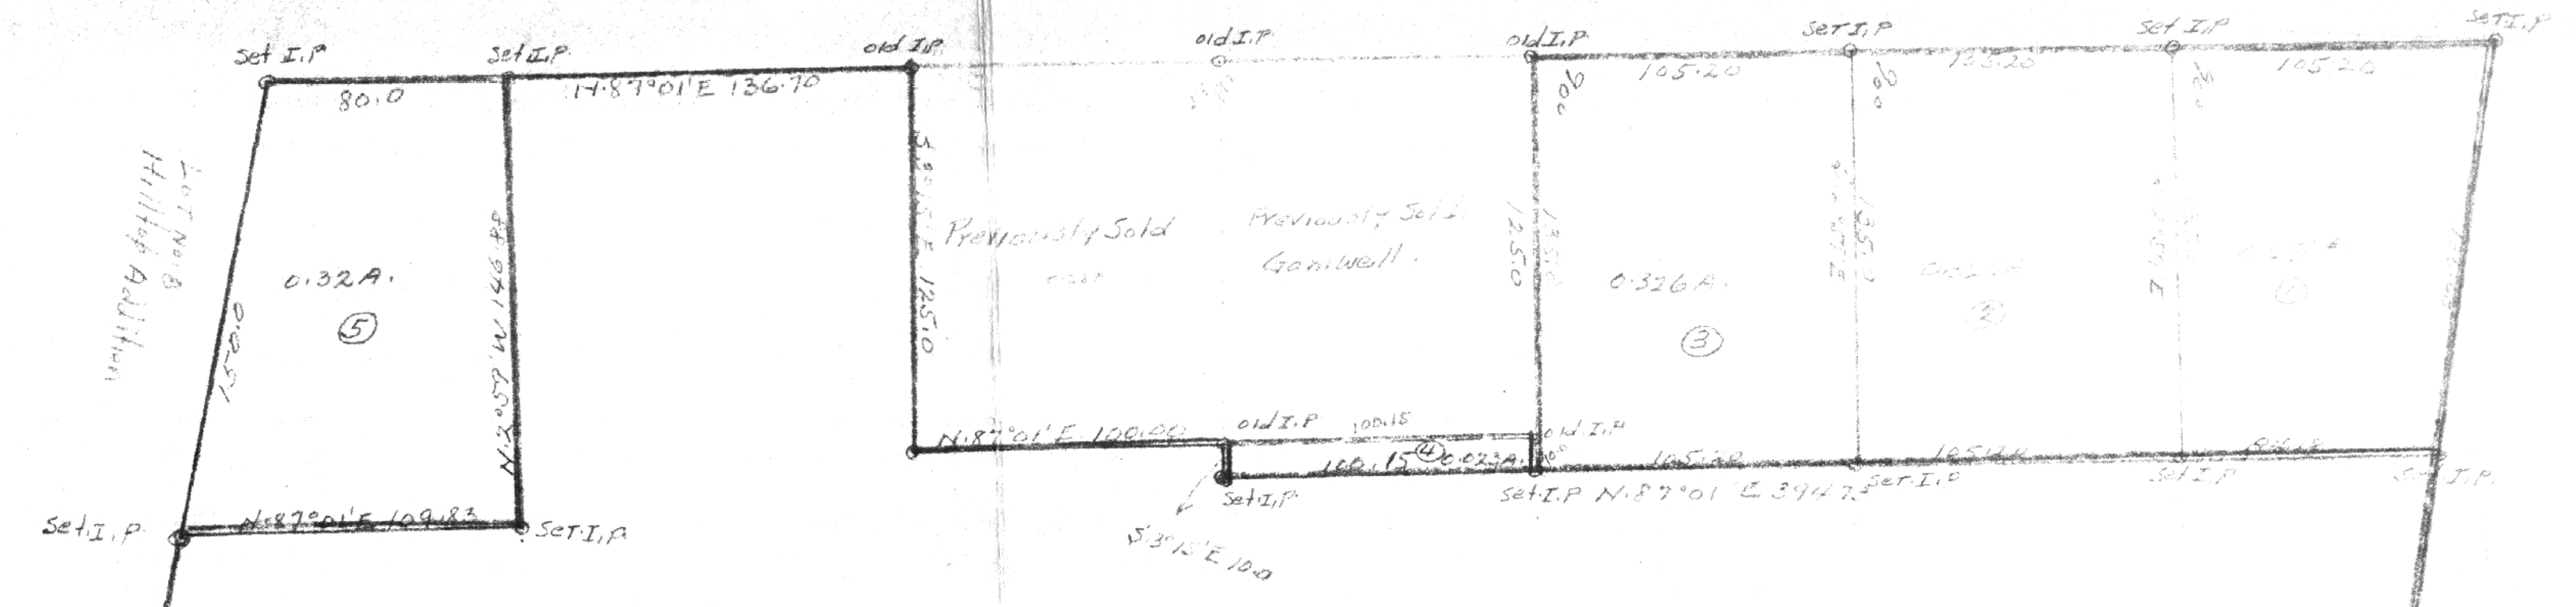

4

James E. & Willis E. Blower.
13.132A.

LAND OF JAMES E. & WILLIS E. BLOWER.
 LOCATED IN R.R. 3, TRIMBLE TWP, ATHENS CO.
 Sec 9
 SCALE 1" = 50'
 H. J. DUSZ, 2367 SURVEYOR
 NOVEMBER, 1965

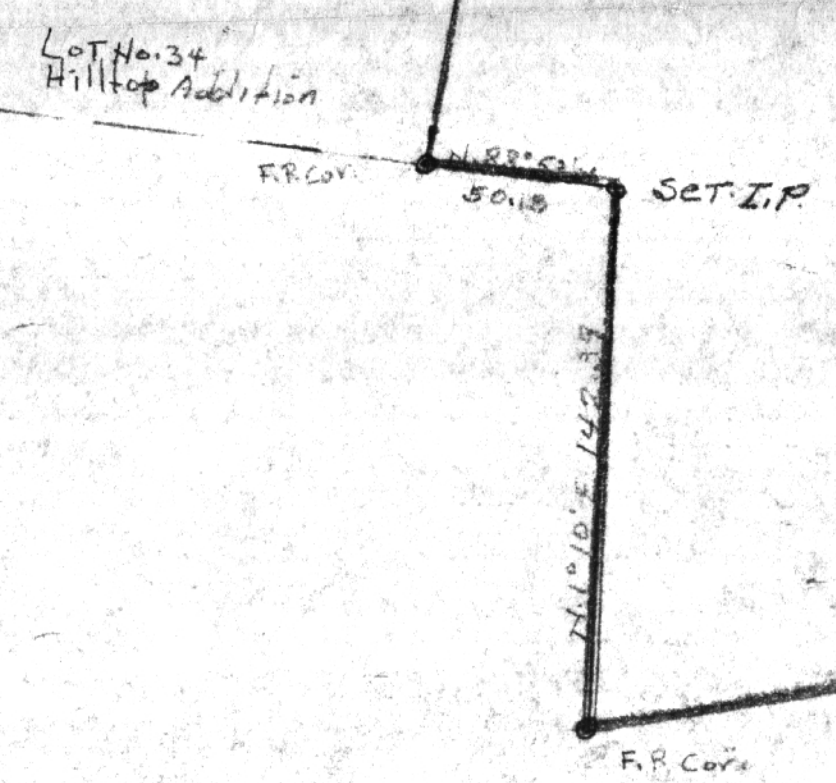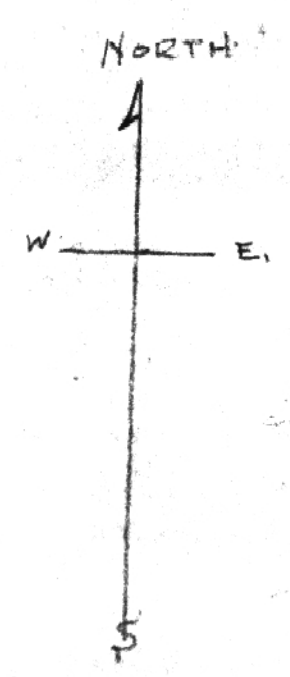

5

7